CITY TITLE CO. Order No. E-843-4

Daniel A. & Veronica Brattoli and Wayne M. & Esther J. Sooy
to Herman & Gloria H. Thompson

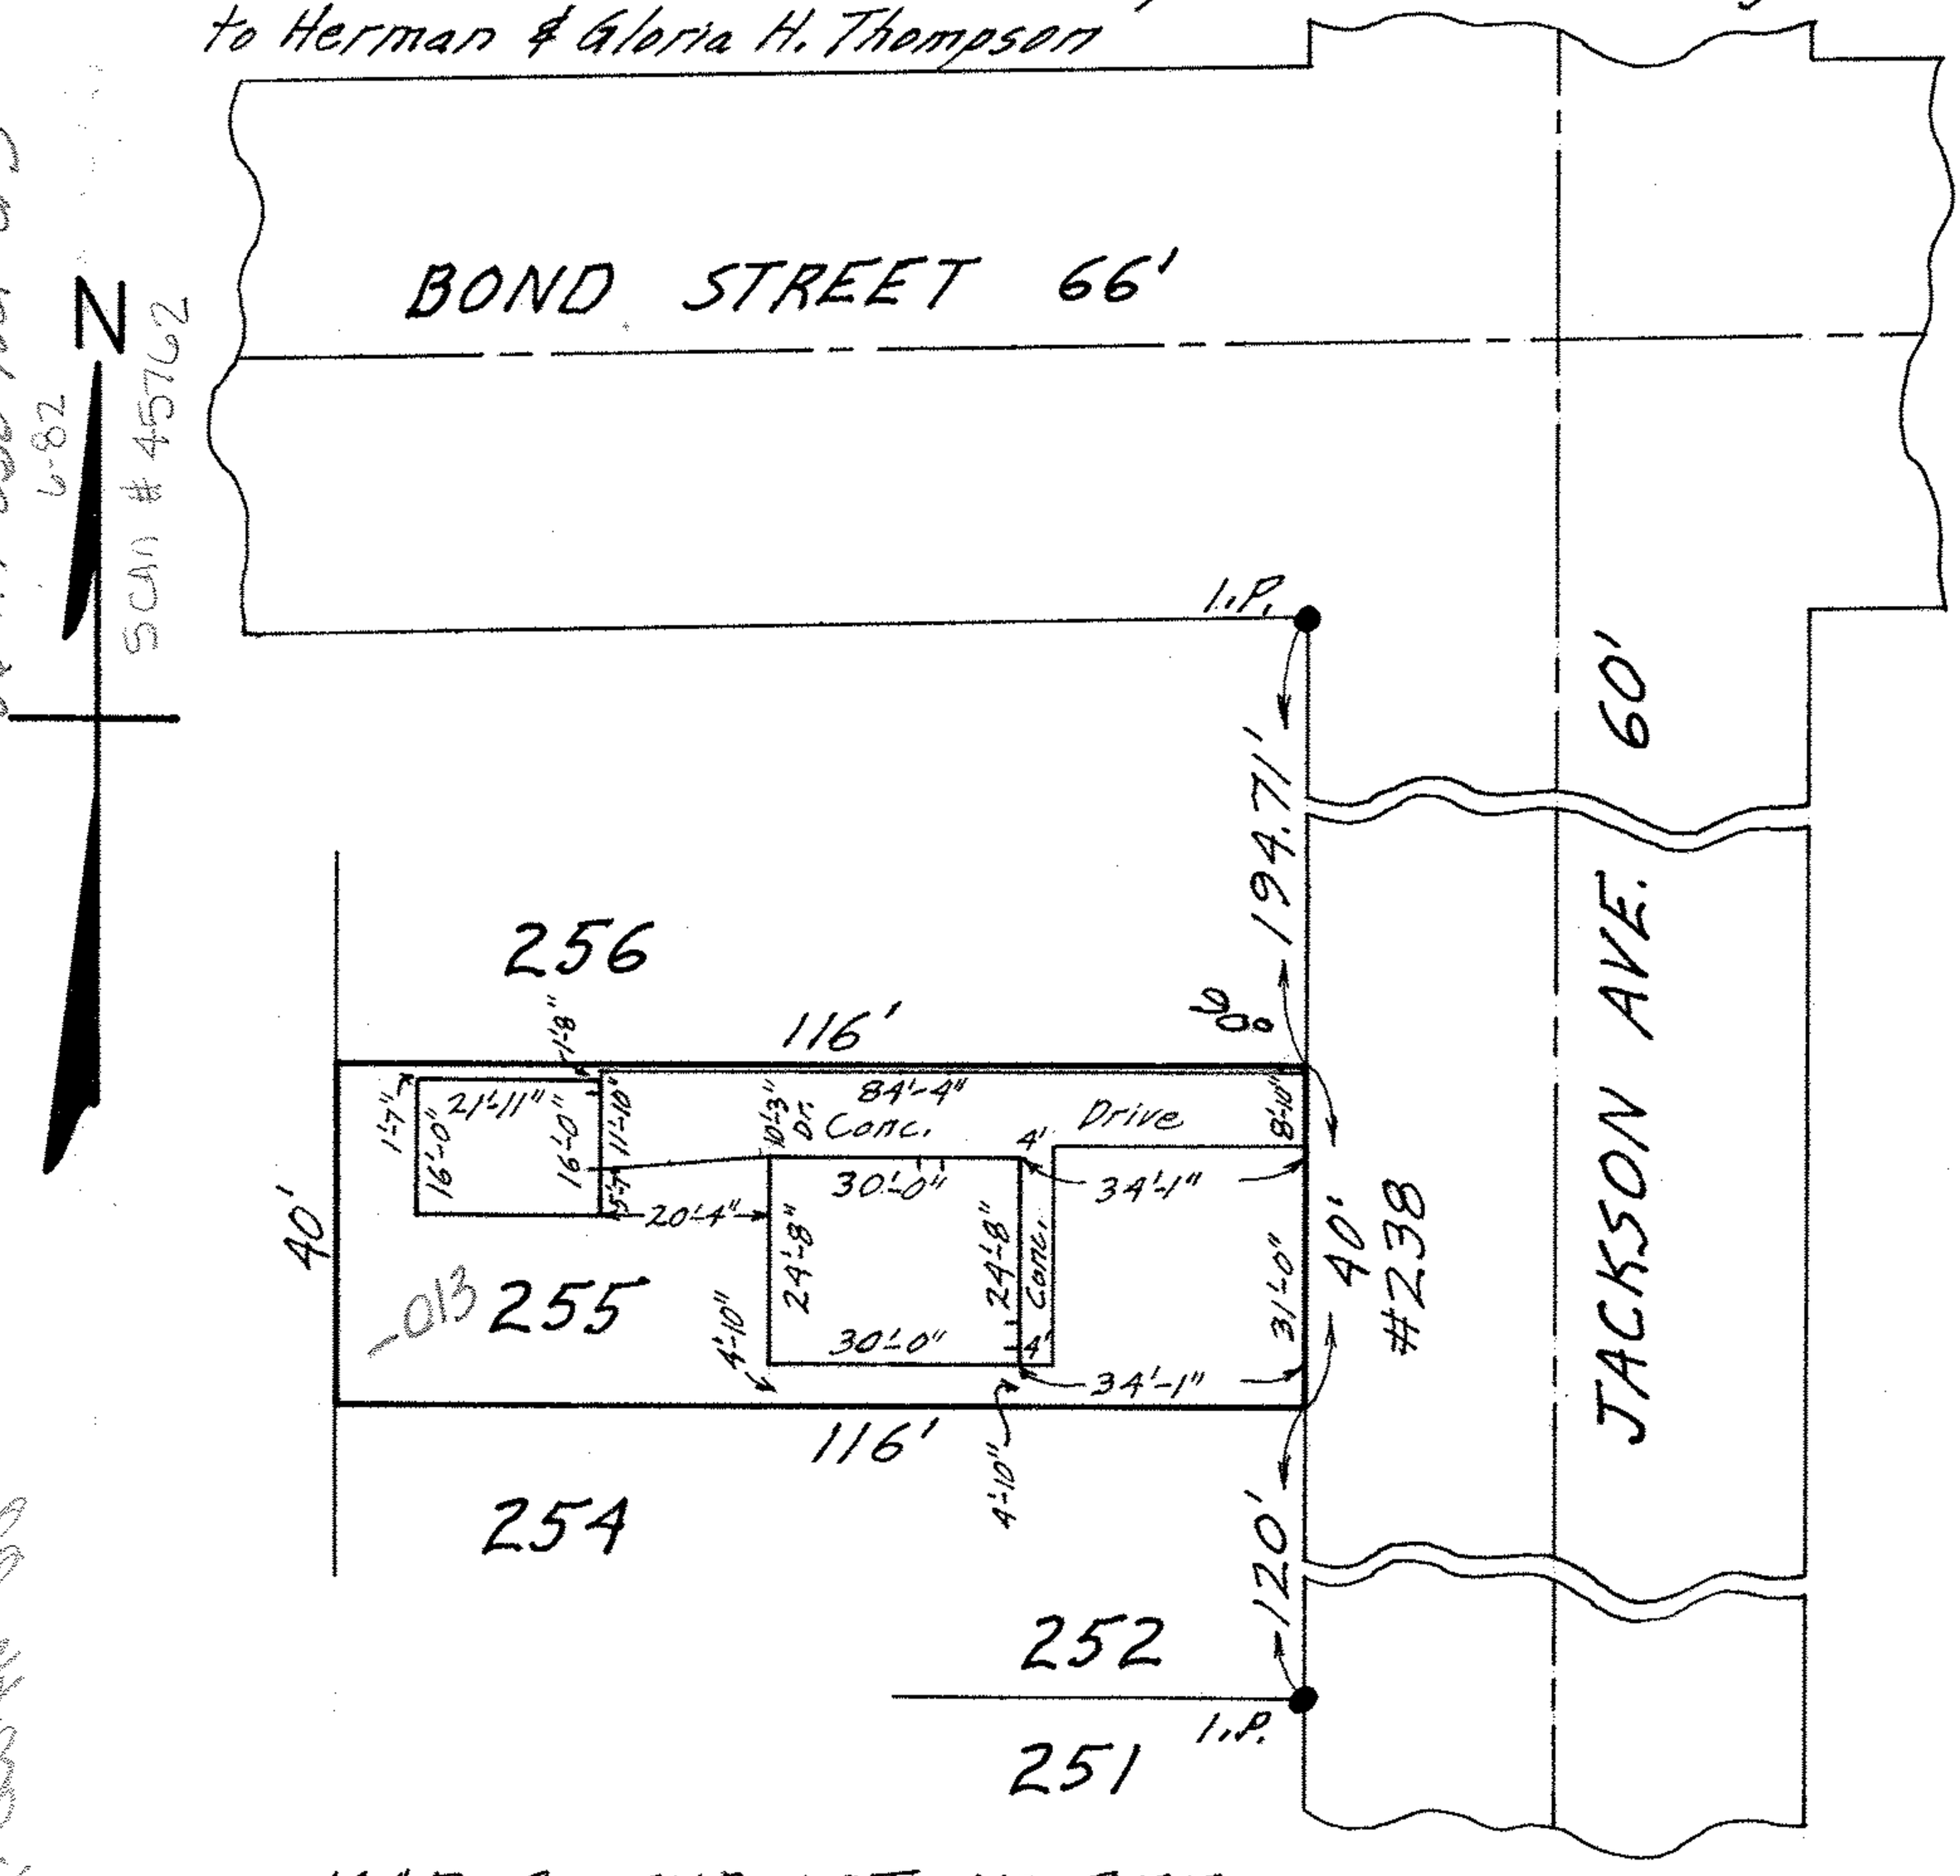


MAP OF SUB-LOT NO. 255

S. MENDELSON'S SUB'N. VOL. 7 PG. 23 PLATS

ORIG. LOT 50 - WEST OF BLACK RIVER - ELYRIA TWP.

ELYRIA CITY - LORAIN COUNTY - OHIO

SCALE: 1"=30' SEPT. 14-1969 5:00 P.M.

NOTE: There are no encroachments on the above property.

Gary E. Penfound REG. SURVEYOR NO. 4457

06-24-050-162-013