MAP OF PART OF ORIG. LOT NO. 57 WEST OF BLACK RIVER
ELYRIA TWP. — ELYRIA CITY - LORAIN COUNTY - OHIO
SCALE: 1" = 30' NOV. 22 - 1969 2:15 P.M.
NOTE: There are no encroachments on this property.
Gary E. Penfound REG. SURVEYOR NO. 4457

CITY TITLE CO. Order No. E-944-5
Kilzer to Ellison

Scan # 45770
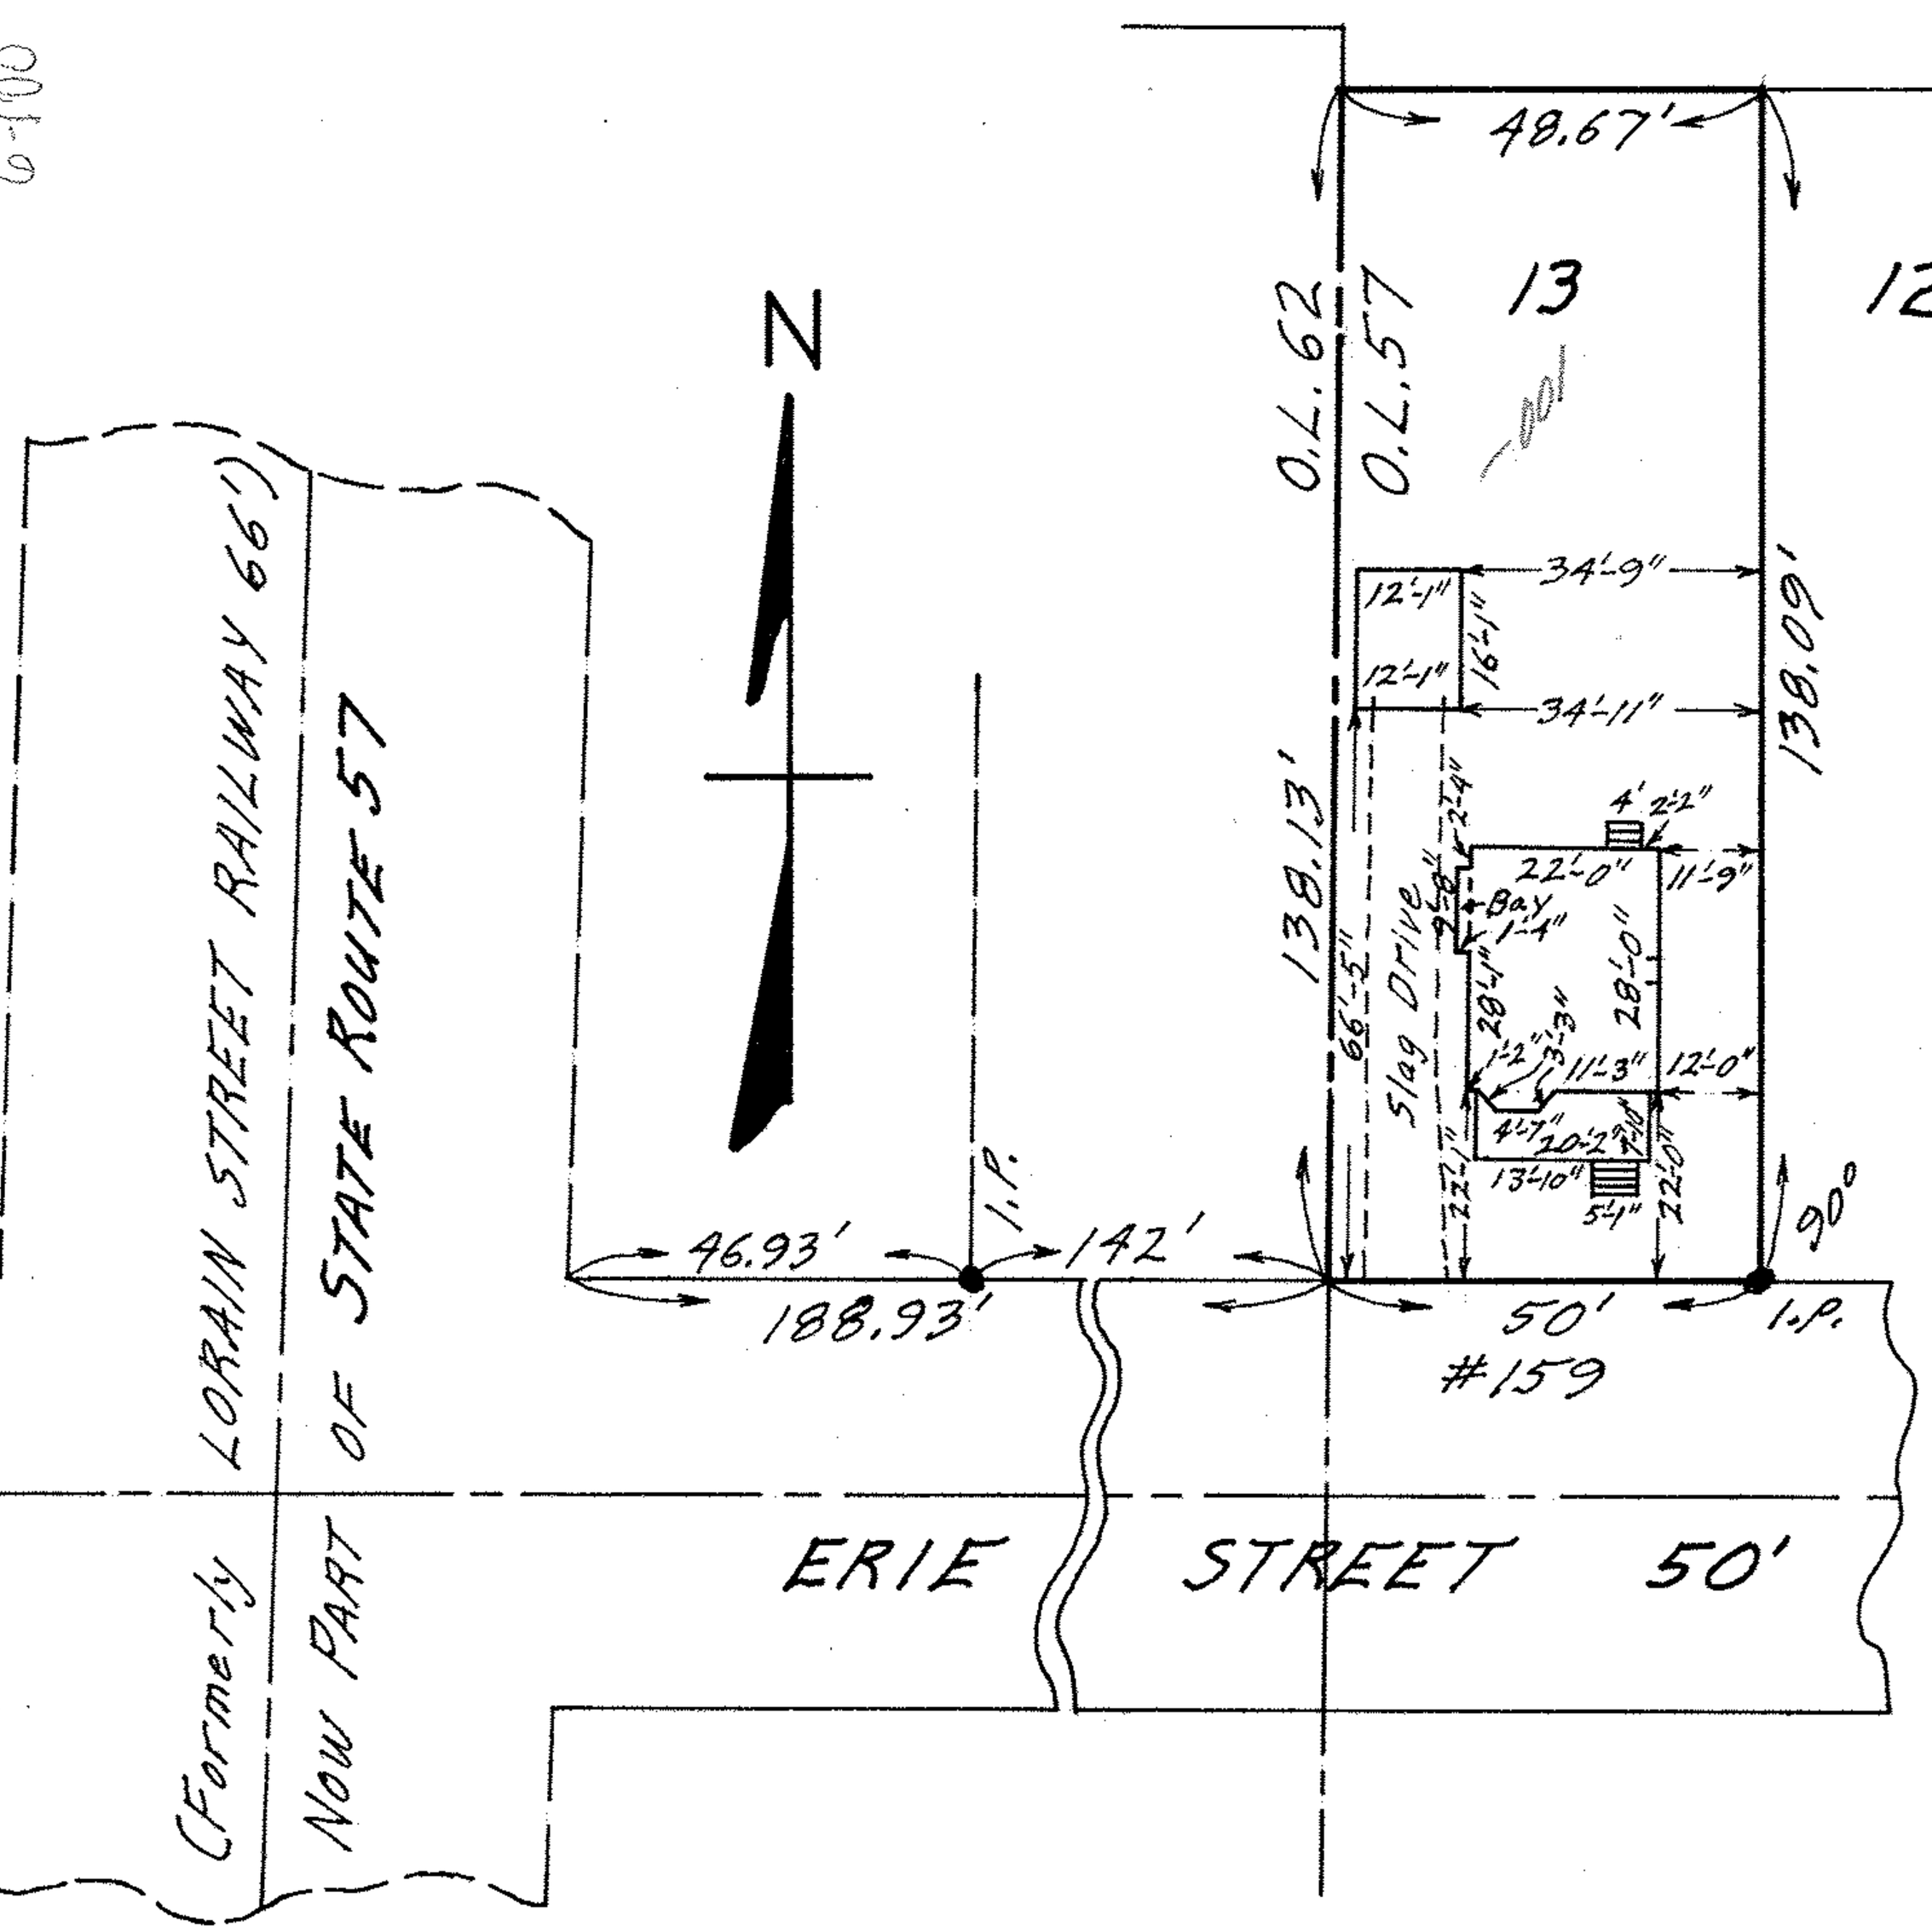
06-24-05
6-100