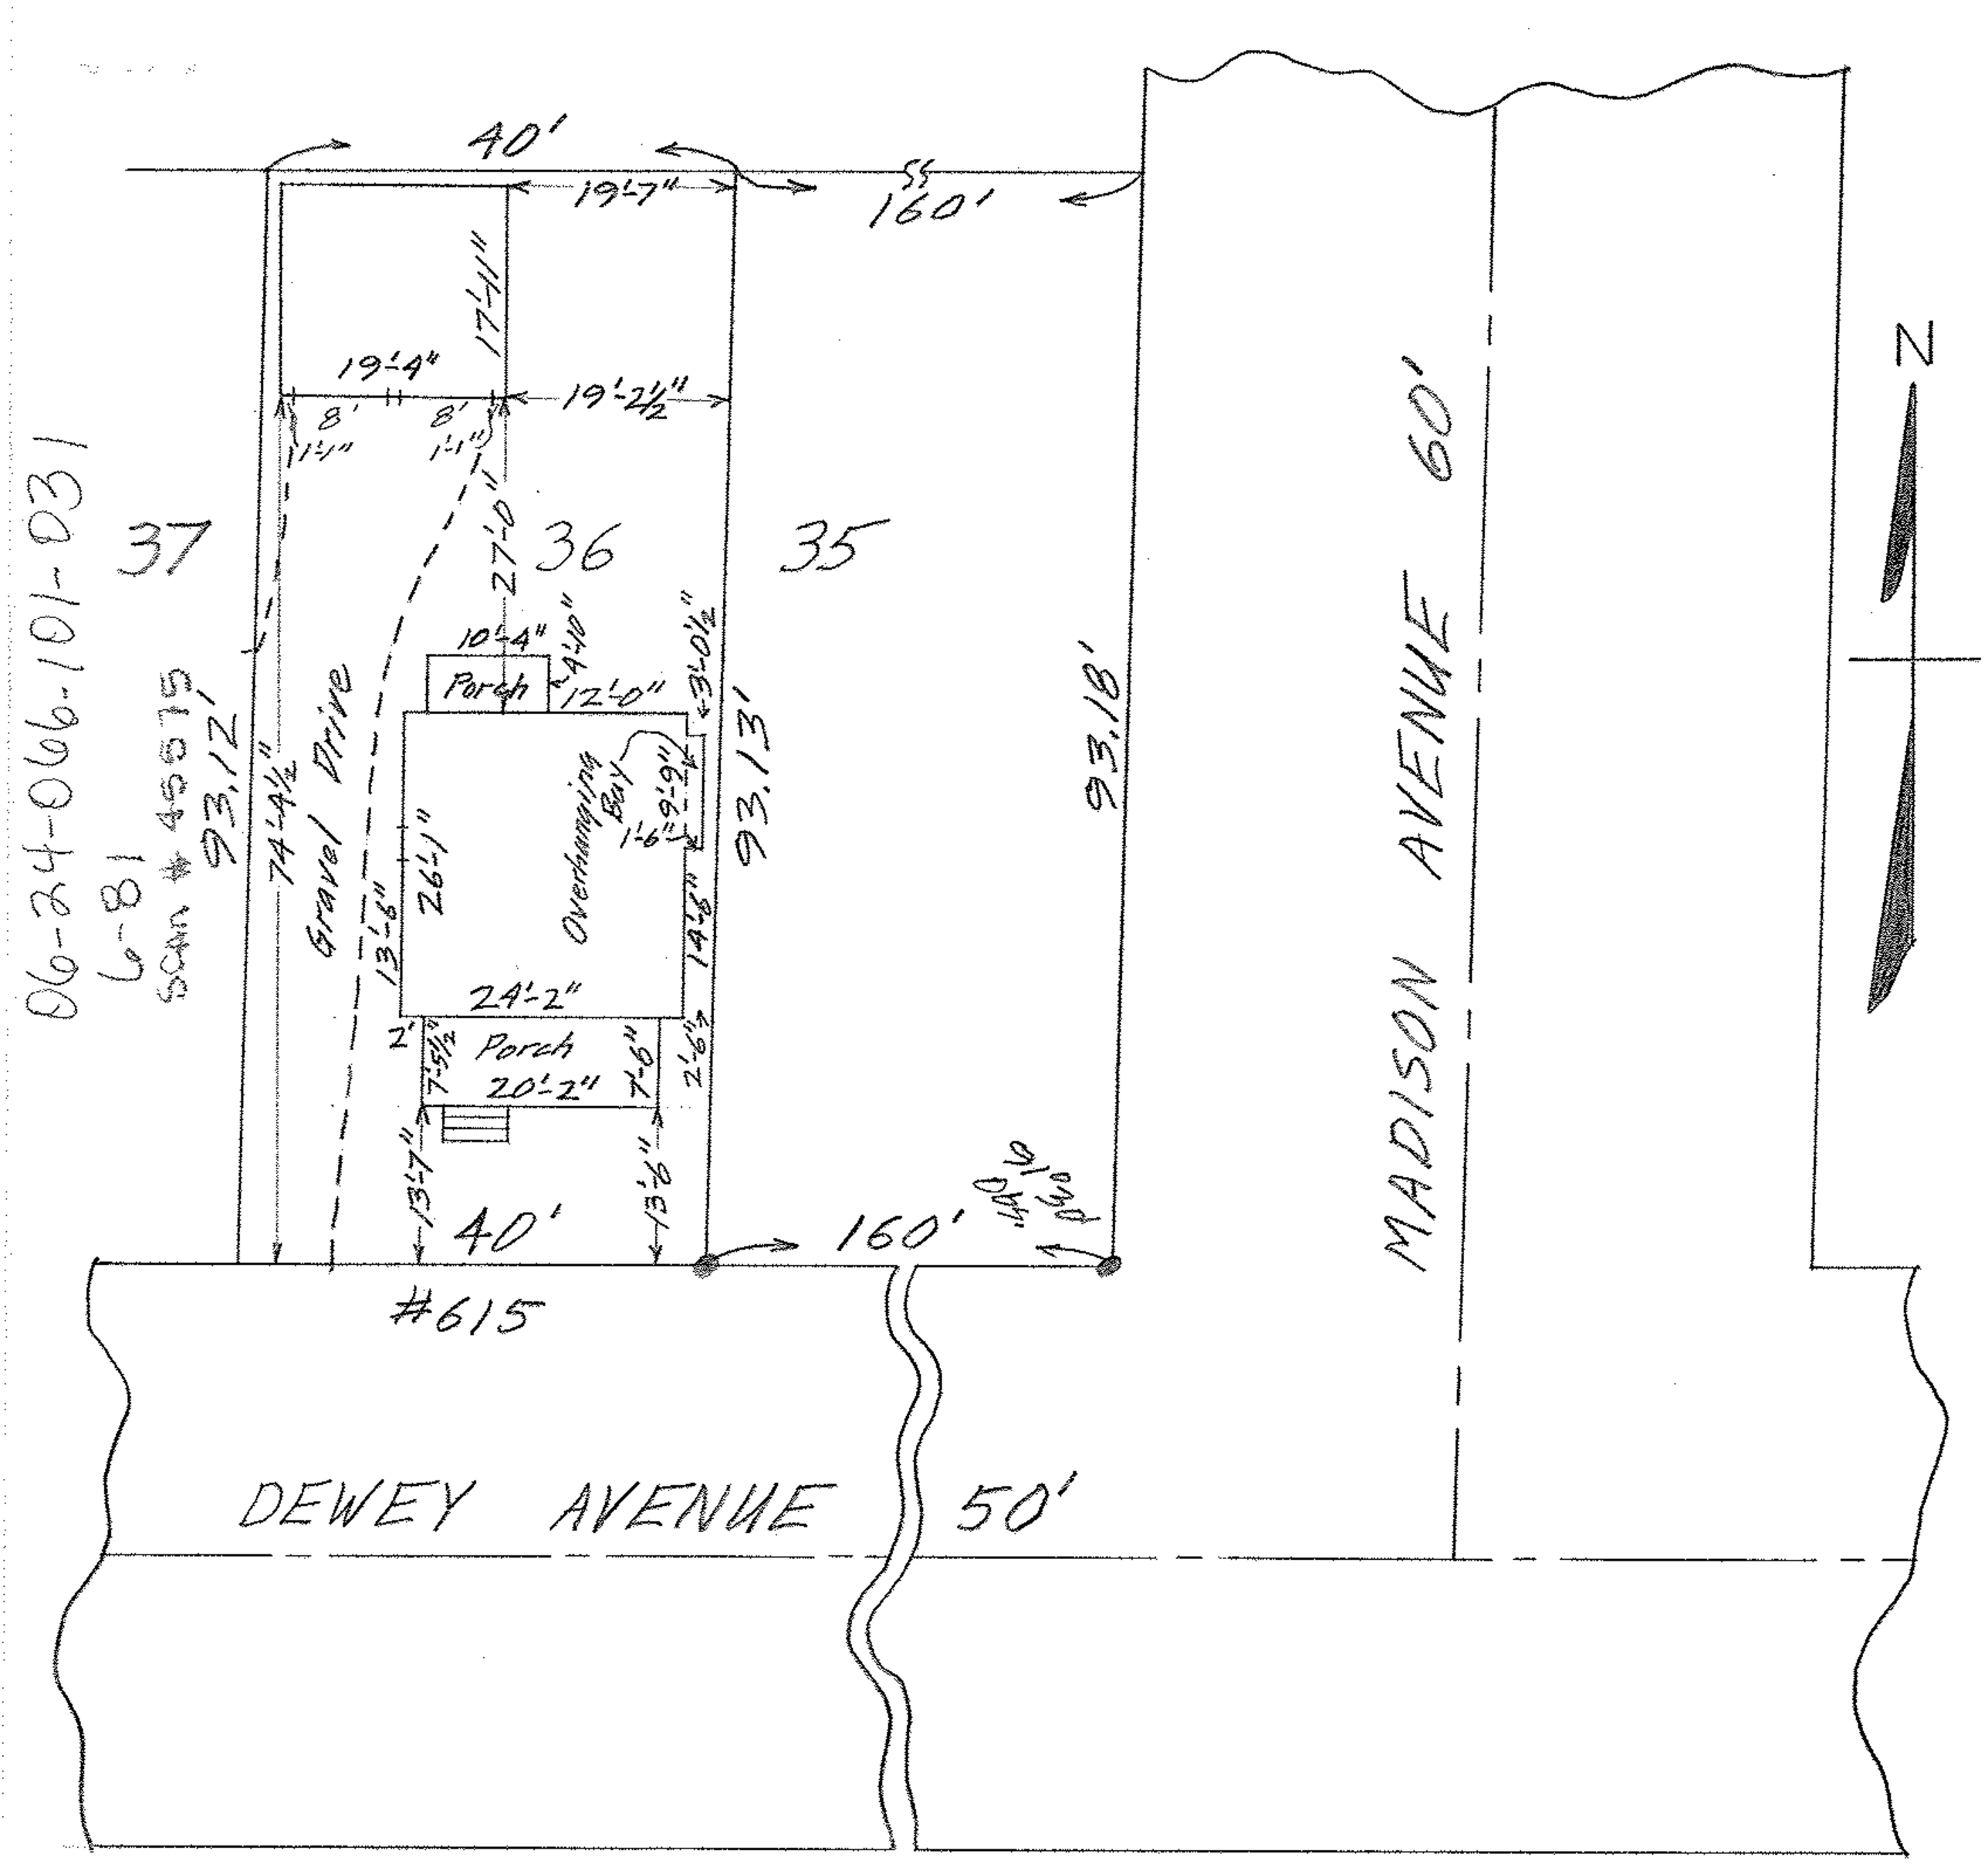

MAP OF SUB-LOT NO. 36
FOSTER'S ADD'N. VOL. 5 PG. 7 PLATS
O.L. 65 WEST OF RIVER ELYRIA TWP.
ELYRIA CITY - LORAIN COUNTY - OHIO
SCALE: 1" = 20' APRIL 20-1963 3:15 P.M.
Gary E. Penfound REG. SURVEYOR

Merrill E. & Eileen E. McCarty
W w