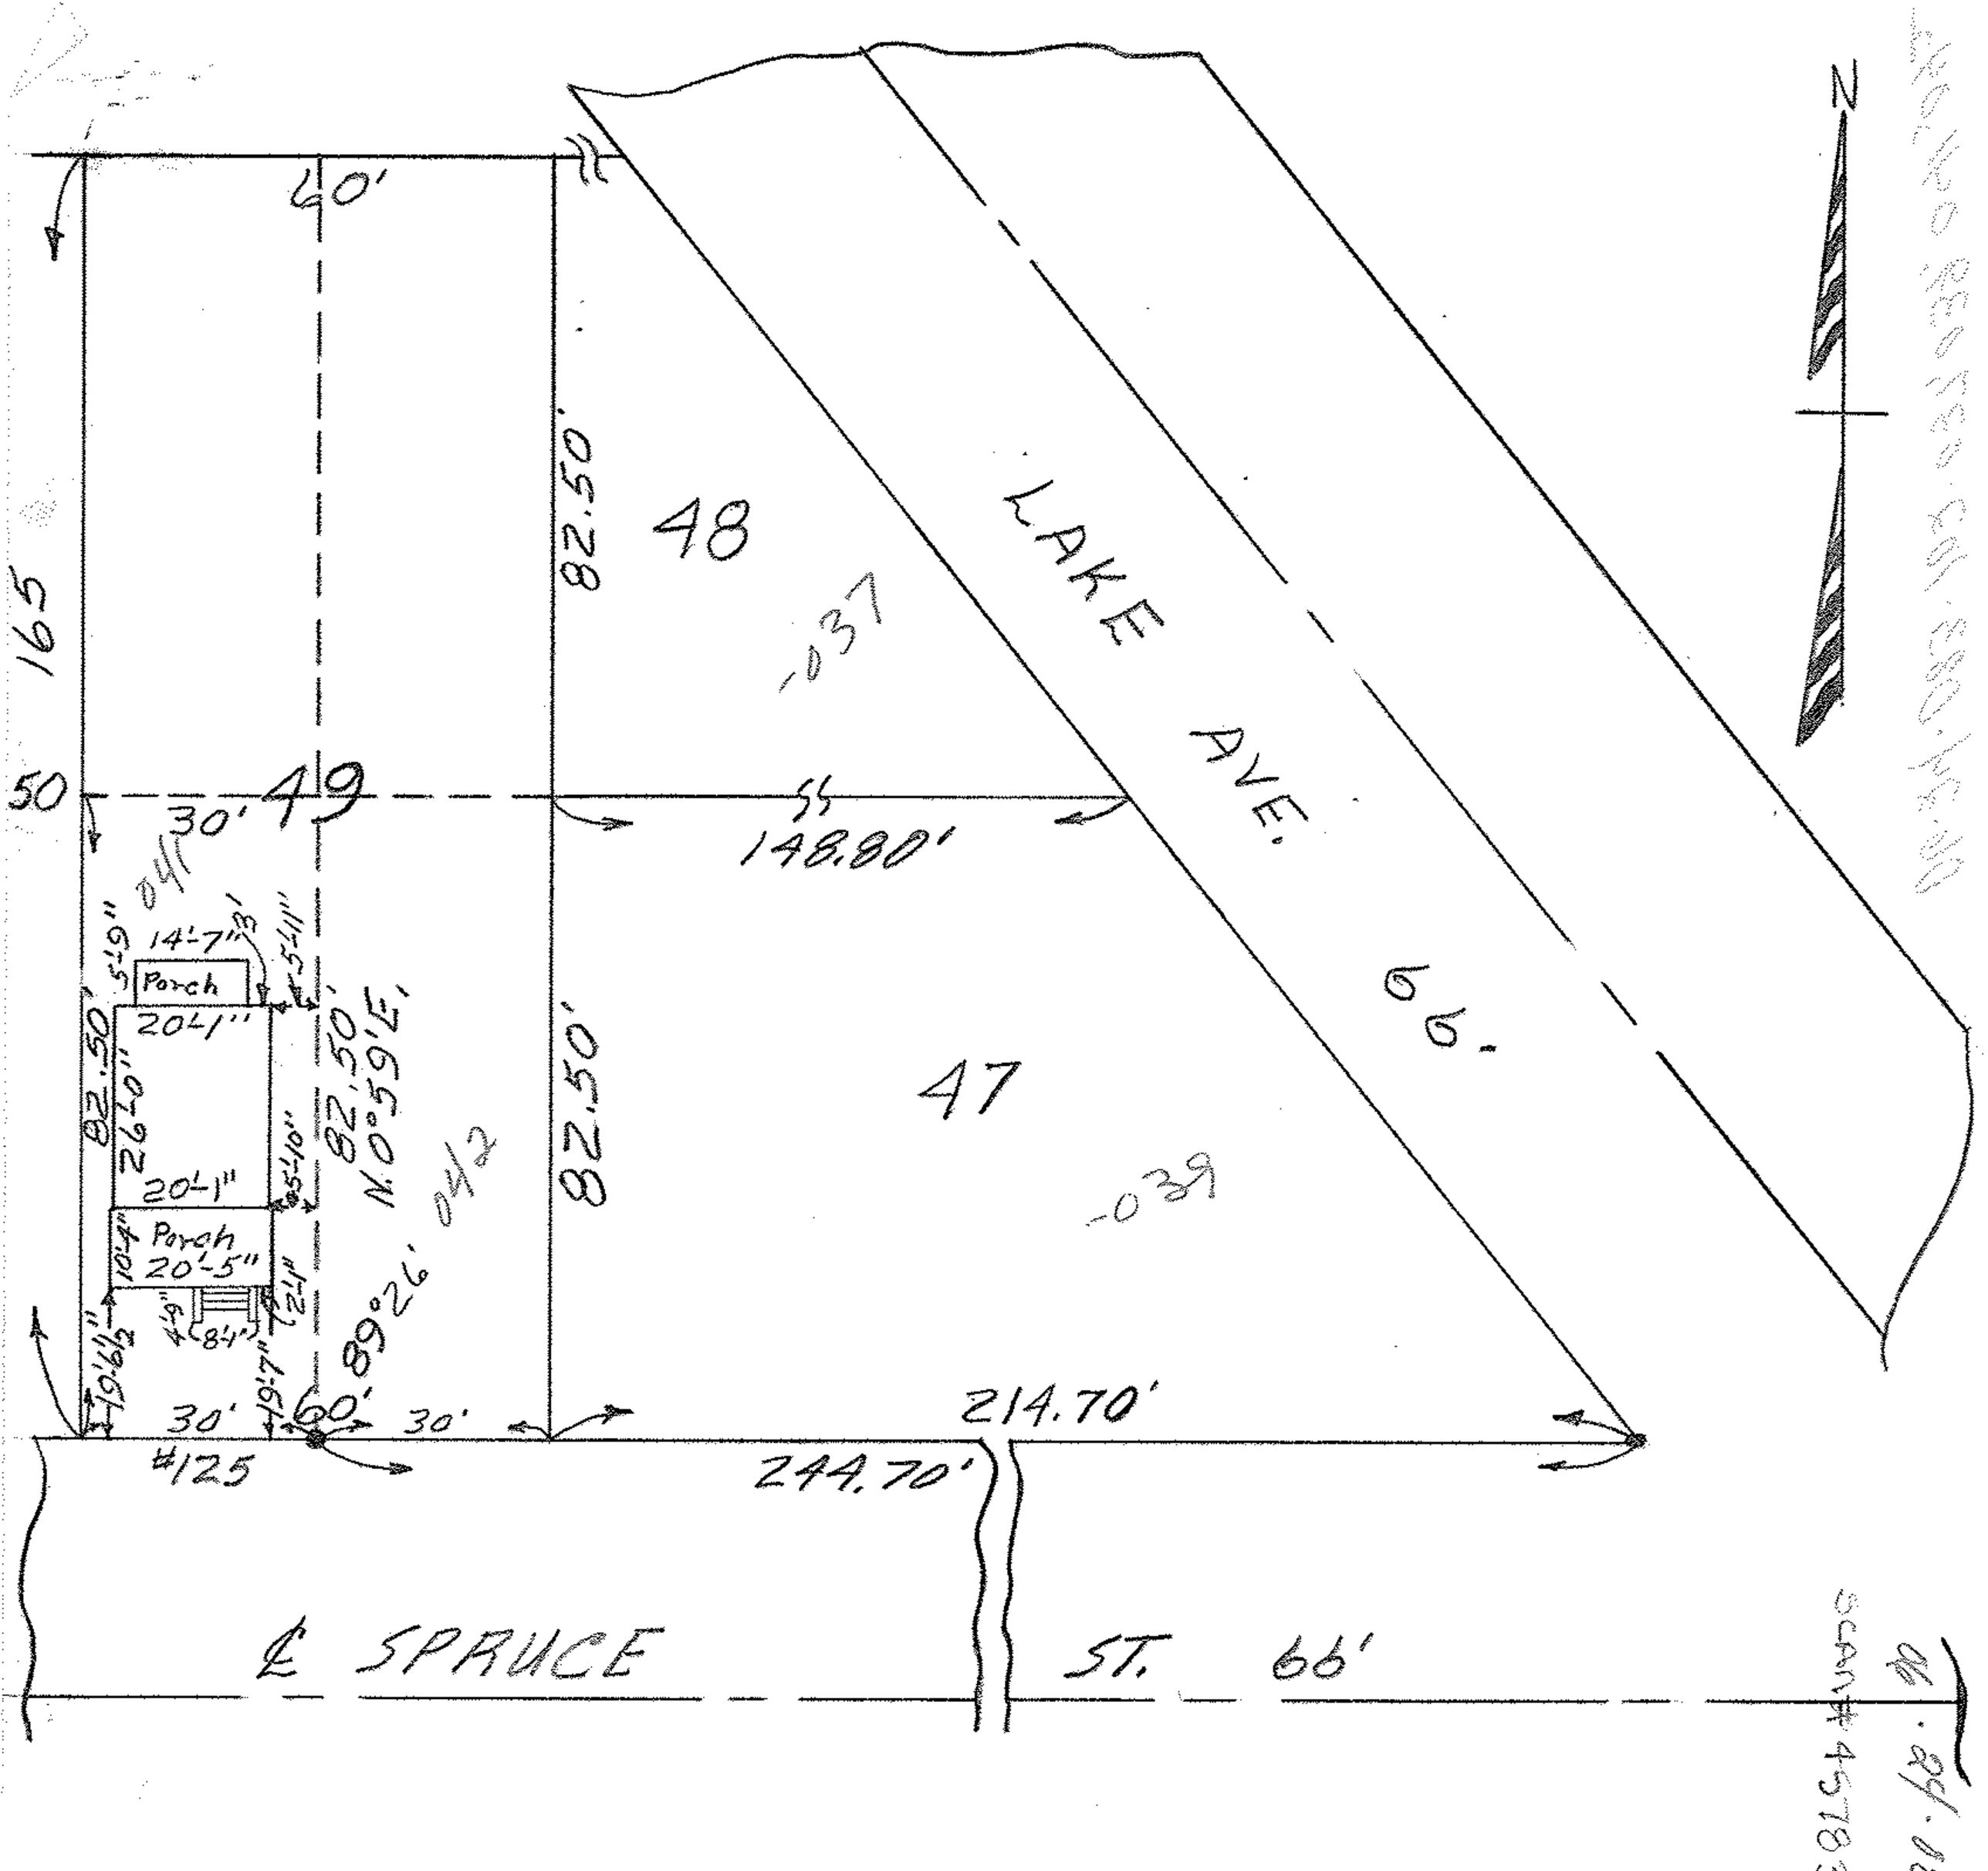

MAP of Part of SUB-LOT 49
WILLIAM A. BRAMAN'S ADD'N Vol. 3 Pg 1, PLATS
ELYRIA CITY LORAIN COUNTY-OHIO
Scale: 1" = 30' JAN. 28, 1963 3:30 PM.

Harry E. Renfound Registered Surveyor

Charles E. & Cora L. Skinner W W

