


06-25-006-106-012

SCAN #45818

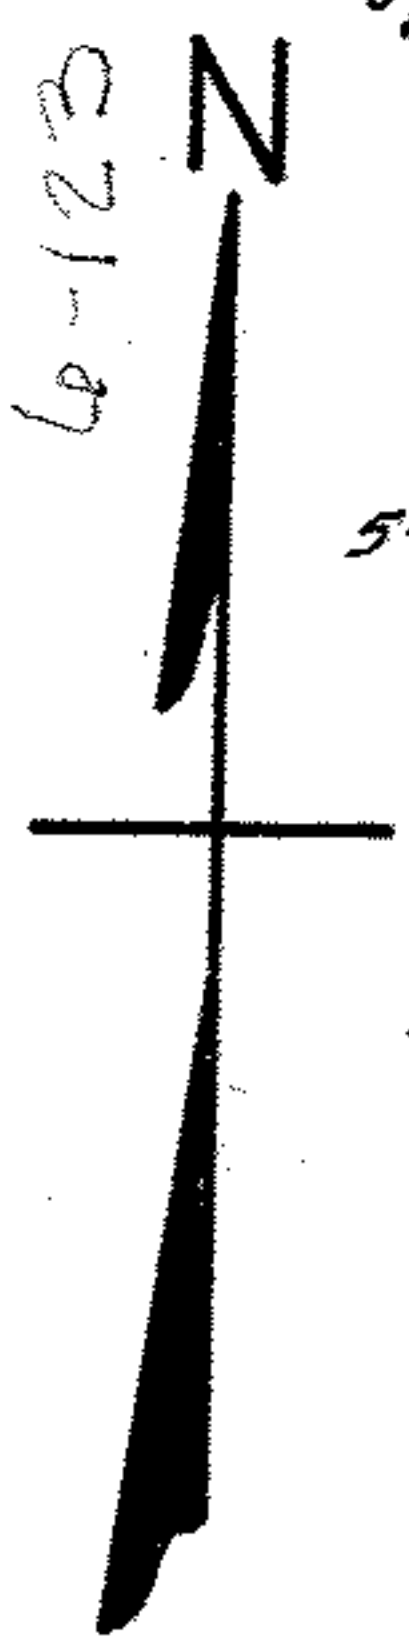

132

131

130

129

#541

45'

96.17'

45' I.P.

51.17'

I.P.

90°


90°

140'

140'

140'

140'

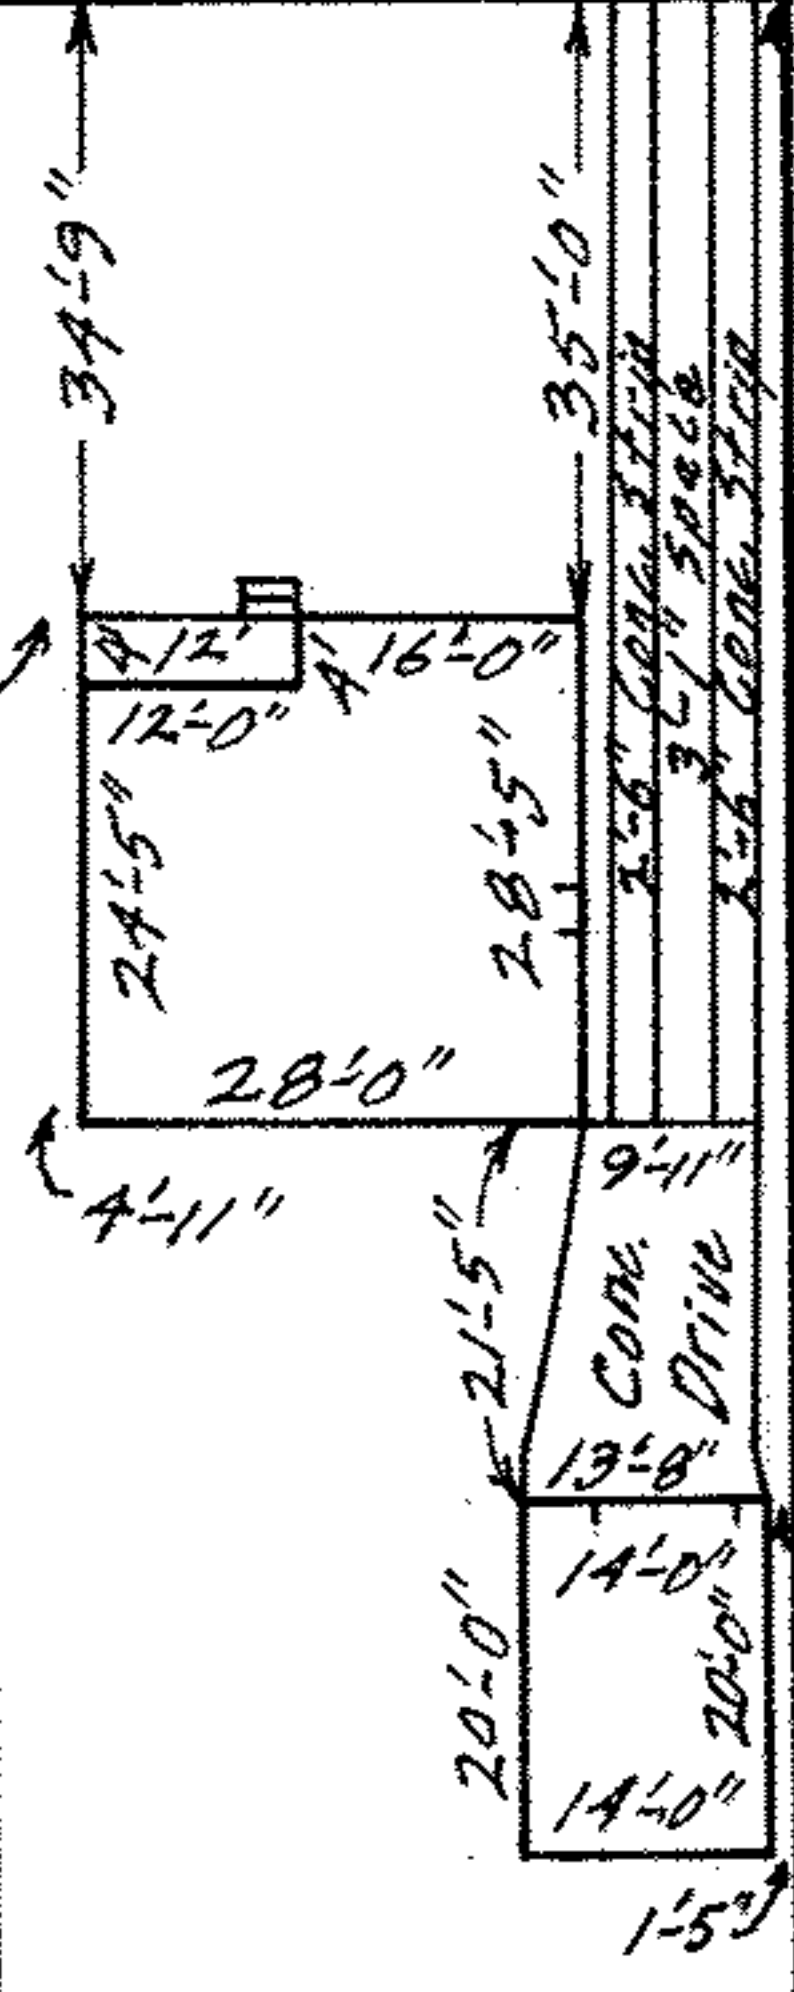

45'

45'

51.17'

34'-9"

35'-0"

12'-0"

28'-0"

28'-45"

24'-5"

28'-0"

28'-45"

4'-11"

20'-0"

13'-8"

9'-41"

14'-0"

14'-0"

20'-0"

1'-5"

14'-0"

1'-5"

45'

1'-7"

45' I.P.

90°

8'-12"

16'-0"
















































