


06-25-006-115-00Z
 Made for and at the instance of Security Federal Savings & Loan Association of Cleveland and Lawyers Title Insurance Corp. - A.H. West, Approved Attorney.

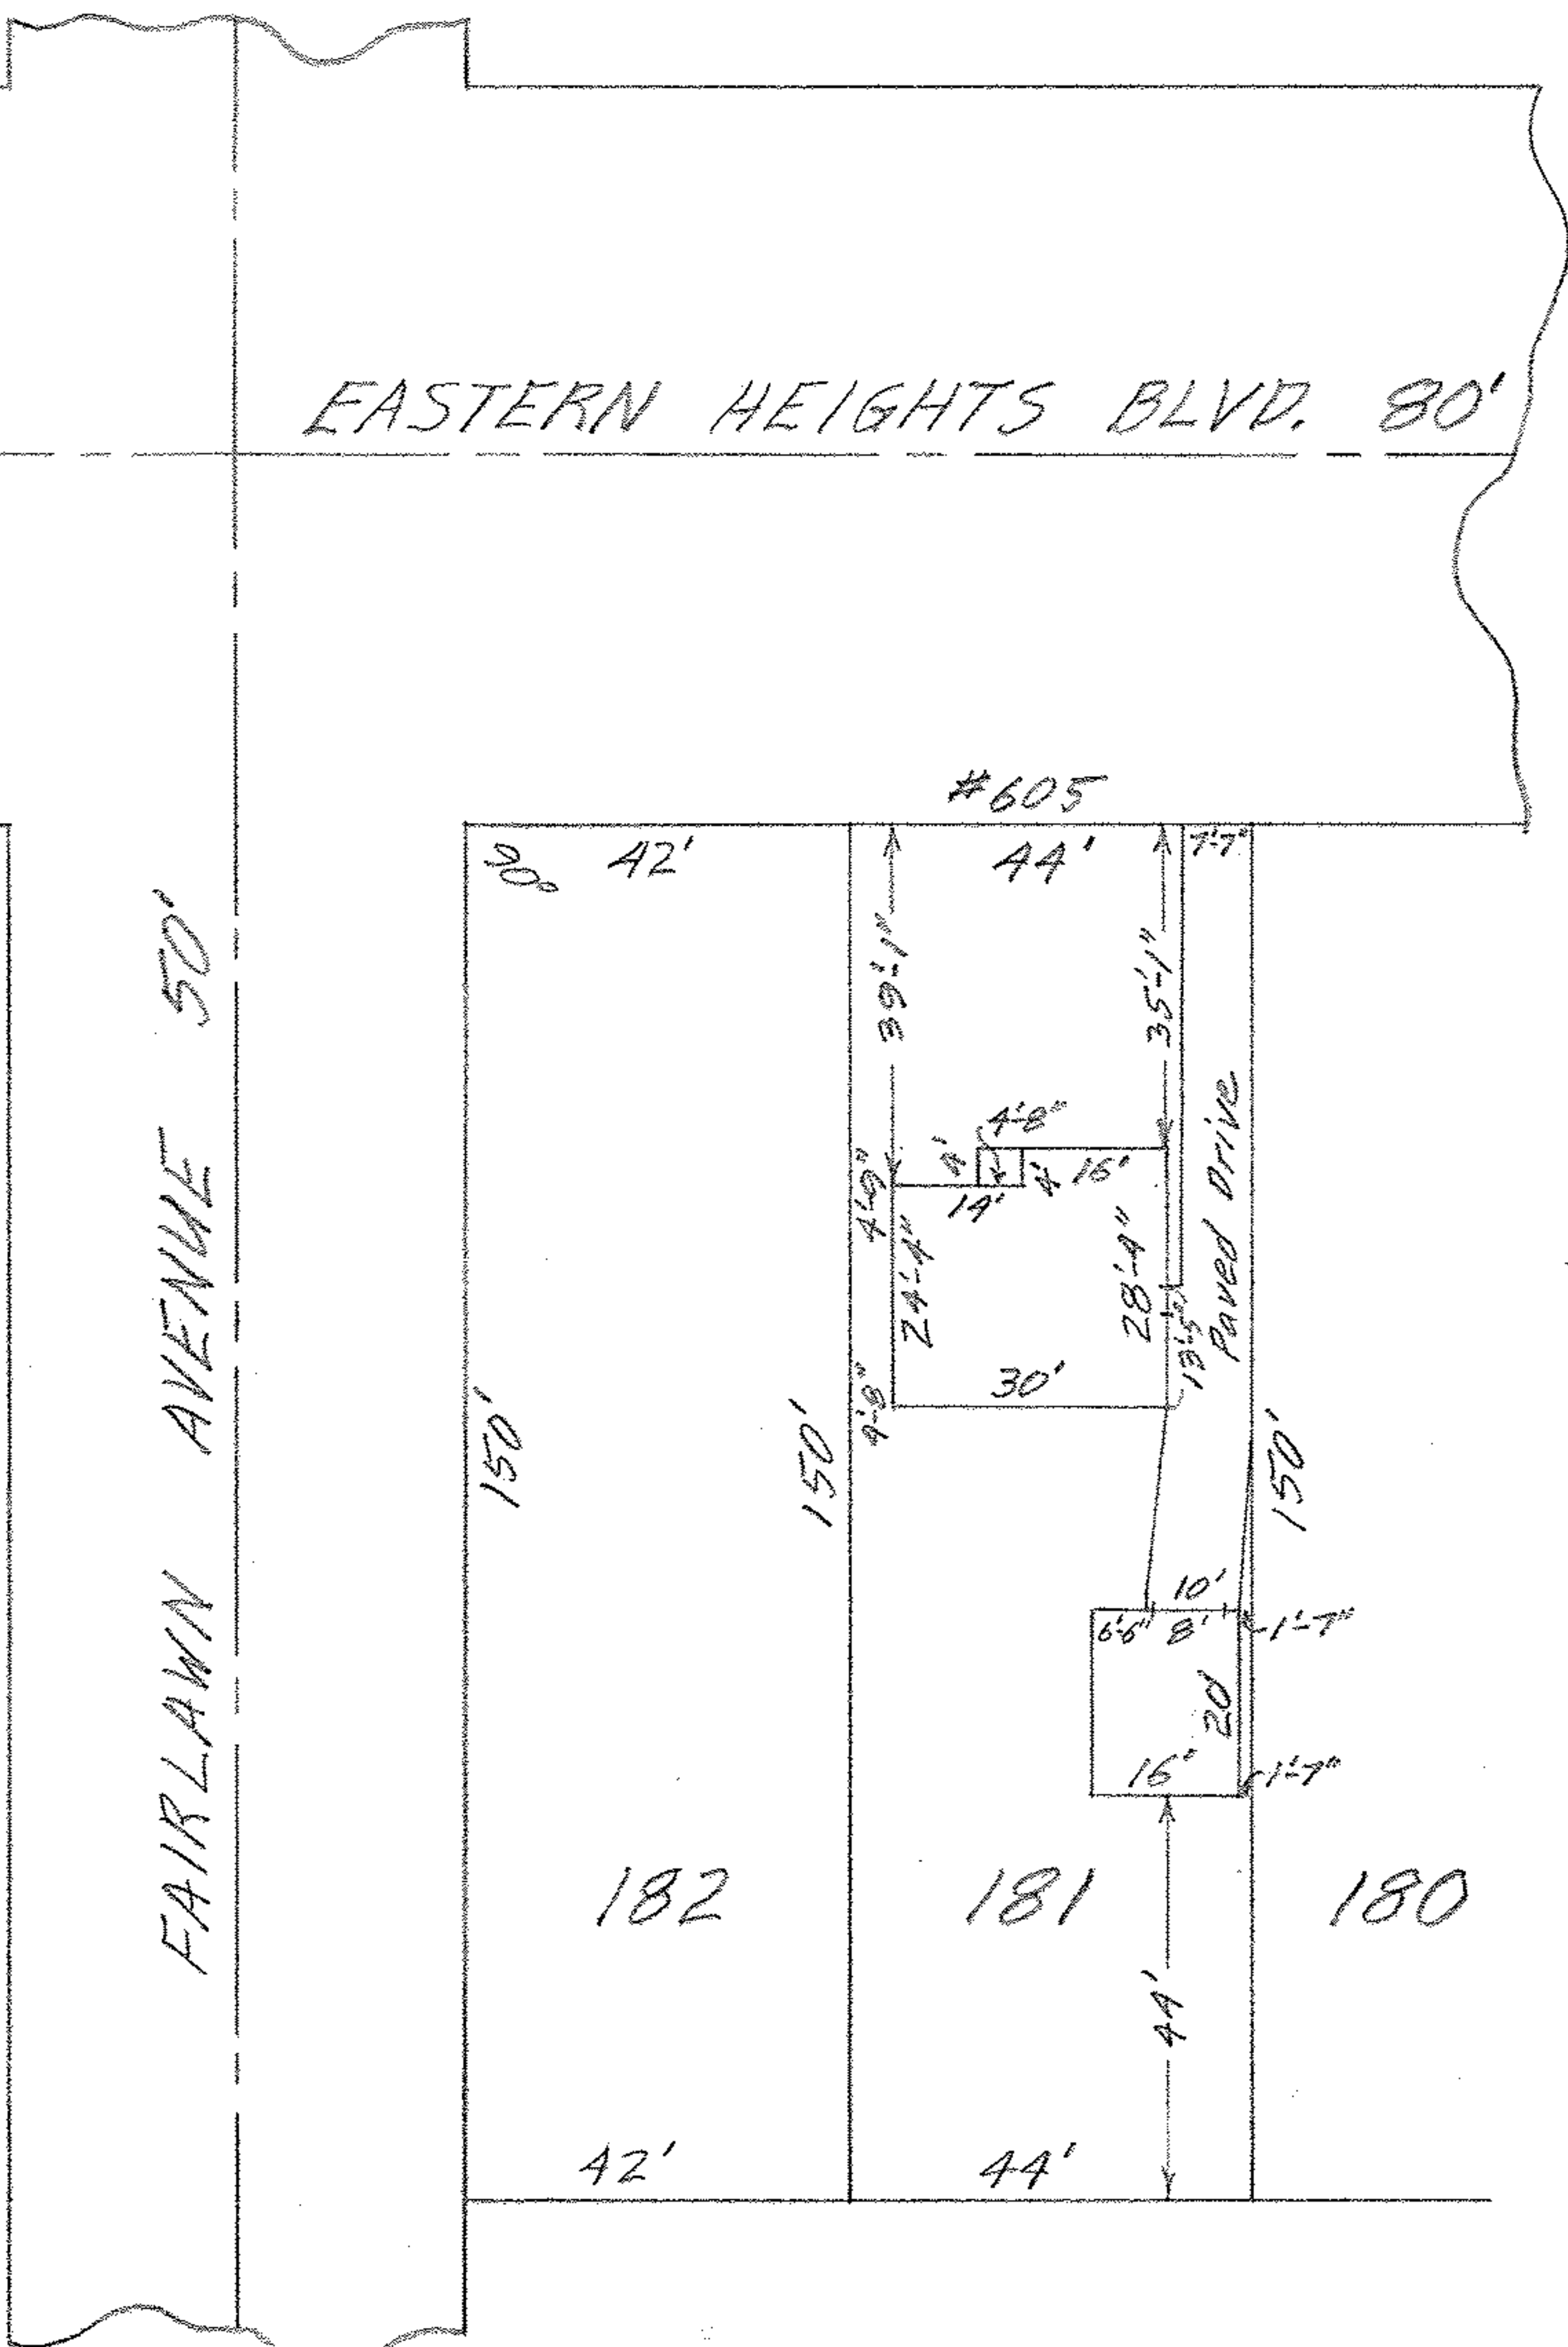

MAP OF SUB-LOT 181
 EAST BROAD ST. HEIGHTS ALL'T.
 VOL. 10 PG. 9 PLATS
 ORIG. LOT 6 EAST OF RIVER ELYRIA TWP.
 ELYRIA CITY - LORAIN COUNTY - OHIO
 SCALE: 1" = 30' APRIL 25-1960 5:00 P.M.
 Gary E. Perford REG. SURVEYOR

Robert Glover, Inc. W W