


06-25-006-117-001



6-123


SCAN # 45830

HARVARD AVE. 60'
N. 88° 18' E.

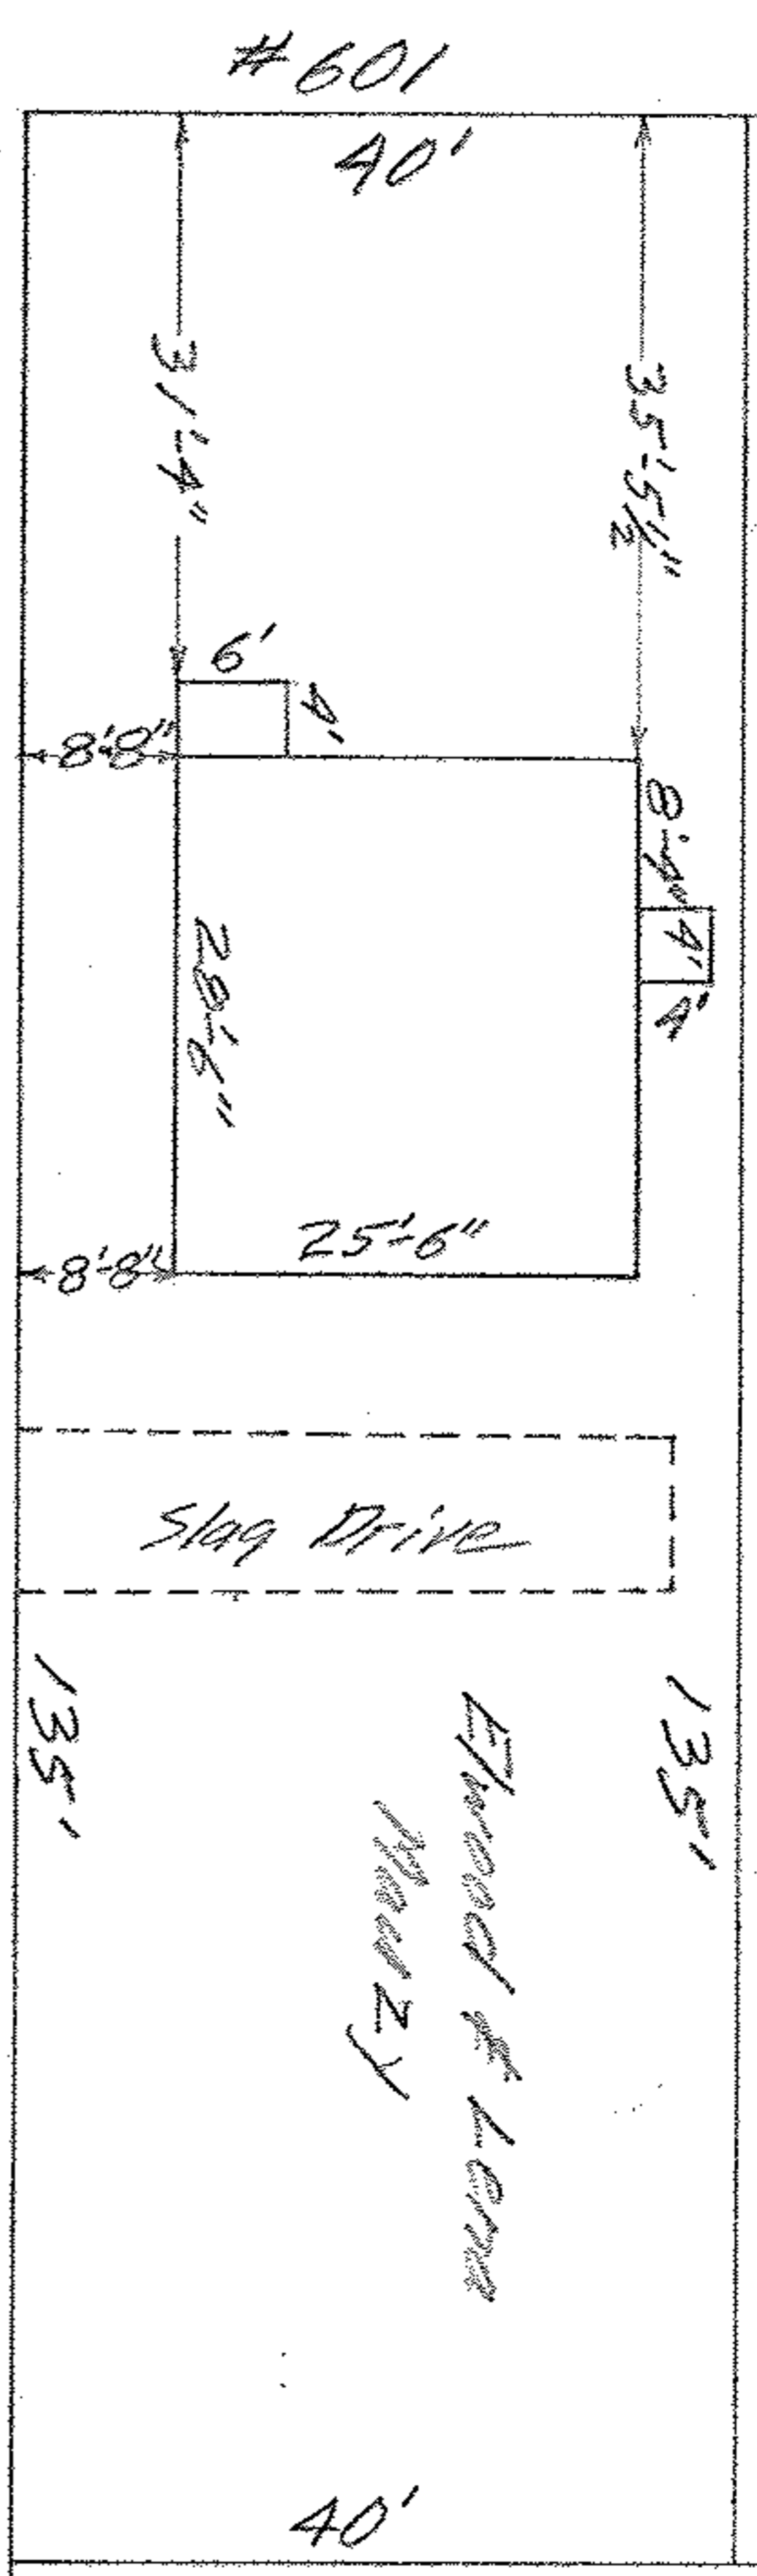

Mauzy

FAIRLAWN AVENUE 50'

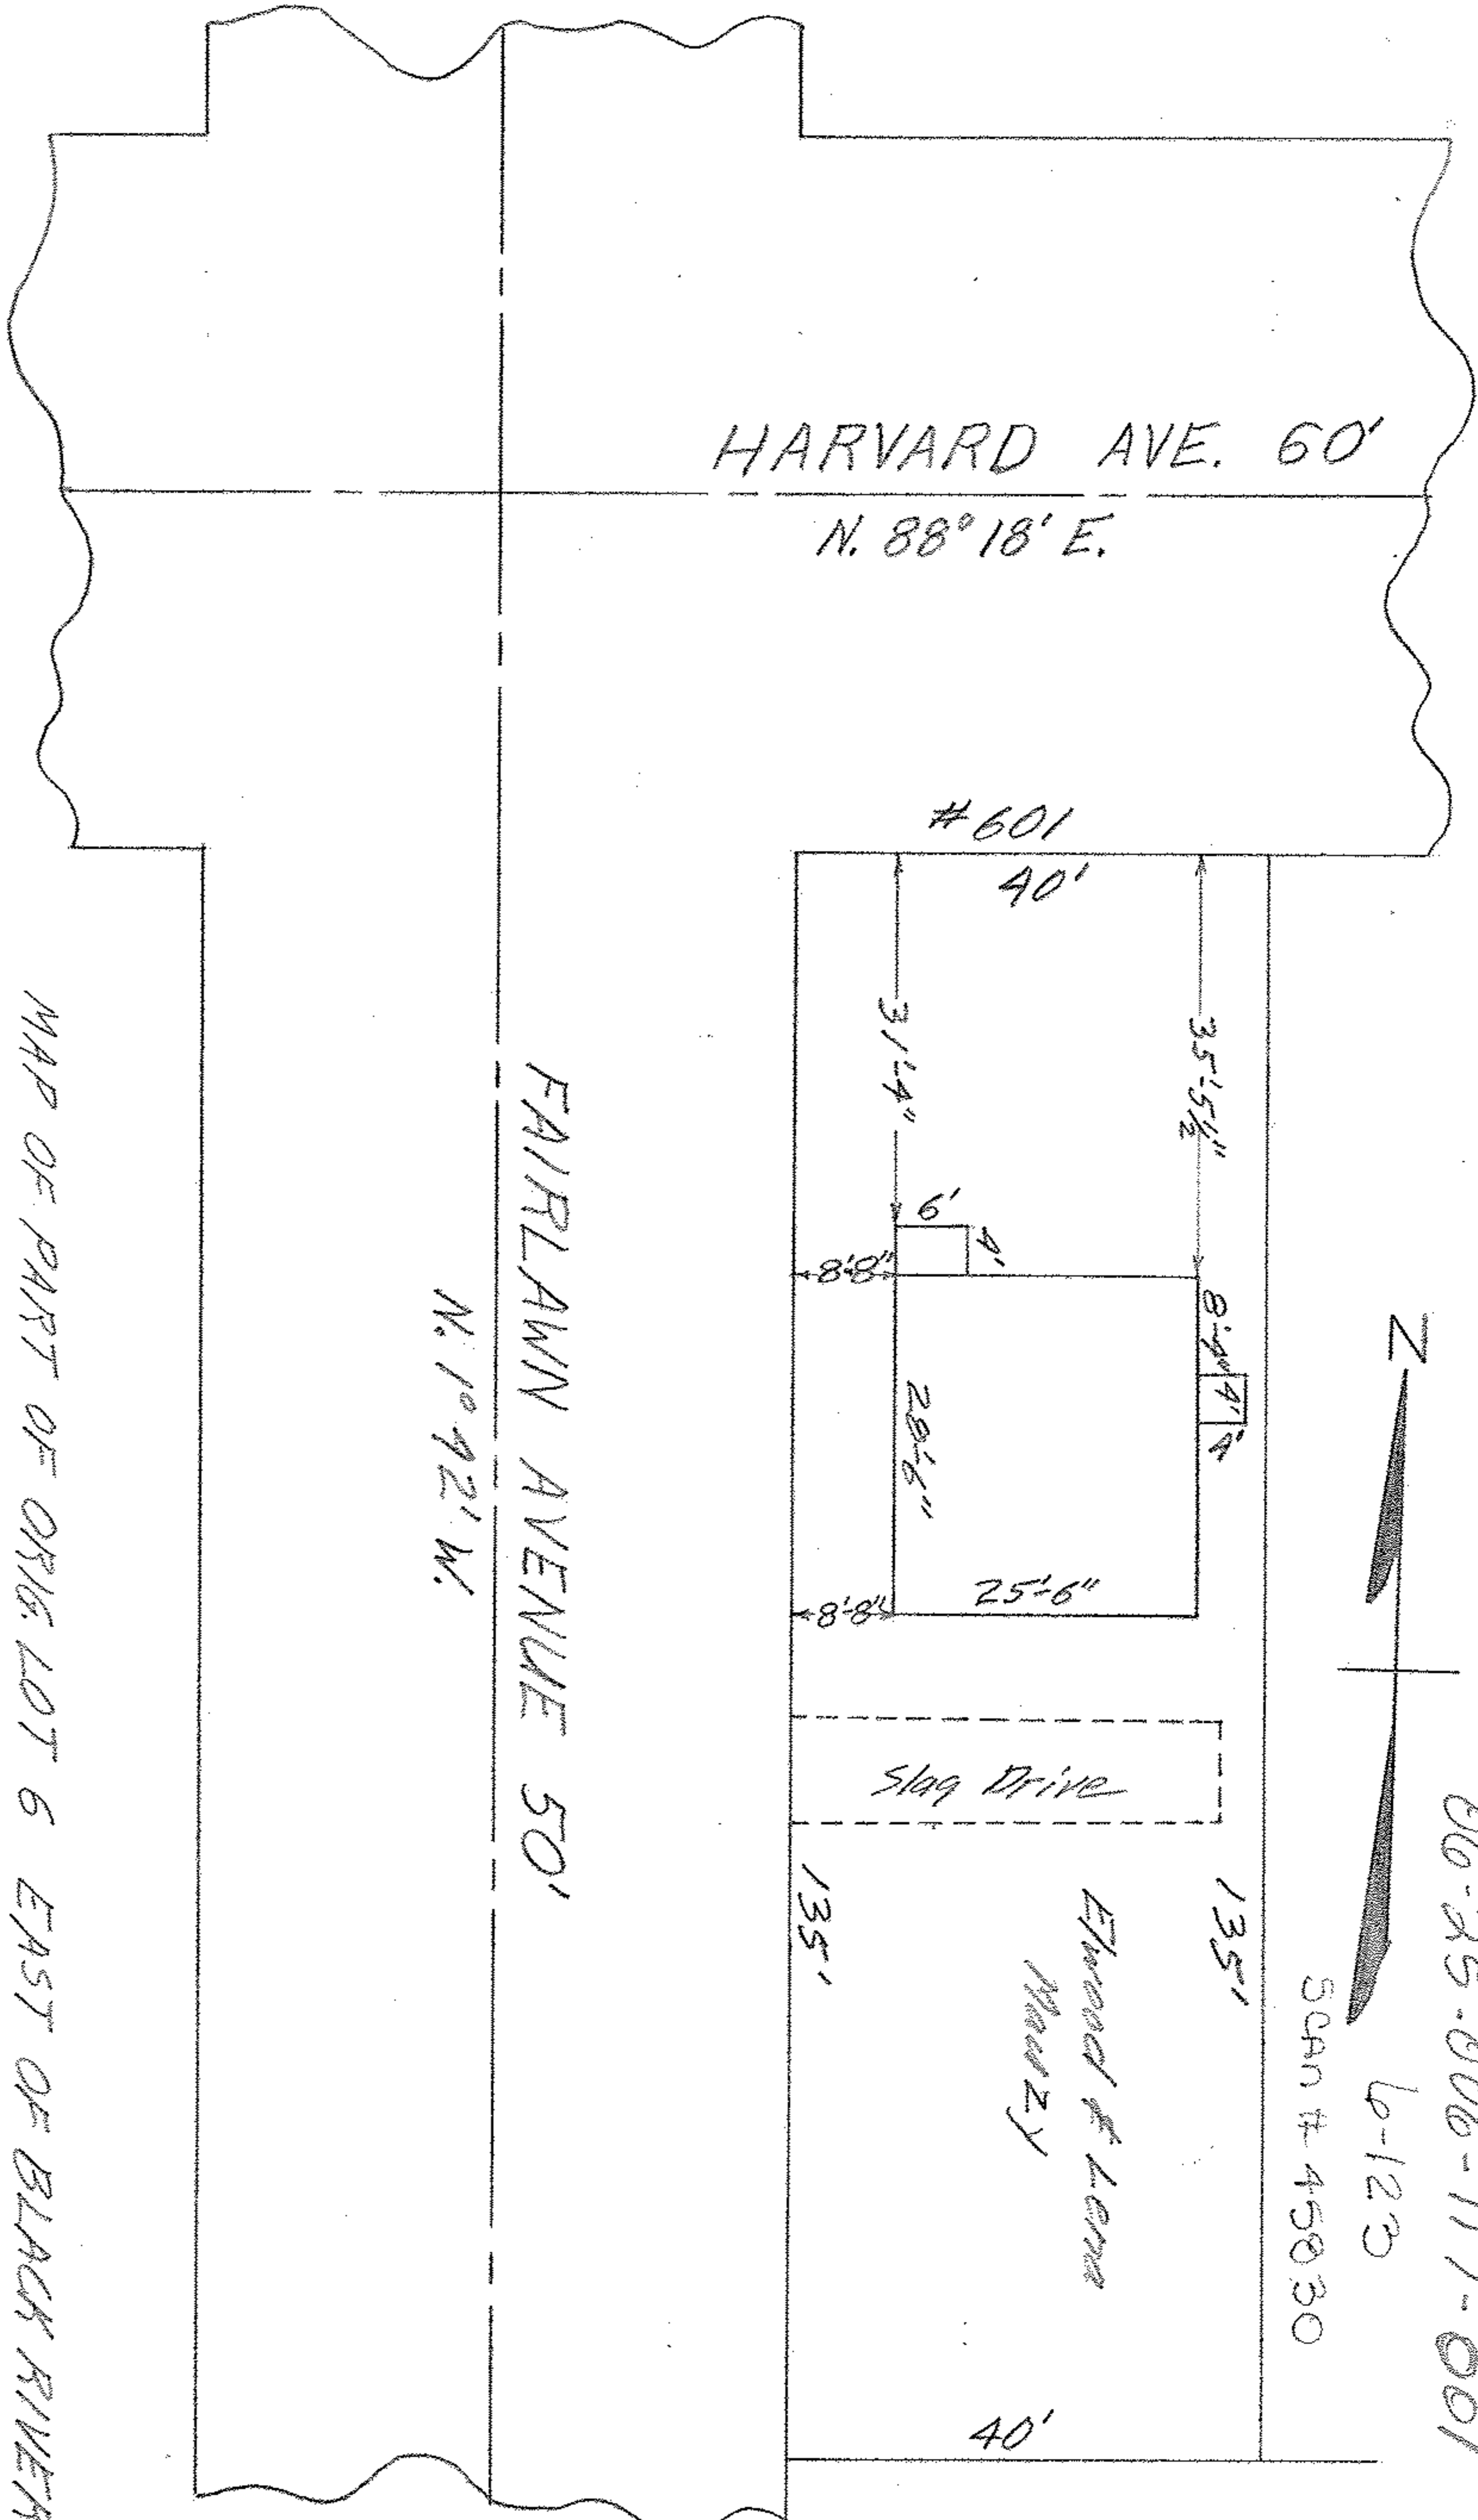

MAP OF PART OF ORIG. LOT 6 EAST OF BLACK RIVER
ELYRIA TOWNSHIP ELYRIA CITY
LORAIN COUNTY OHIO

SCALE: 1" = 20' SEPT. 25-1959 10:00 A.M.

Ray E. Mansford REG. SURVEYOR NO. 4457

Made for and at the instance of The Ohio Bar
Title Insurance Co. and The Elyria Savings &
Trust Co.

WW