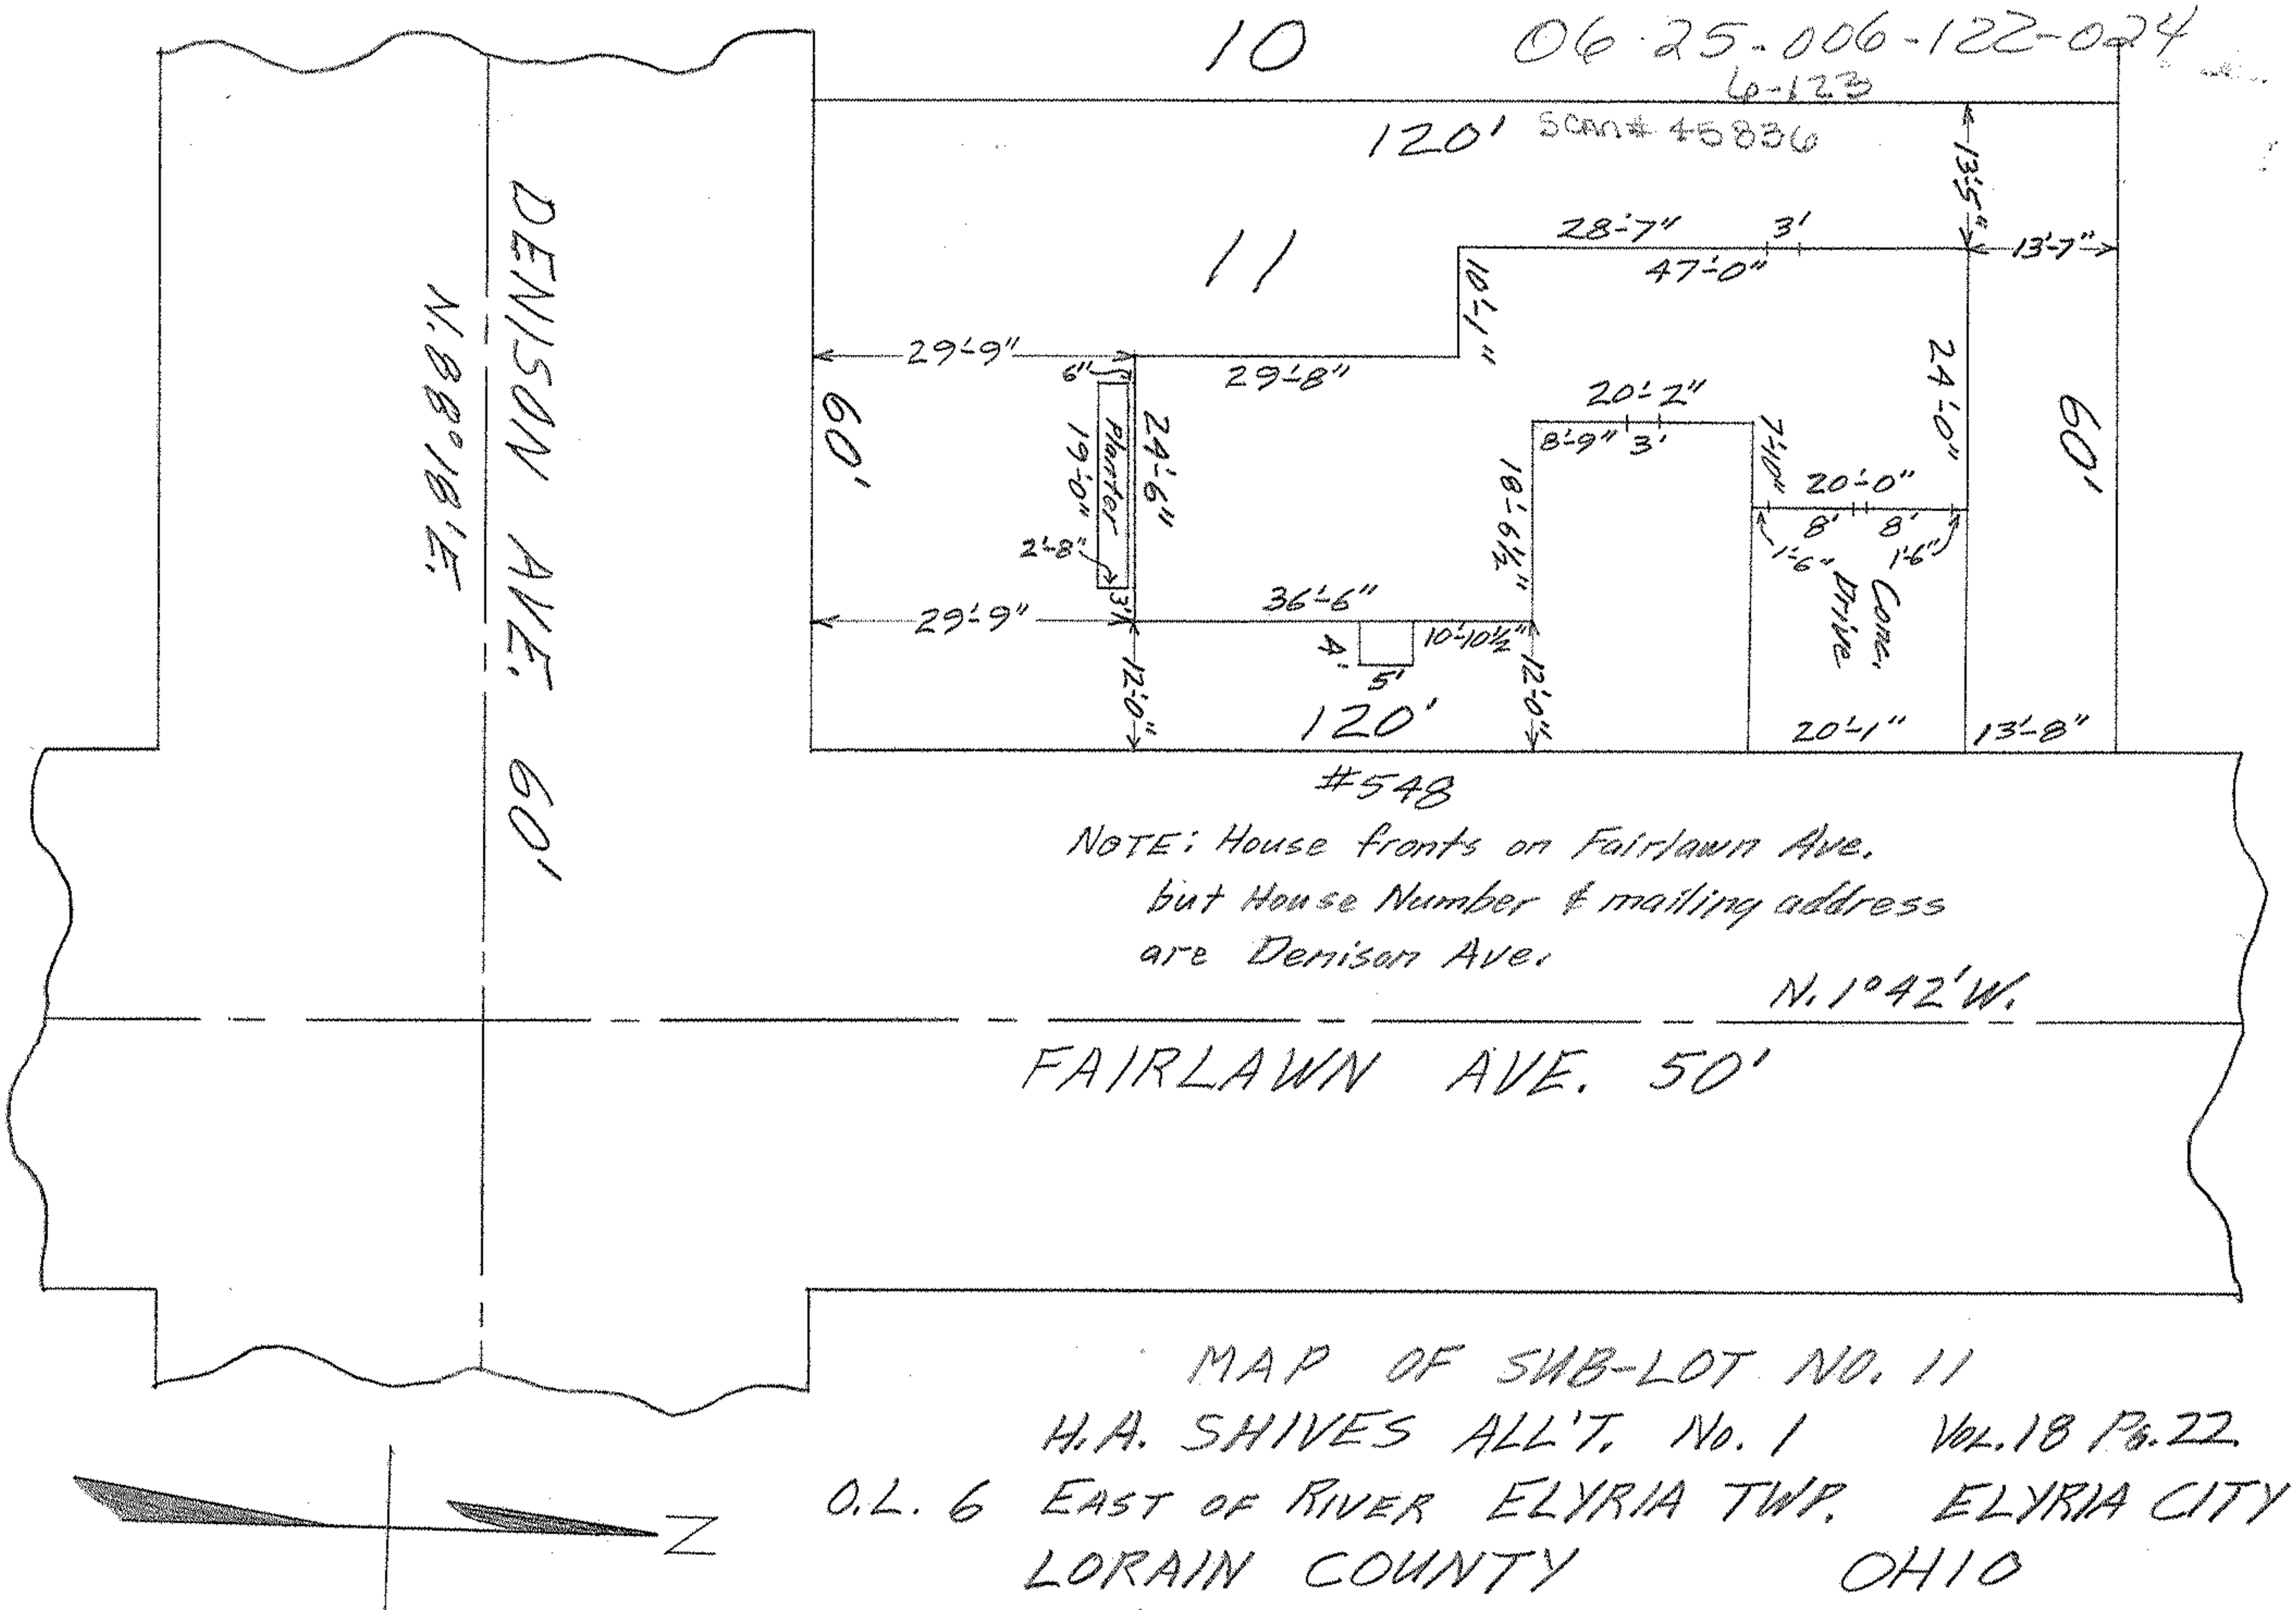

MAP OF SUB-LOT NO. 11

H.A. SHIVES ALL'T. No. 1 VOL. 18 PG. 22

O.L. 6 EAST OF RIVER ELYRIA TWP. ELYRIA CITY

LORAIN COUNTY OHIO

SCALE: 1" = 20' AUG. 23-1963 5:00 P.M.

Gary E. Penfound REG. SURVEYOR

William L. & Margaret A. Fisher

WW