8930

6-125 06-25-007-000
6-126 06-25-008-000
7-00-047-A 07-00-047-000

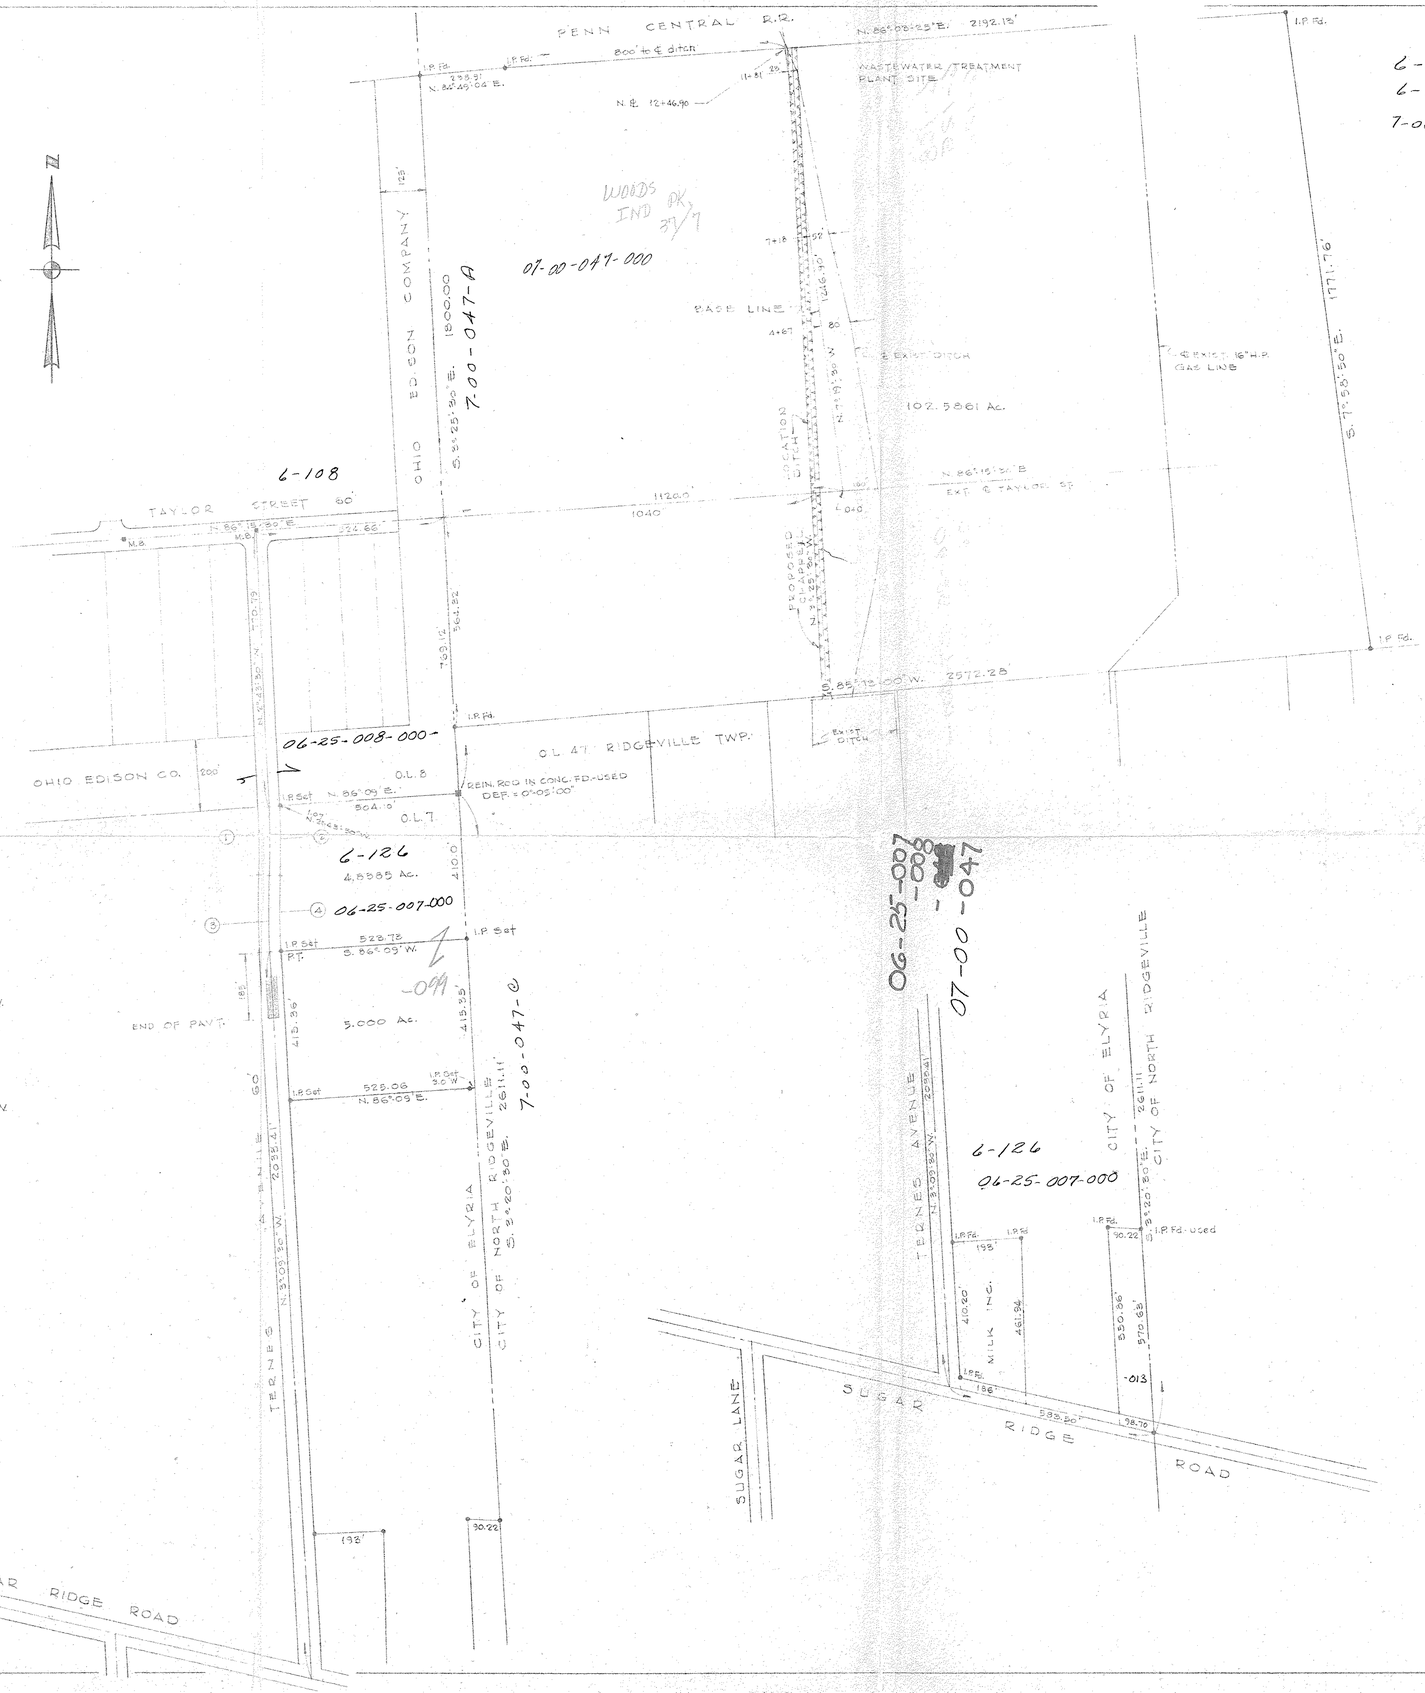

CURVE ①	CURVE ②
R = 2626.67'	R = 2656.67'
T = 102.52	A = 207.28'
A = 204.94'	C = 207.22'
C = 204.88'	Δ = 4°28'12"
Δ = 4°28'12"	C.B. N. 0°-29'-24" W.

CURVE ③	CURVE ④
R = 2394.48'	R = 2364.43'
T = 102.52'	A = 202.37'
A = 202.36'	C = 202.30'
C = 202.29'	Δ = 4°54'12"
Δ = 4°54'12"	C.B. N. 0°-22'-24" W.

LANDS OF

SOUTHGATE DEVELOPMENT CORPORATION

PART OF O.L.'s 7 & 8 EAST OF BLACK RIVER ELYRIA TOWNSHIP
PART OF O.L. 47 RIDGEVILLE TOWNSHIP
CITY OF ELYRIA AND NORTH RIDGEVILLE • LORAIN COUNTY • OHIO

SCALE 1" = 200' NOVEMBER 1974

LAUNDON • SIMON • CAHL & ASSOC.
ENGINEERS SURVEYORS

Job No. 74-281

JUL 11 1975

Township 47
ELYRIA PART OF O.L. 7 & 8
PART OF O.L. 47 RIDGEVILLE
06-25-007-008
07-00-047