06-25-014-105-016-019
6-105
6-105
N
Scan # 45059

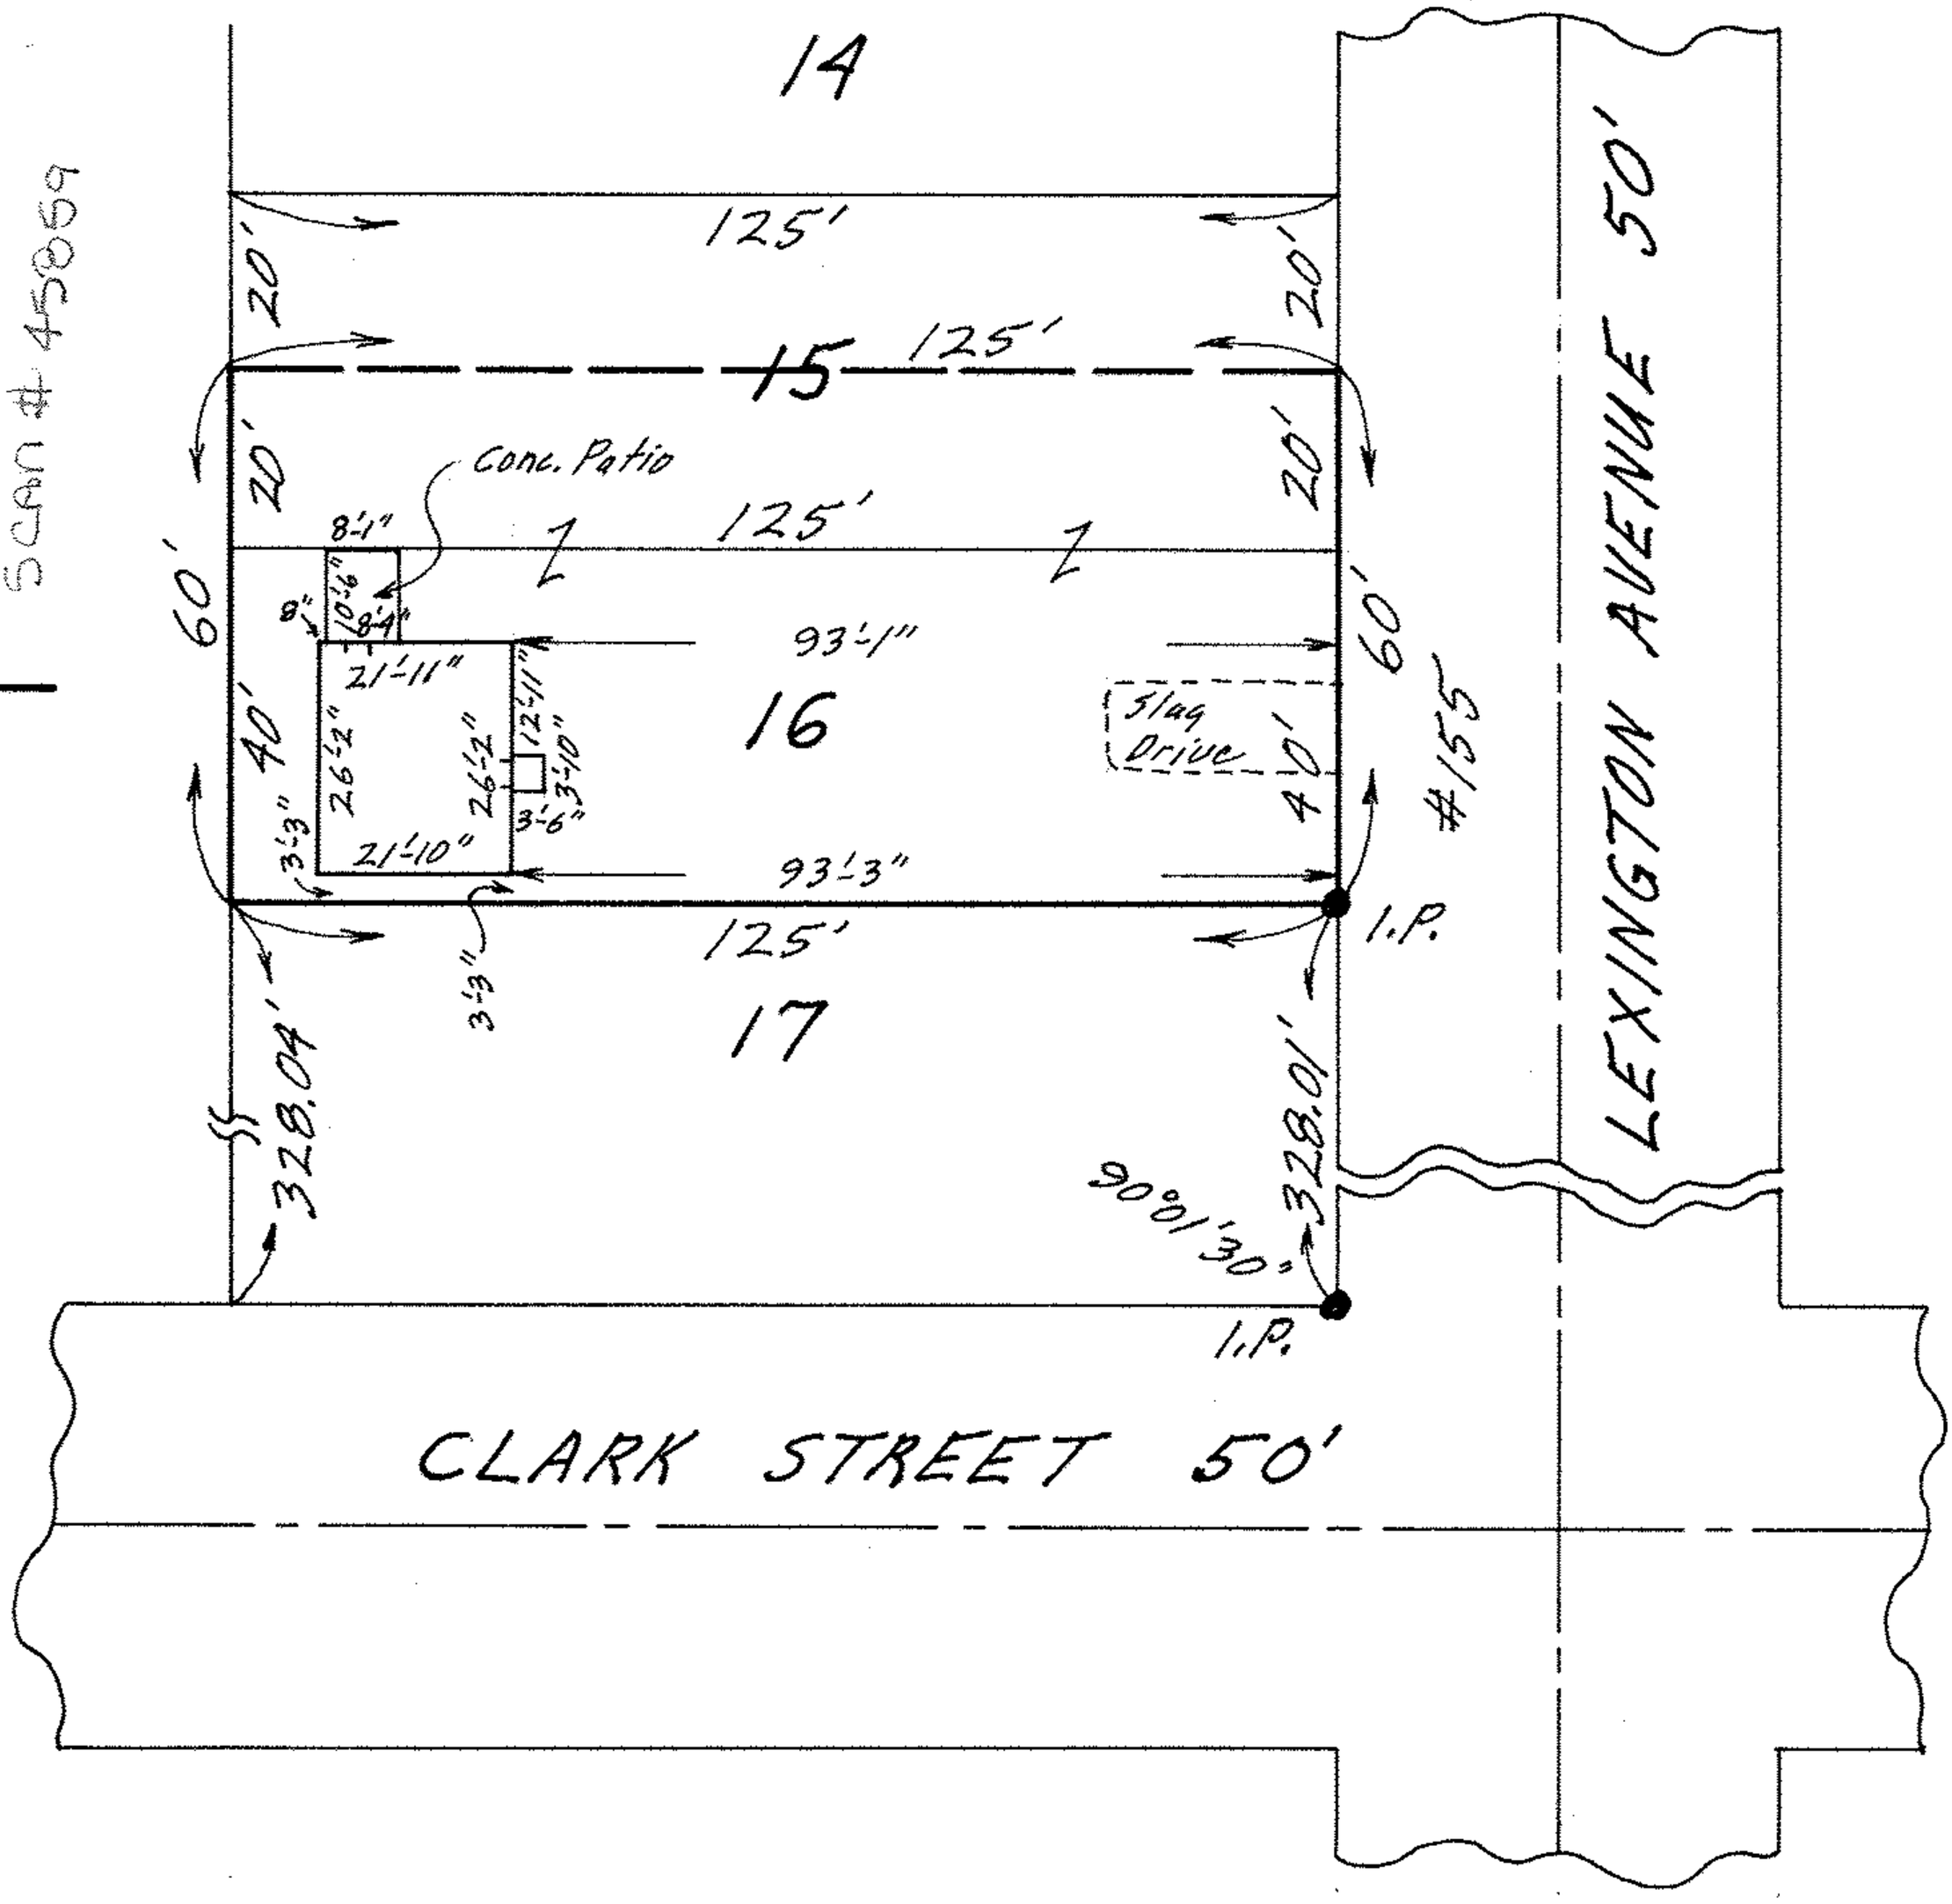

MAP OF SUB-LOT NO. 16 AND THE SOUTHERLY 20 FEET OF SUB-LOT NO. 15 OF THE BROADVIEW ALL'T.

VOL. 9 PG. 19 PLAT RECORDS

ORIG. LOT 1A - EAST OF RIVER - ELYRIA TWP.

ELYRIA CITY - LORAIN COUNTY - OHIO

SCALE: 1"=30' MAY 27-1971 6:30 P.M.

NOTE: There are no encroachments on this property.

Gary E. Penfound Reg. Surveyor No. 4457

THE TITLE INSURANCE COMPANY OF MINNESOTA