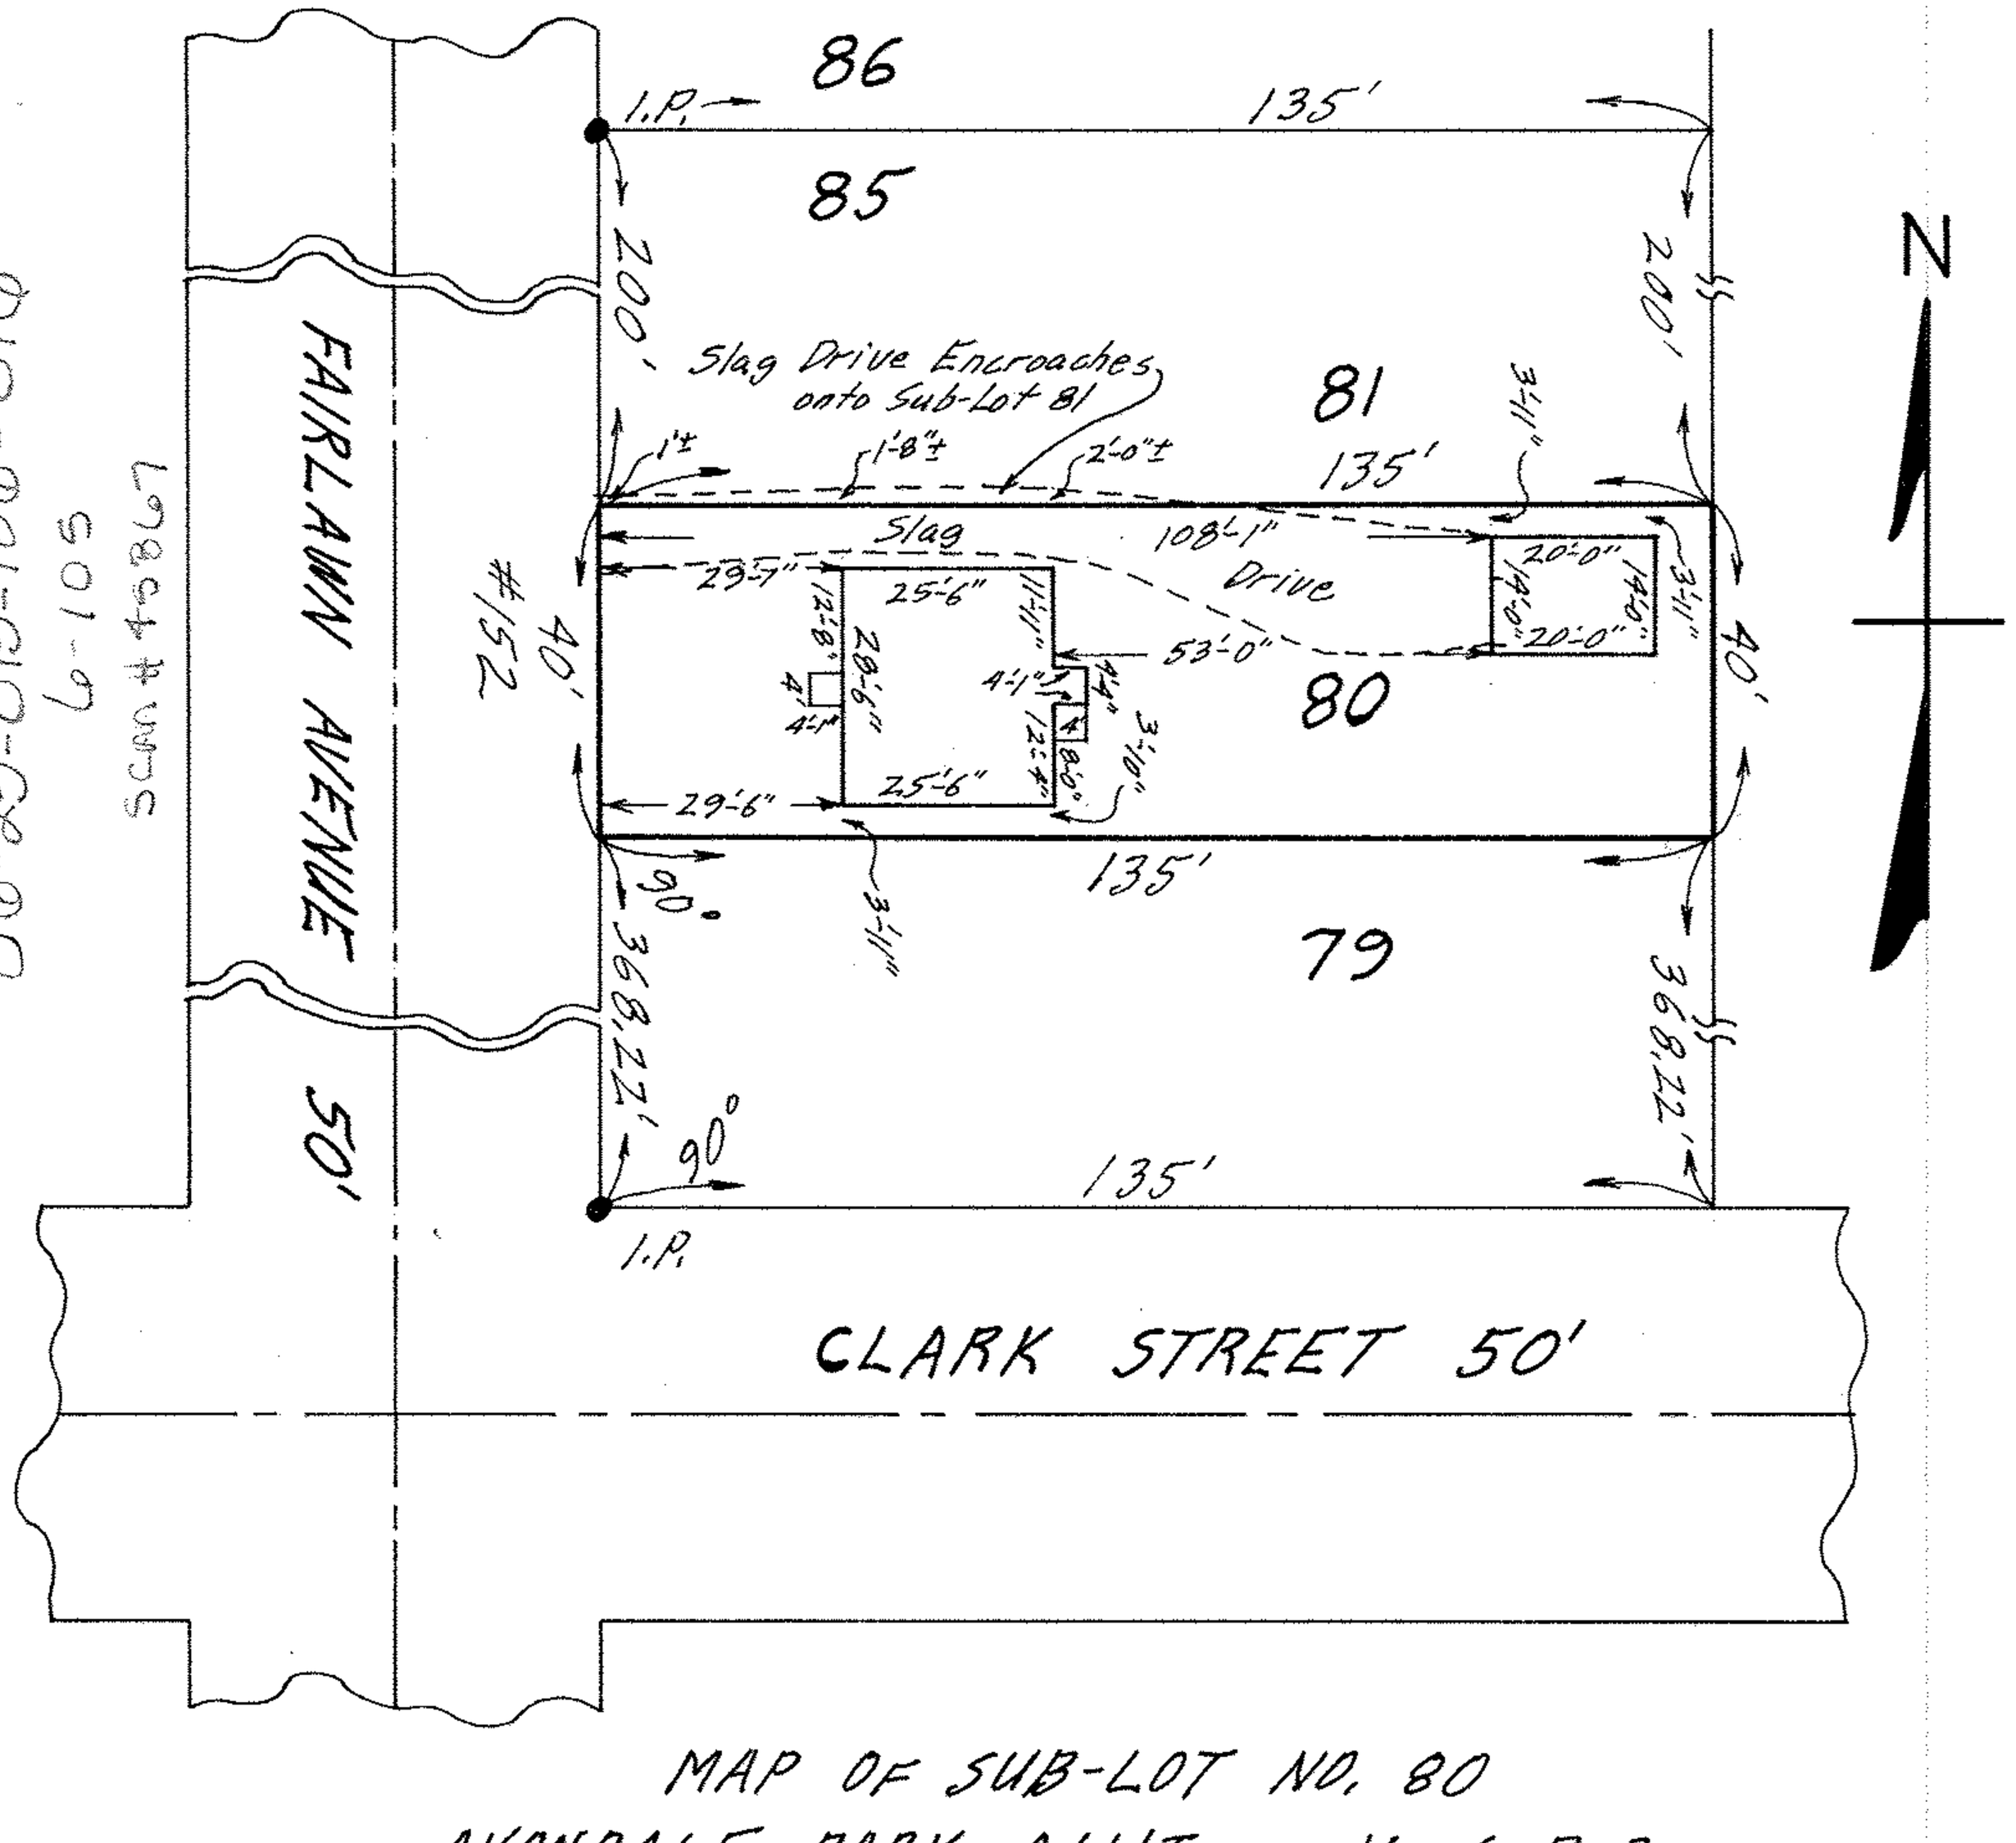

CLARK STREET 50'

MAP OF SUB-LOT NO. 80

AVONDALE PARK ALL'T. VOL. 6 PG. 2

ORIG. LOT 15 - EAST OF BLACK RIVER - ELYRIA TWP.

ELYRIA CITY LORAIN COUNTY OHIO

SCALE: 1"=30' OCT. 17-1970 1:00 P.M.

NOTE: Slag drive located on S/L 80 encroaches onto S/L 81.

Gary E. Penfound REG. SURVEYOR NO. 4457

CITY TITLE CO. Order No. E-1330-1

Les Drage Realty Co., Inc.

to Wayne P. Short