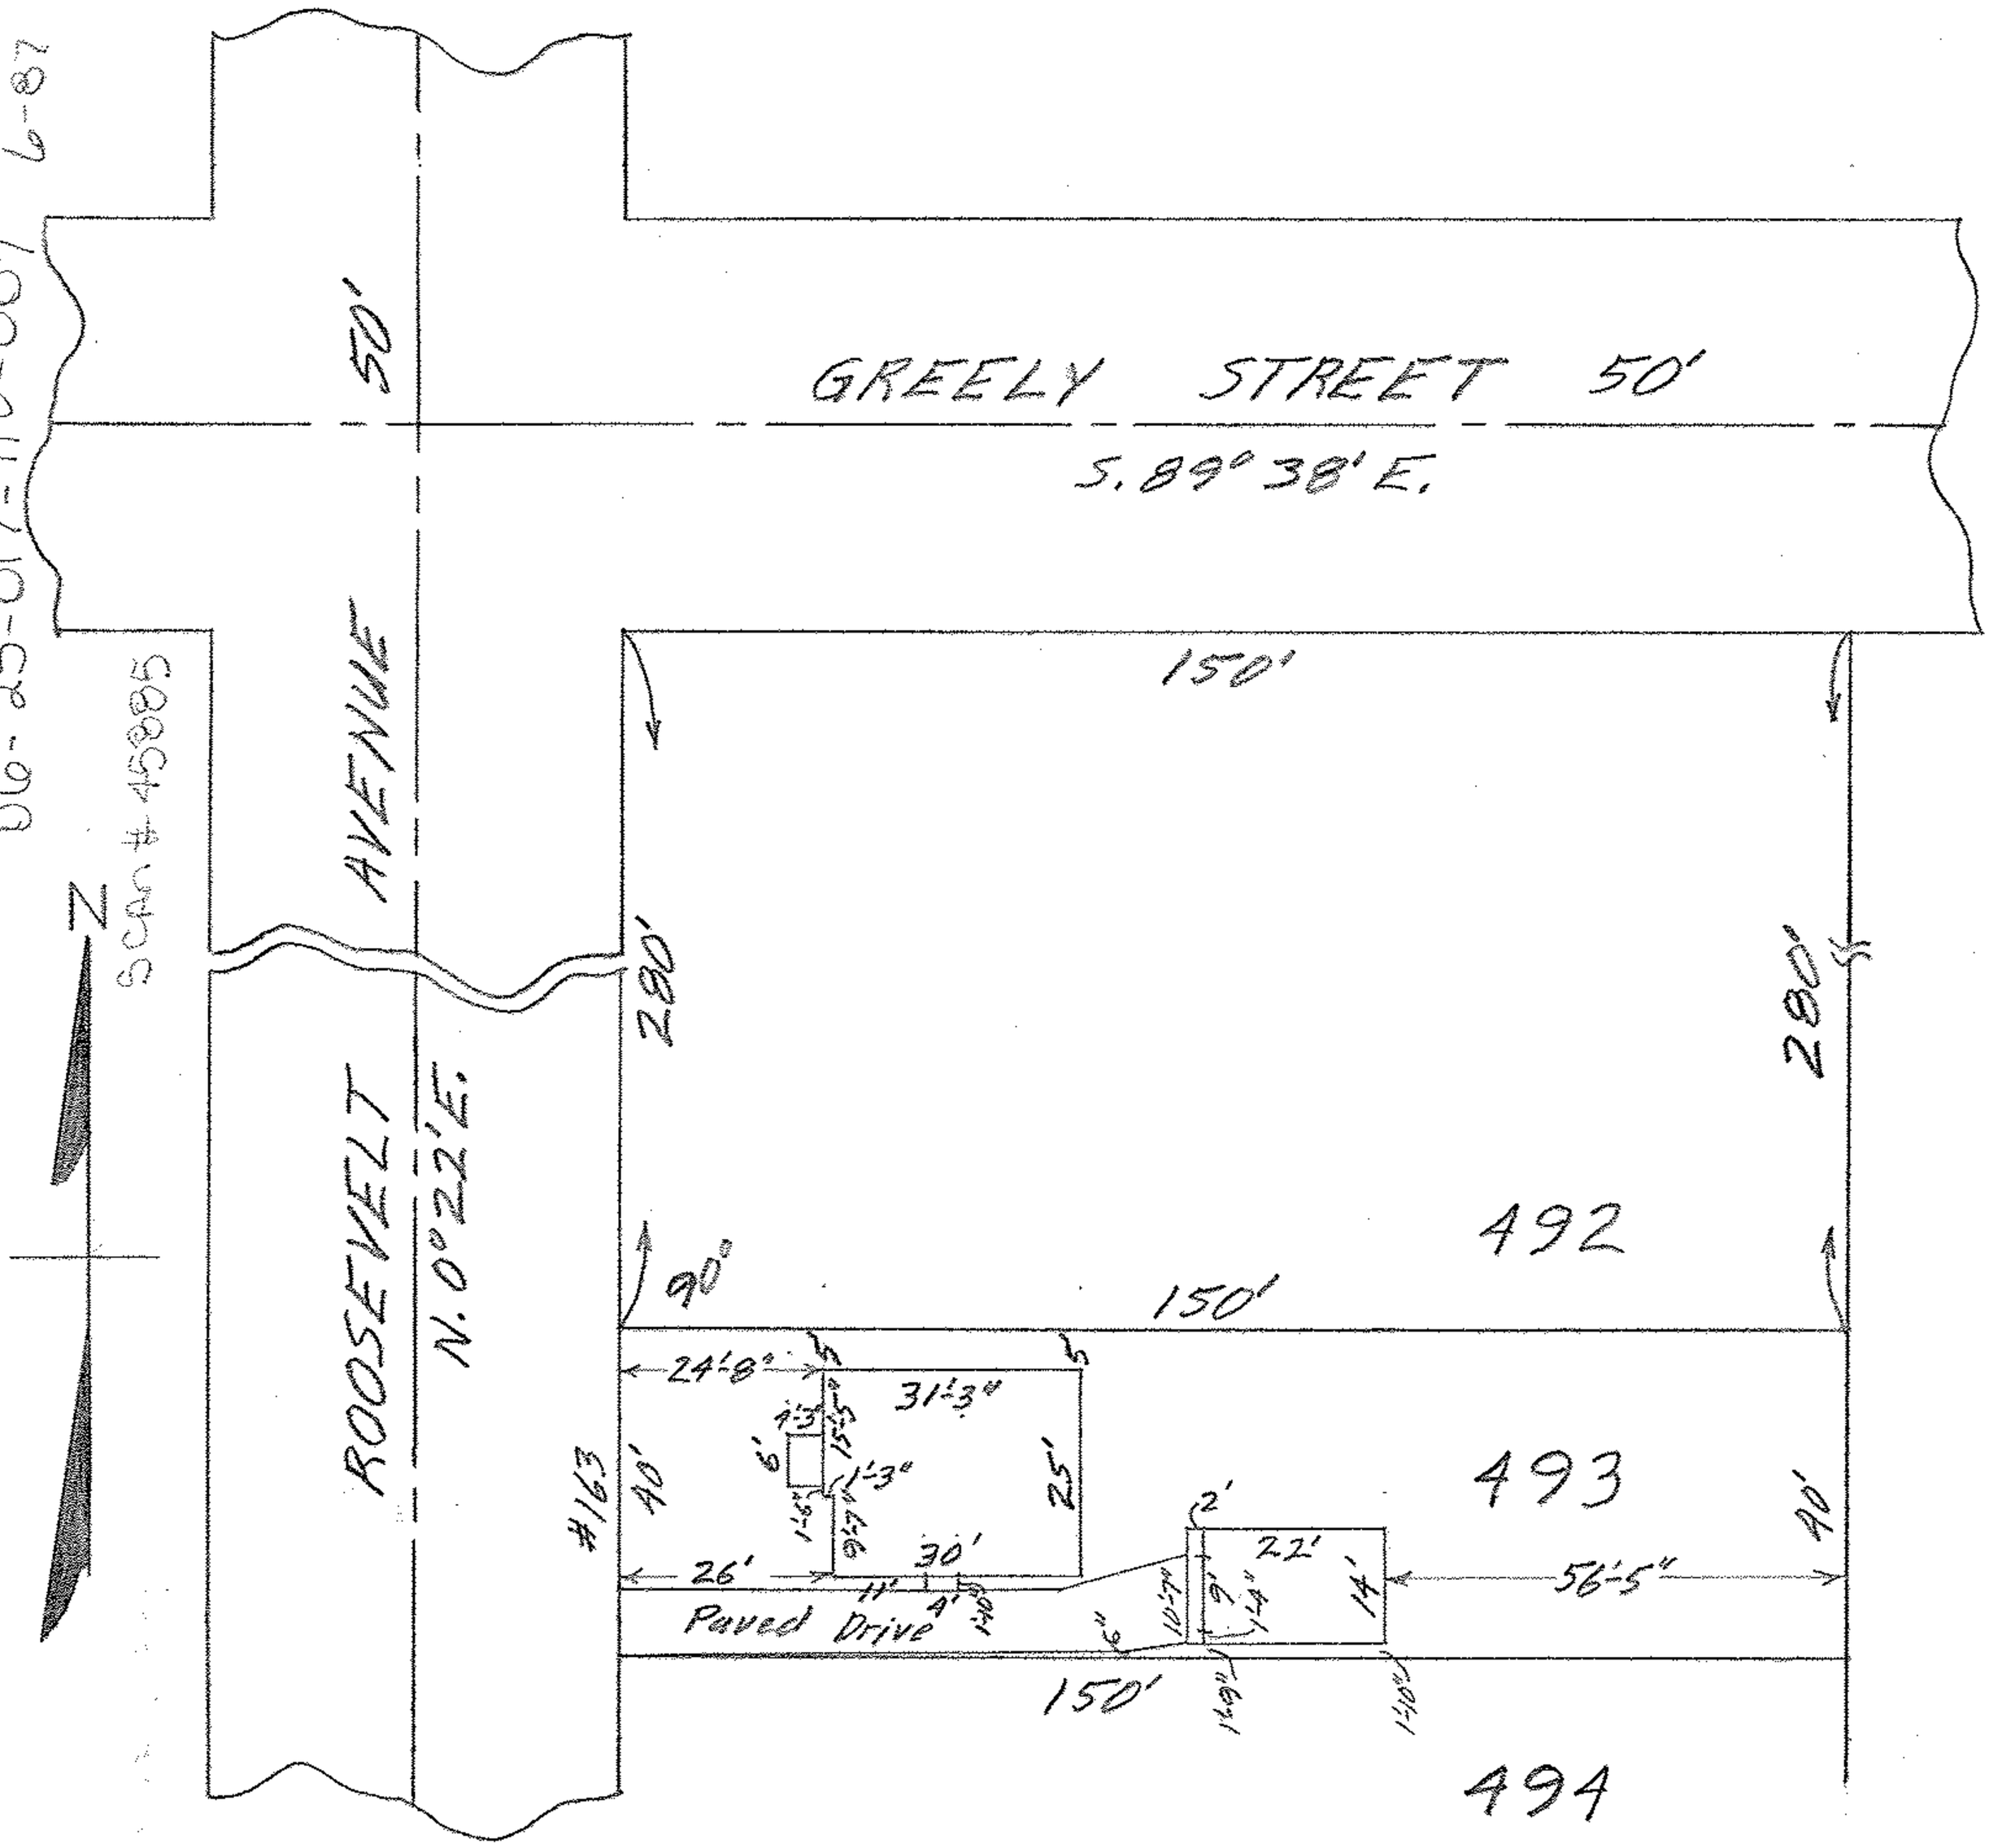

MAP OF SUB-LOT 493
PASADENA PARK ALL'T. VOL. 10 PG. 7 PLATS
ELYRIA CITY ELYRIA TOWNSHIP
LORAIN COUNTY OHIO
SCALE: 1"=30' AUG. 1-1960 3:45 P.M.
Gary E. Perfound REG. SURVEYOR

P.O. George R. & Ellen Wissinger WW

Made for and at the instance of The Ohio Bar Title Insurance Co. and The Broadview Savings & Loan Co.