MAP OF SUB-LOT NO. 64 AND THE SOUTHERLY 4 FEET OF SUB-LOT NO. 63 OF BELLFIELD PARK ALLOTMENT
VOL. 8 PGS. 35 & 36 PLATS ORIG. LOT 18 - EAST OF BLACK RIVER
ELYRIA TWP. - ELYRIA CITY - LORAIN COUNTY - OHIO
SCALE: 1"=30' JULY 10-1970 7:30 P.M.

NOTE: There are no encroachments on this property.

Gary E. Penfound
REG. SURVEYOR NO. 4457

Day to Trott

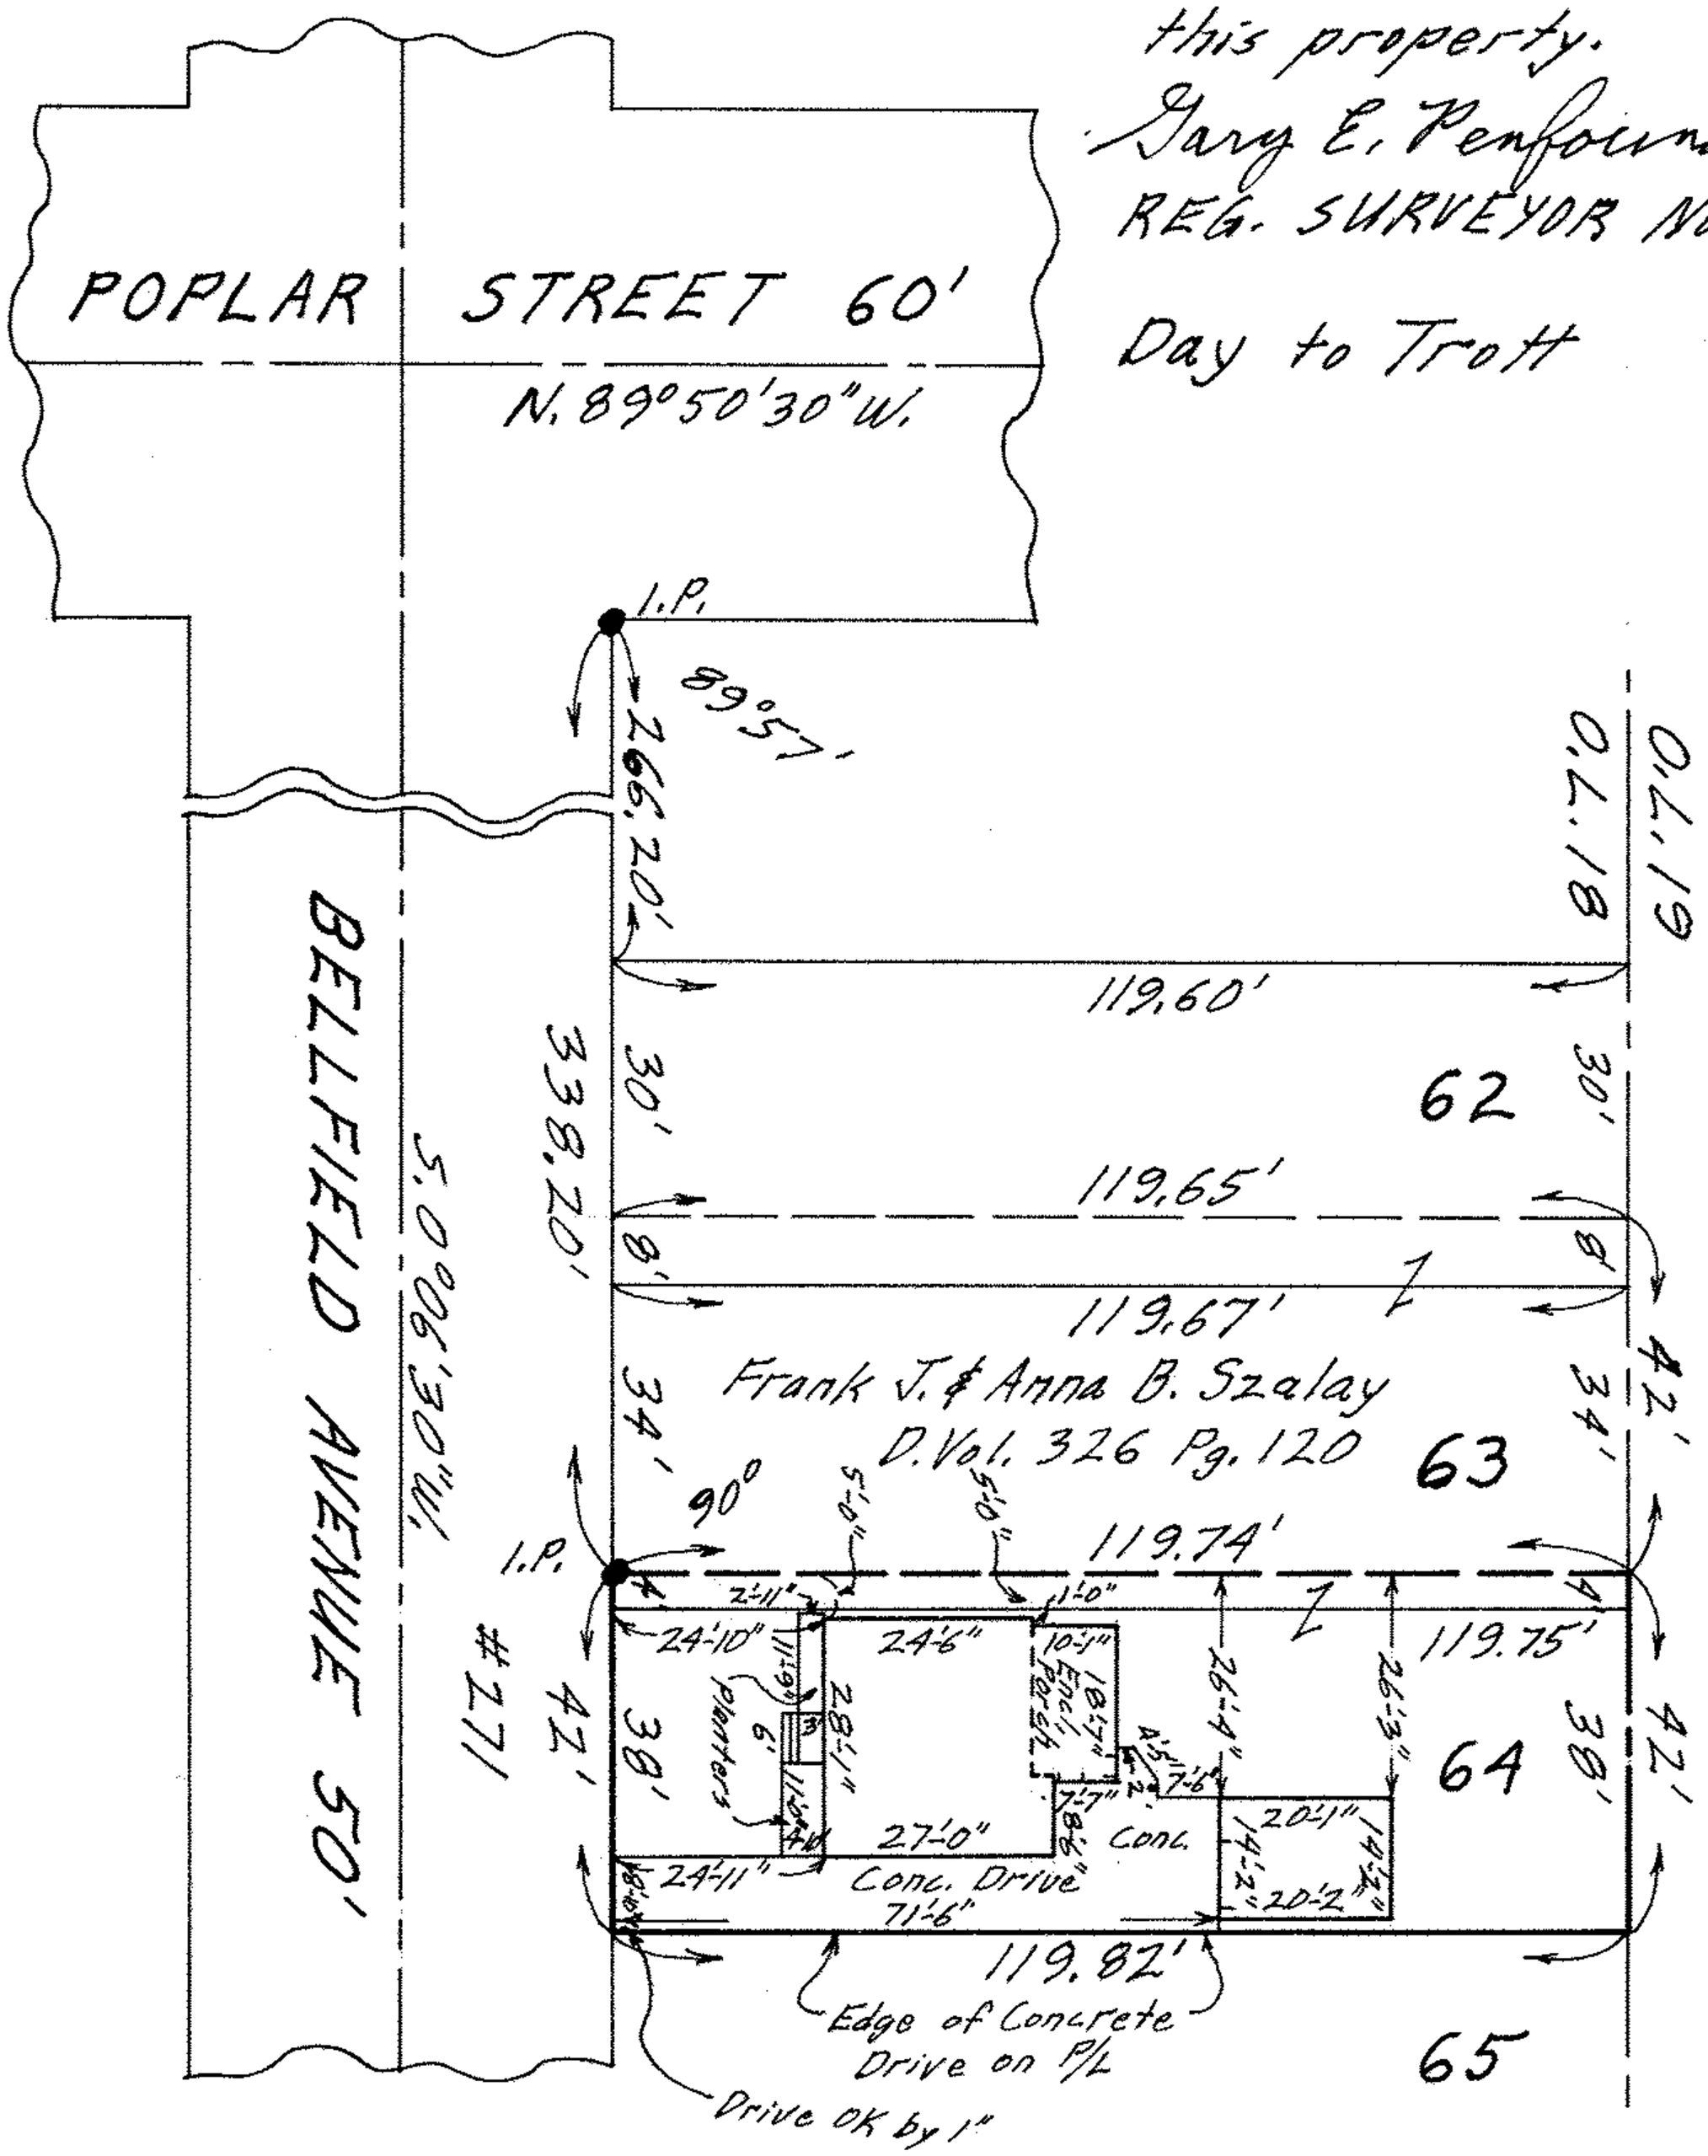

06-35-018-104-009
Scan # 45882
6-87

N