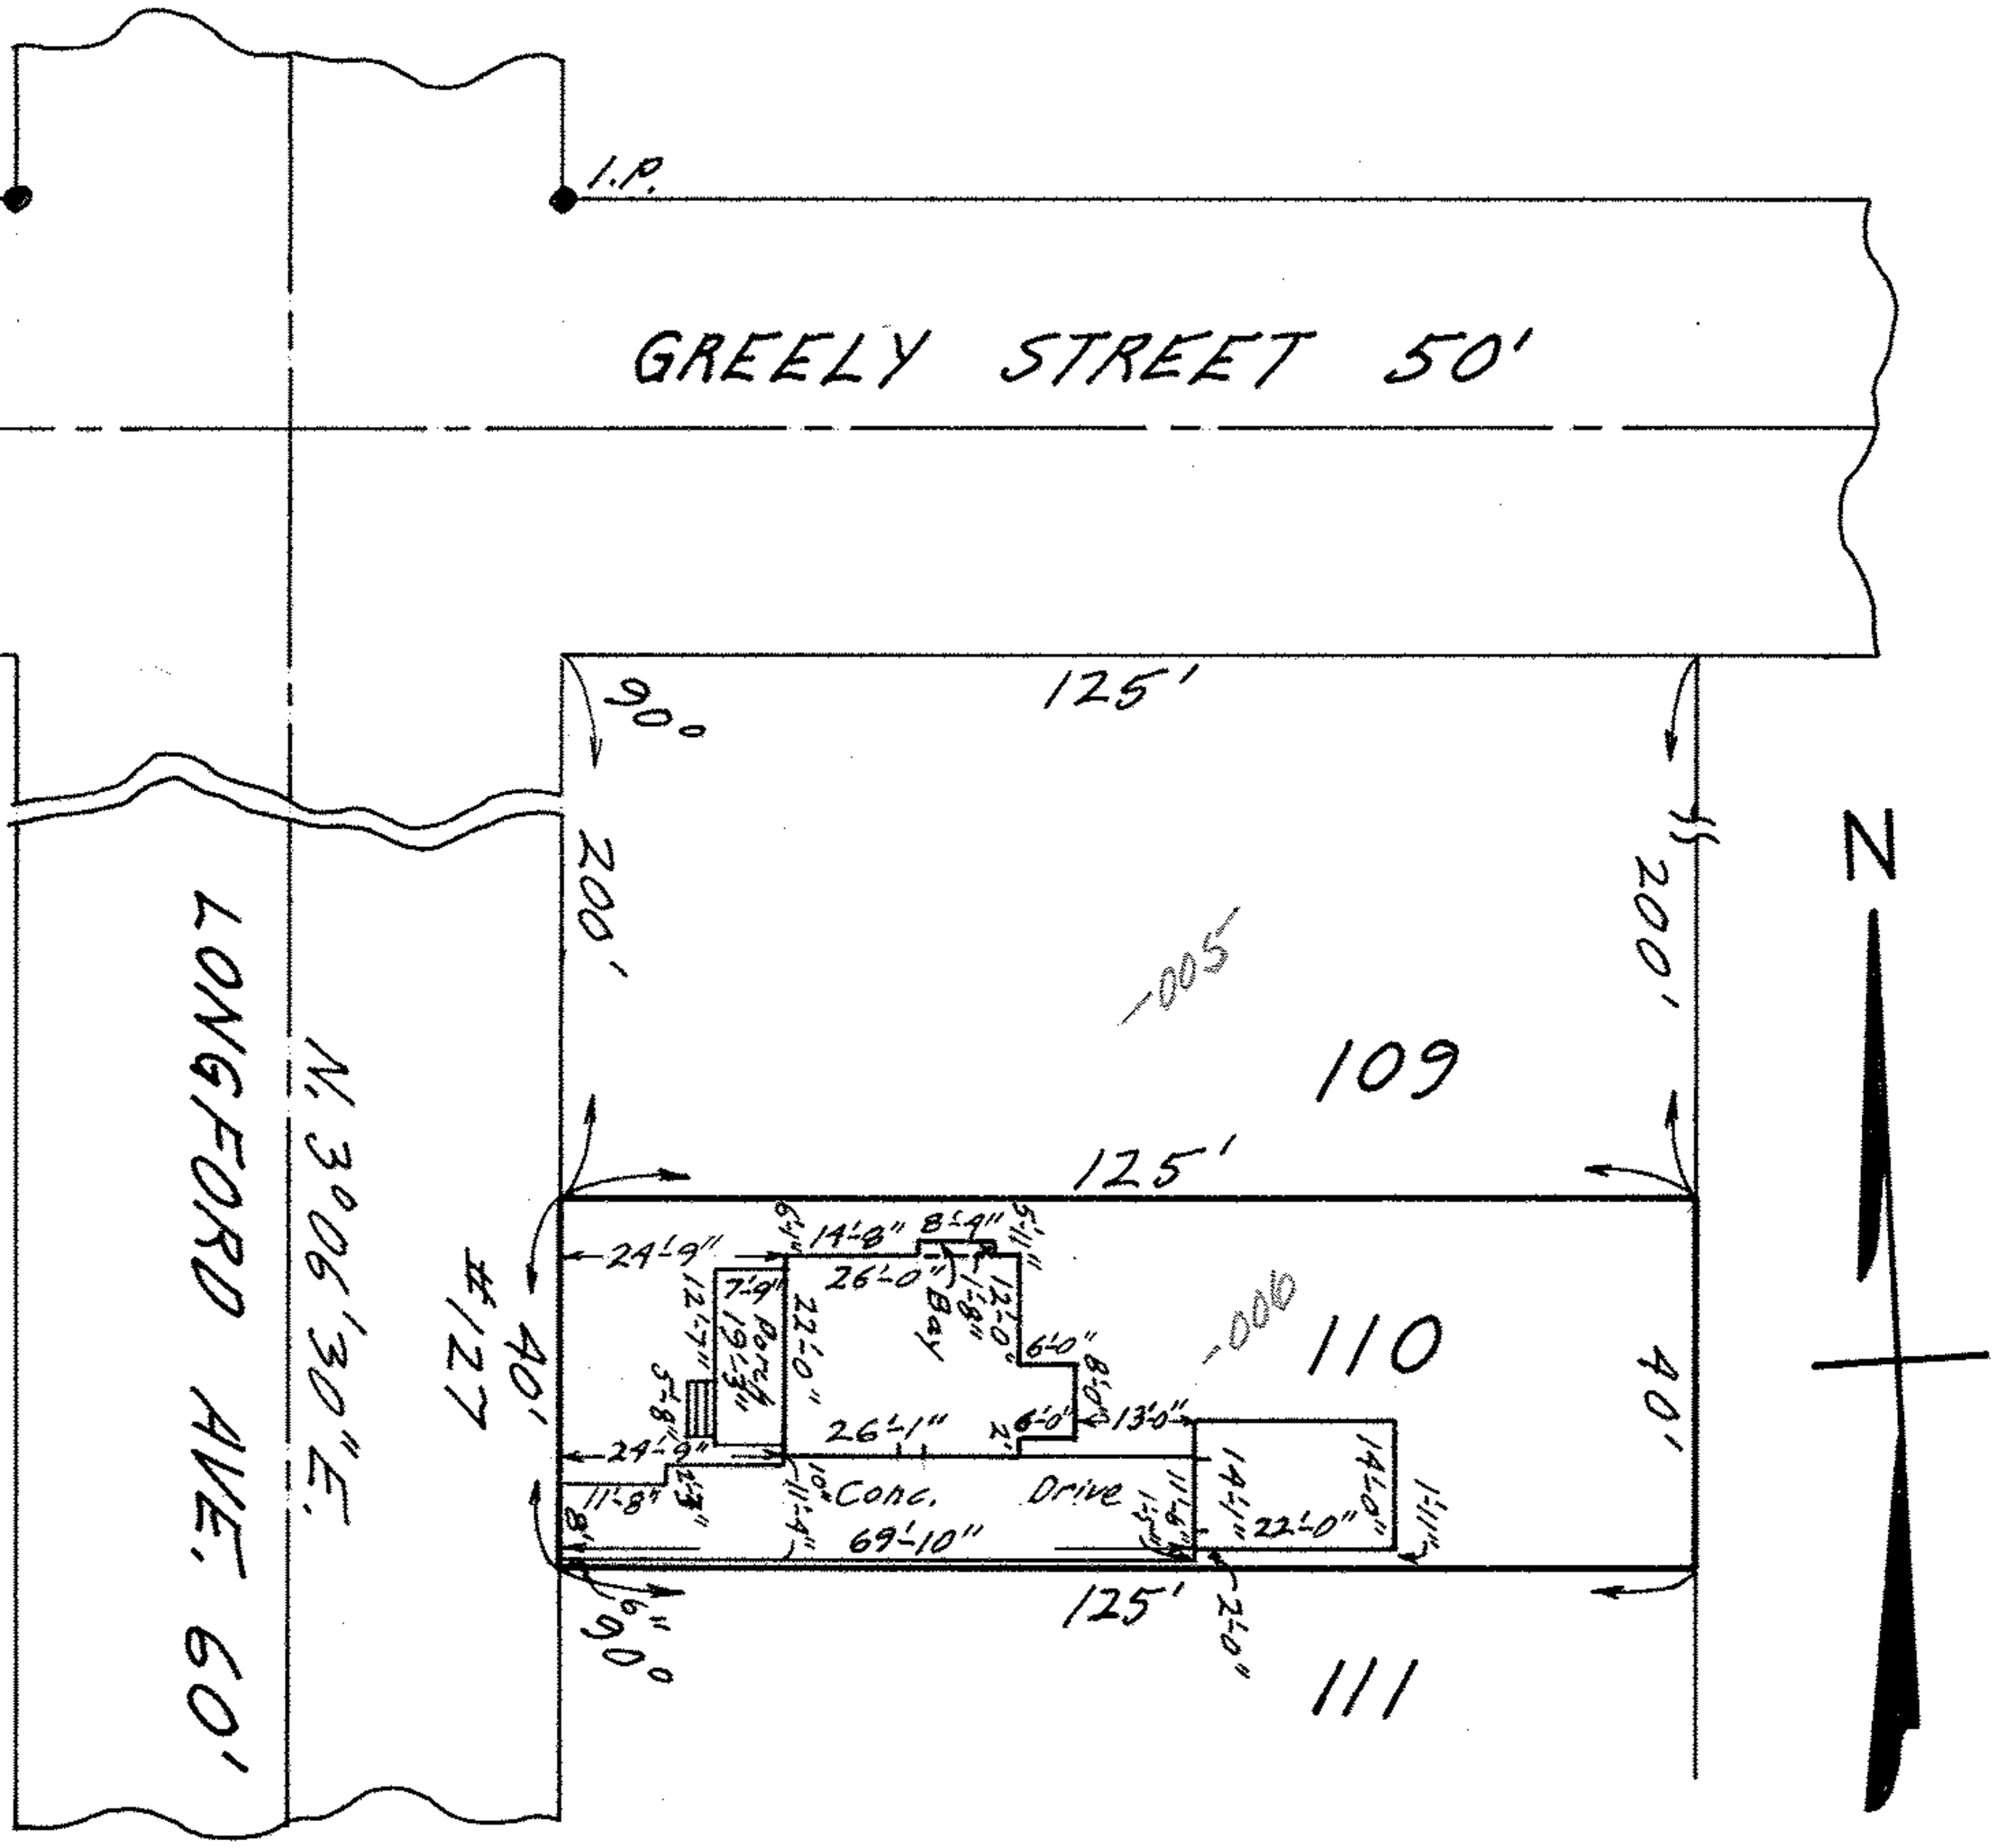

Old #5 Lincoln Park Allt. 60' Scan # 45881 6-87

MAP OF SUB-LOT NO. 110

THE LINCOLN PARK ALL'T. Vol. 9 Pg. 7 PLATS

ORIG. LOT 19 - EAST OF BLACK RIVER - ELYRIA TWP.

ELYRIA CITY - LORAIN COUNTY - OHIO

SCALE: 1"=30' AUG. 4-1969 8:00 P.M.

NOTE: There are no encroachments on the above property.

Gary E. Penfound REG. SURVEYOR NO. 4457

CITY TITLE Co. Order No. E-759-60

Robert Clyde to Ira Hissom