0625-027-105-071
6-53
Scan #45902

LIVERMORE AVE.

1" = 20'

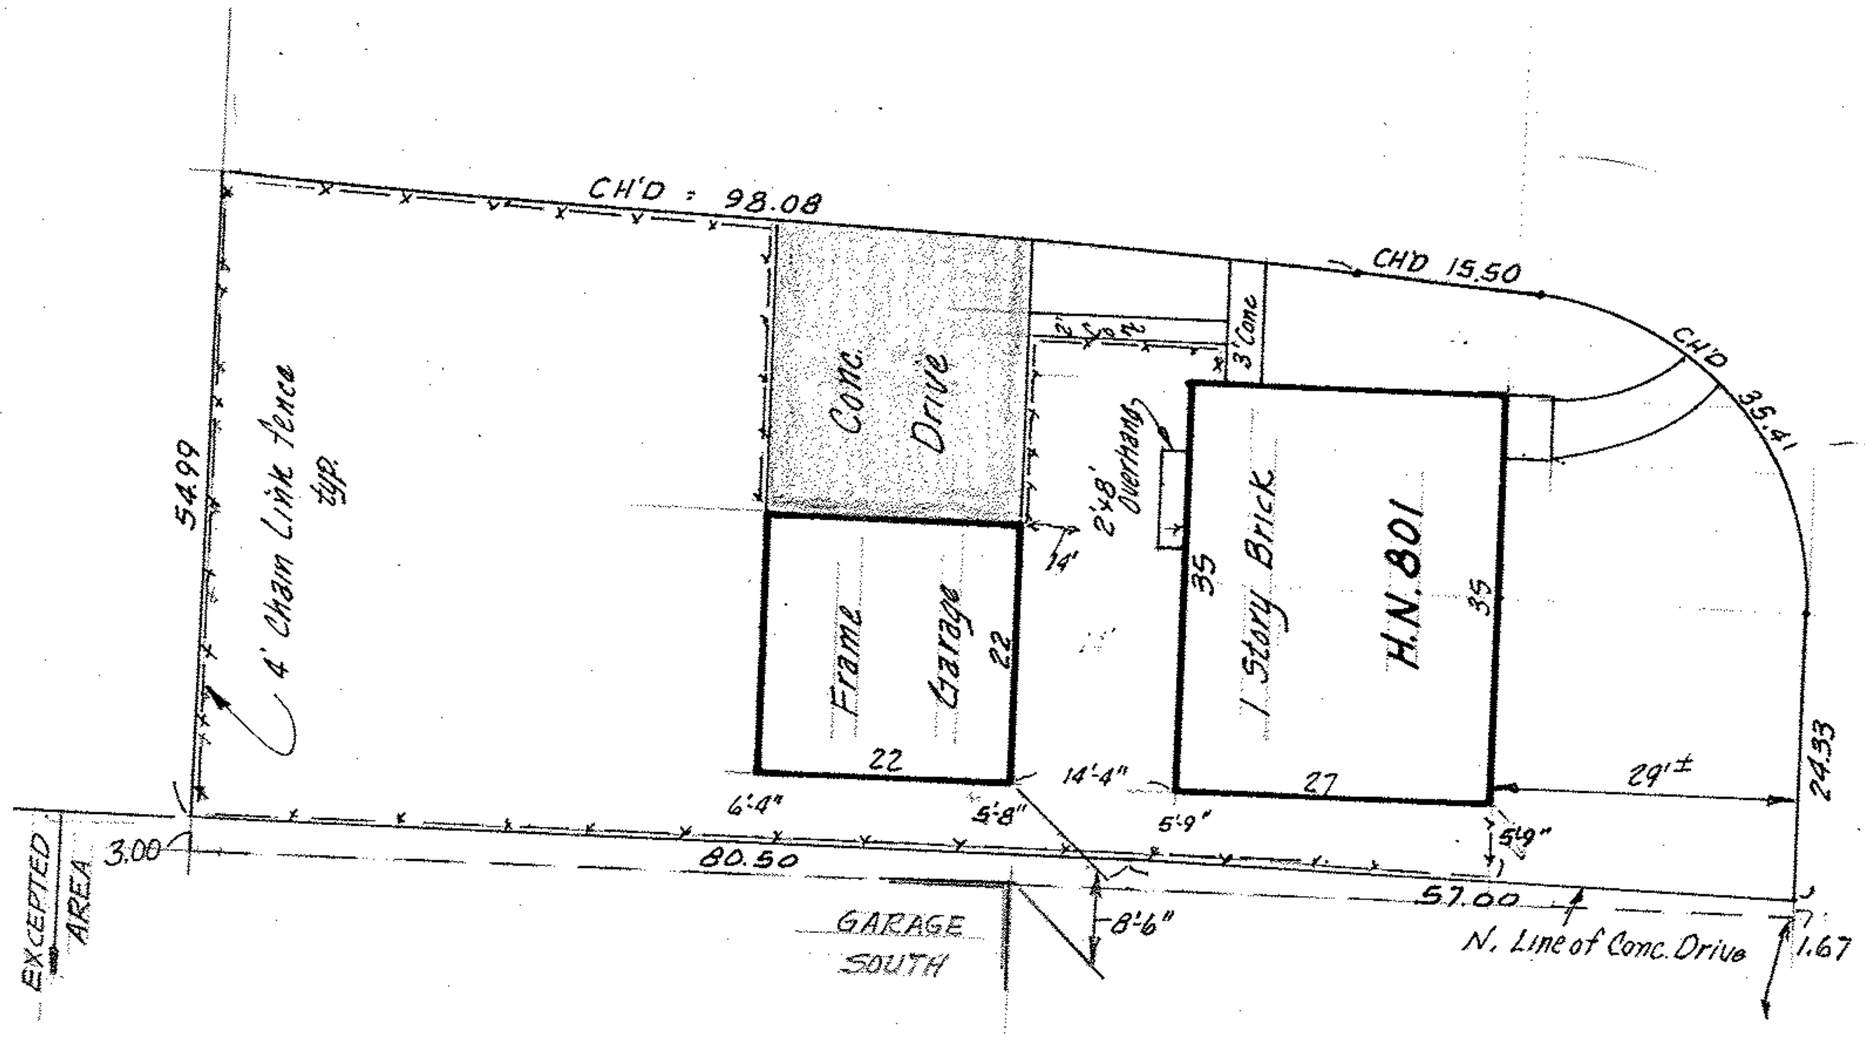


PART of
SUBLOT #32 of ABBE KNOLLS SUBDIVISION NO. 1

PLAT VOL. 23 PAGE 3
PART of ORIG. ELYRIA TWP. LOT 27 EAST of BLACK RIVER
NOW in CITY of ELYRIA , OHIO

THIS IS NOT A PLAT OF SURVEY:
FOR MORTGAGE LOAN PURPOSES ONLY

McGLINCHY & ASSOCIATES
JULY 18, 1978 #783679
7/26/78 ADDED DATA GREAT LAKES T.