06-25-022-102-017,018

Scan # 45910

6-71

N

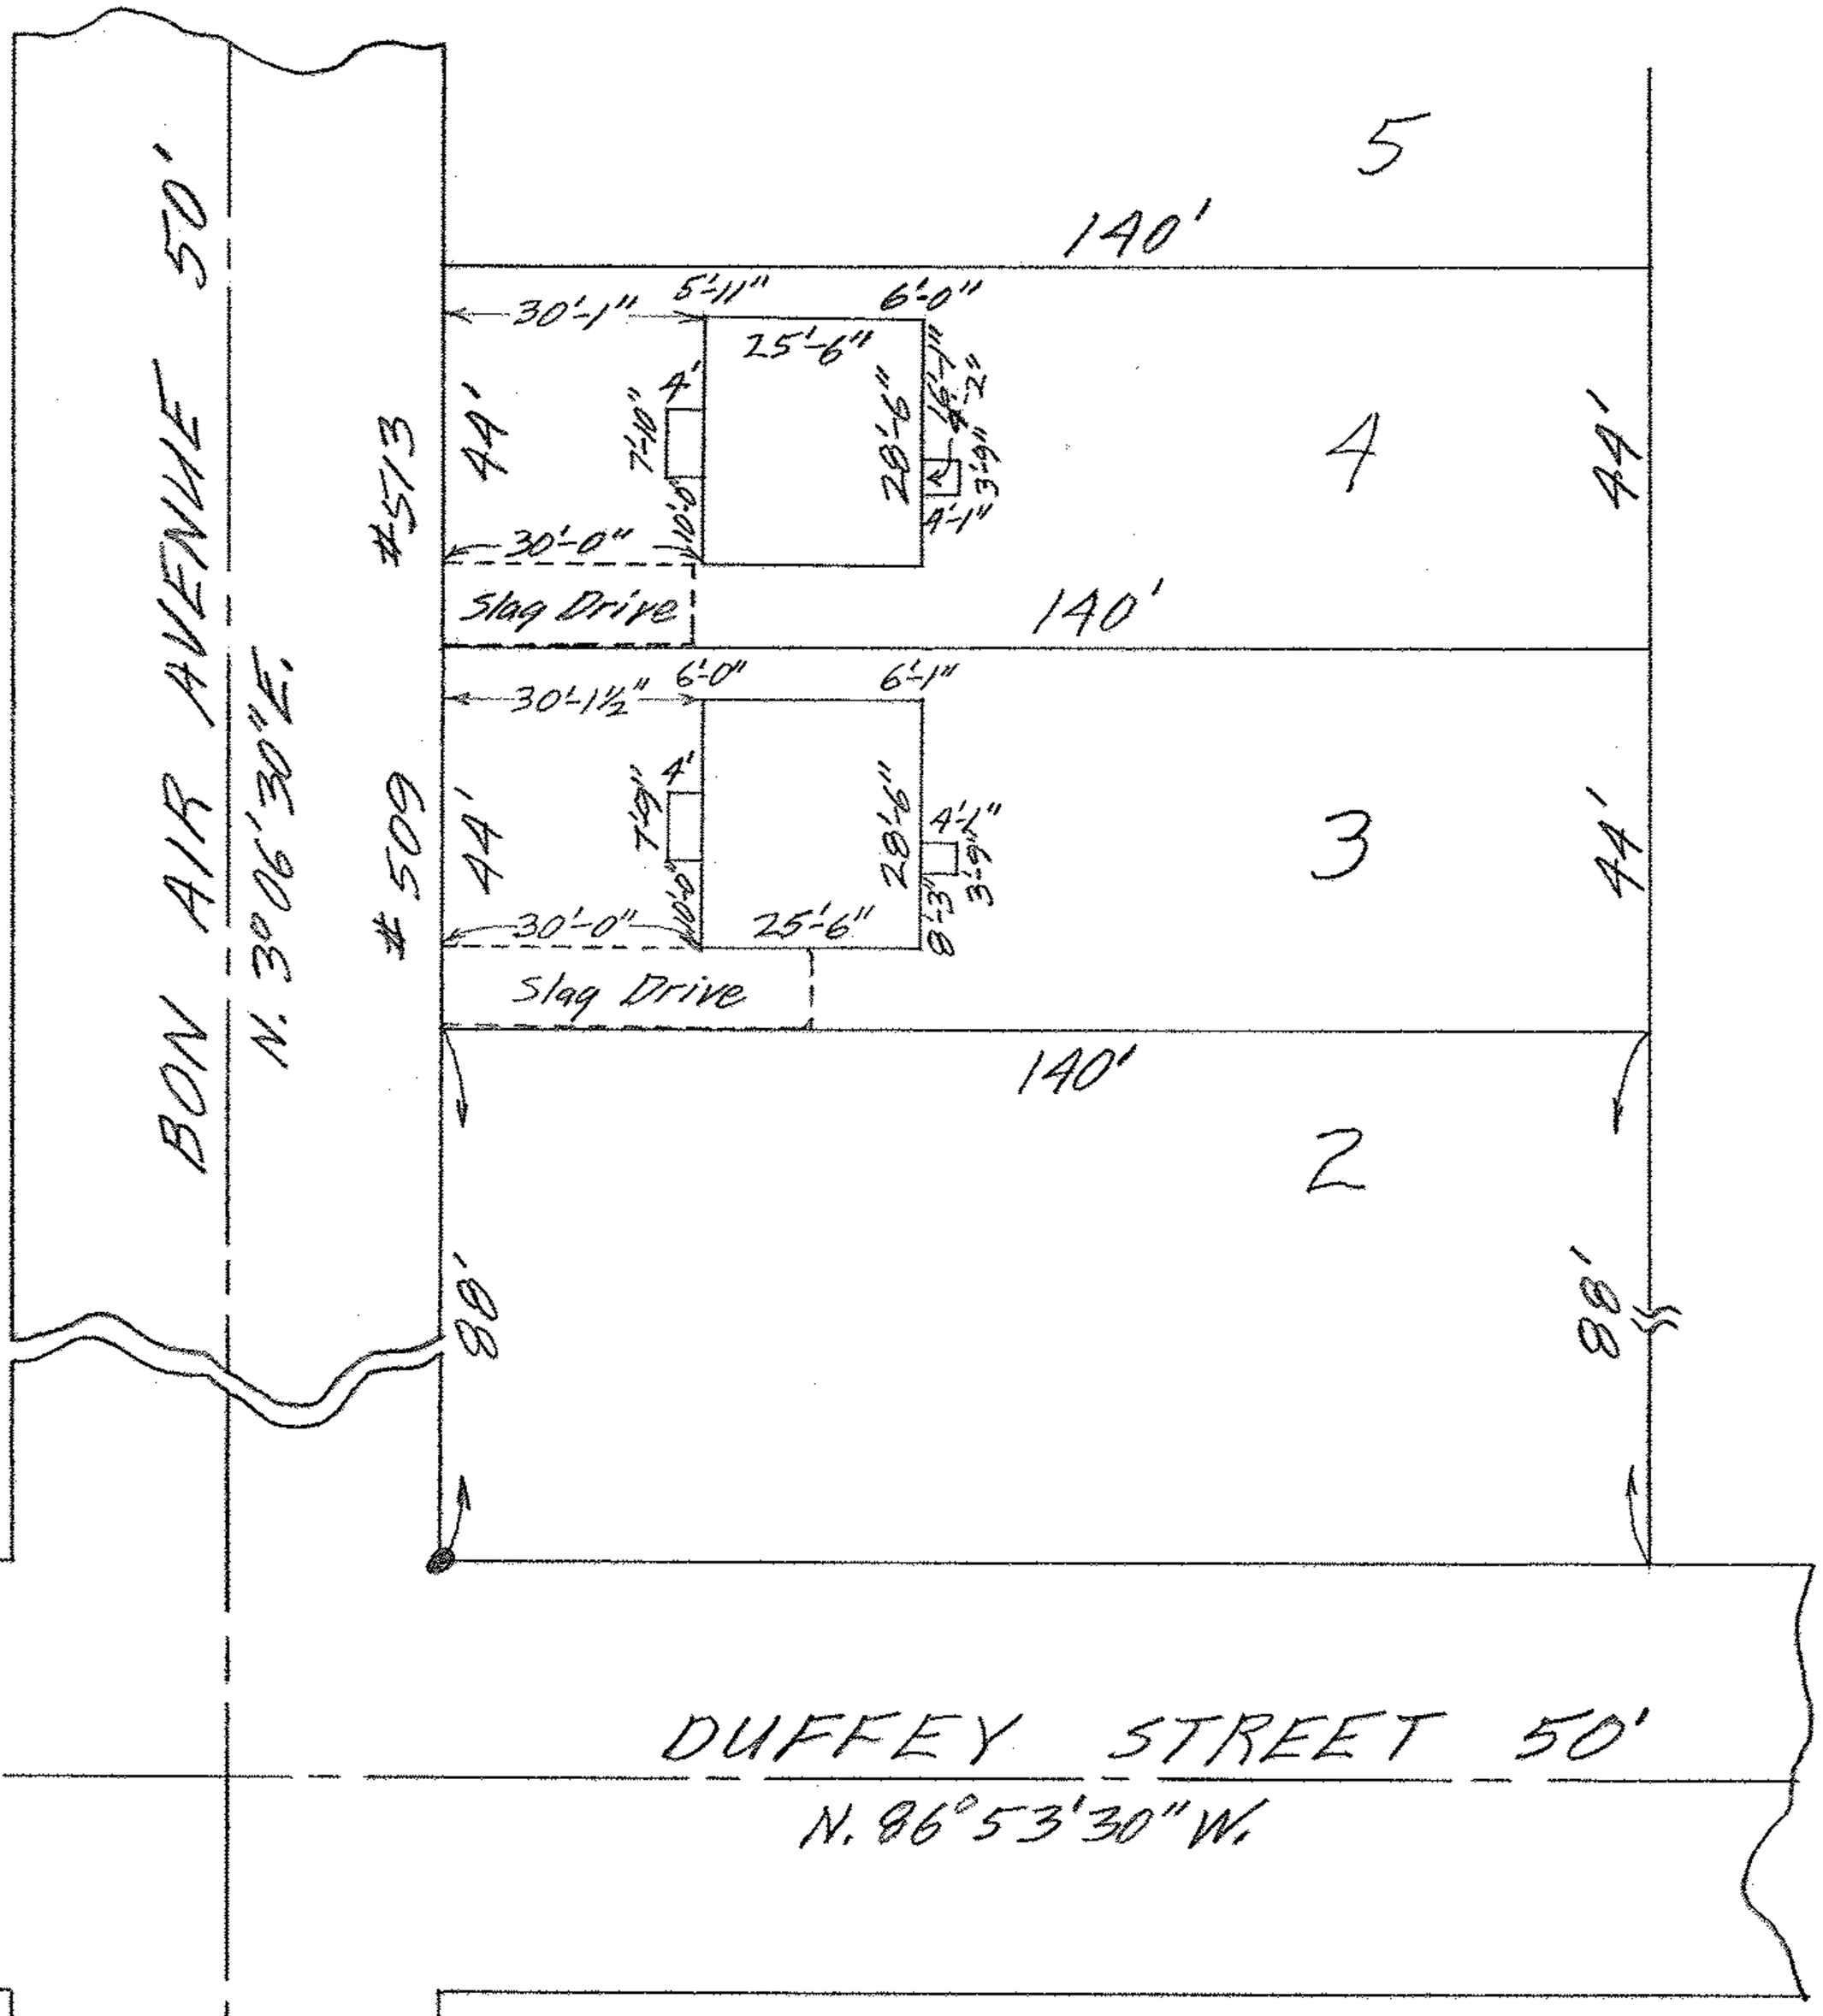

MAP OF SUB-LOT 3 BLOCK 44

CITY FARMS ALL'T. VOL. 9 PG. 3 PLATS

ELYRIA TWP. ELYRIA CITY

LORAIN COUNTY OHIO

SCALE: 1" = 30' JUNE 9-1962 1:15 P.M.

Gary E. Perfound REG. SURVEYOR

Earl Conner