06-25-022-102-034

6-11

Scan #45912

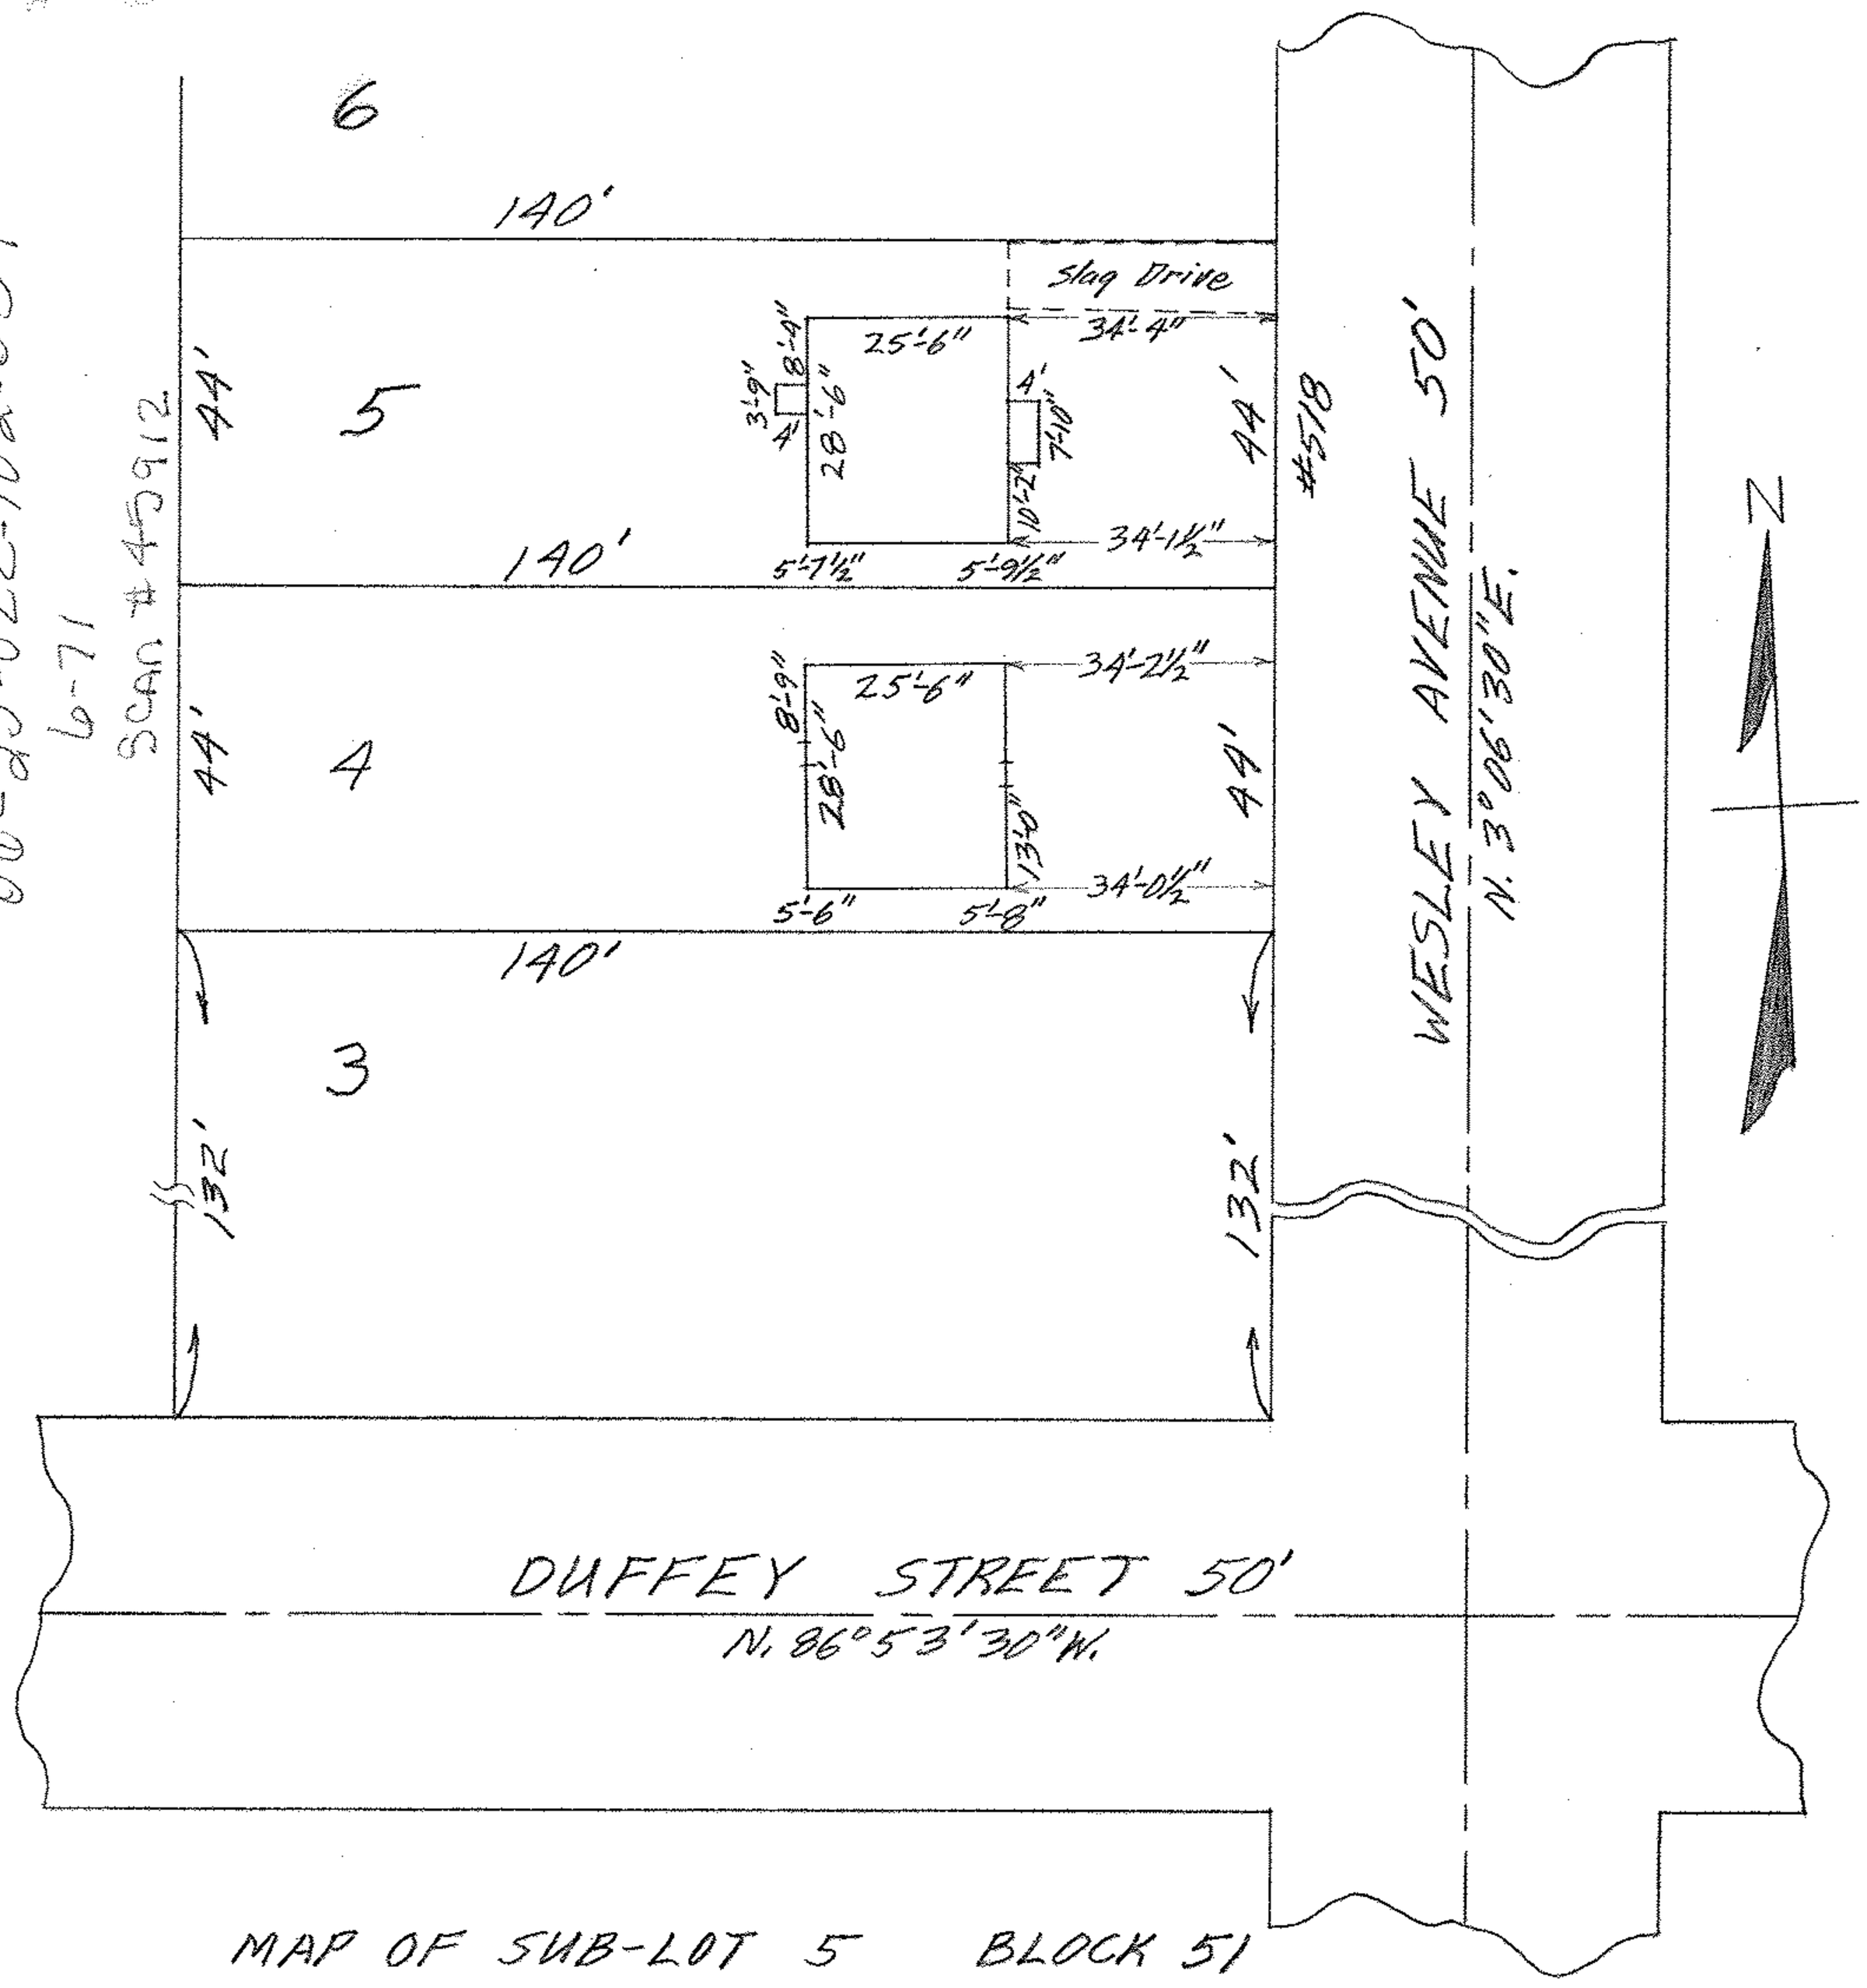

MAP OF SUB-LOT 5 BLOCK 51

CITY FARMS ALL'T. VOL. 9 PG. 3 PLATS

ELYRIA TOWNSHIP ELYRIA CITY

LORAIN COUNTY OHIO

SCALE: 1"=30' NOVEMBER 29-1961 9:15 A.M.

Gary E. Benfound REG. SURVEYOR

Lewis H. & Barbara J. O'Dell