


650-801-550-25-00

Roger J. & Helen L. Boythem D. Vol. 501 Pg. 534

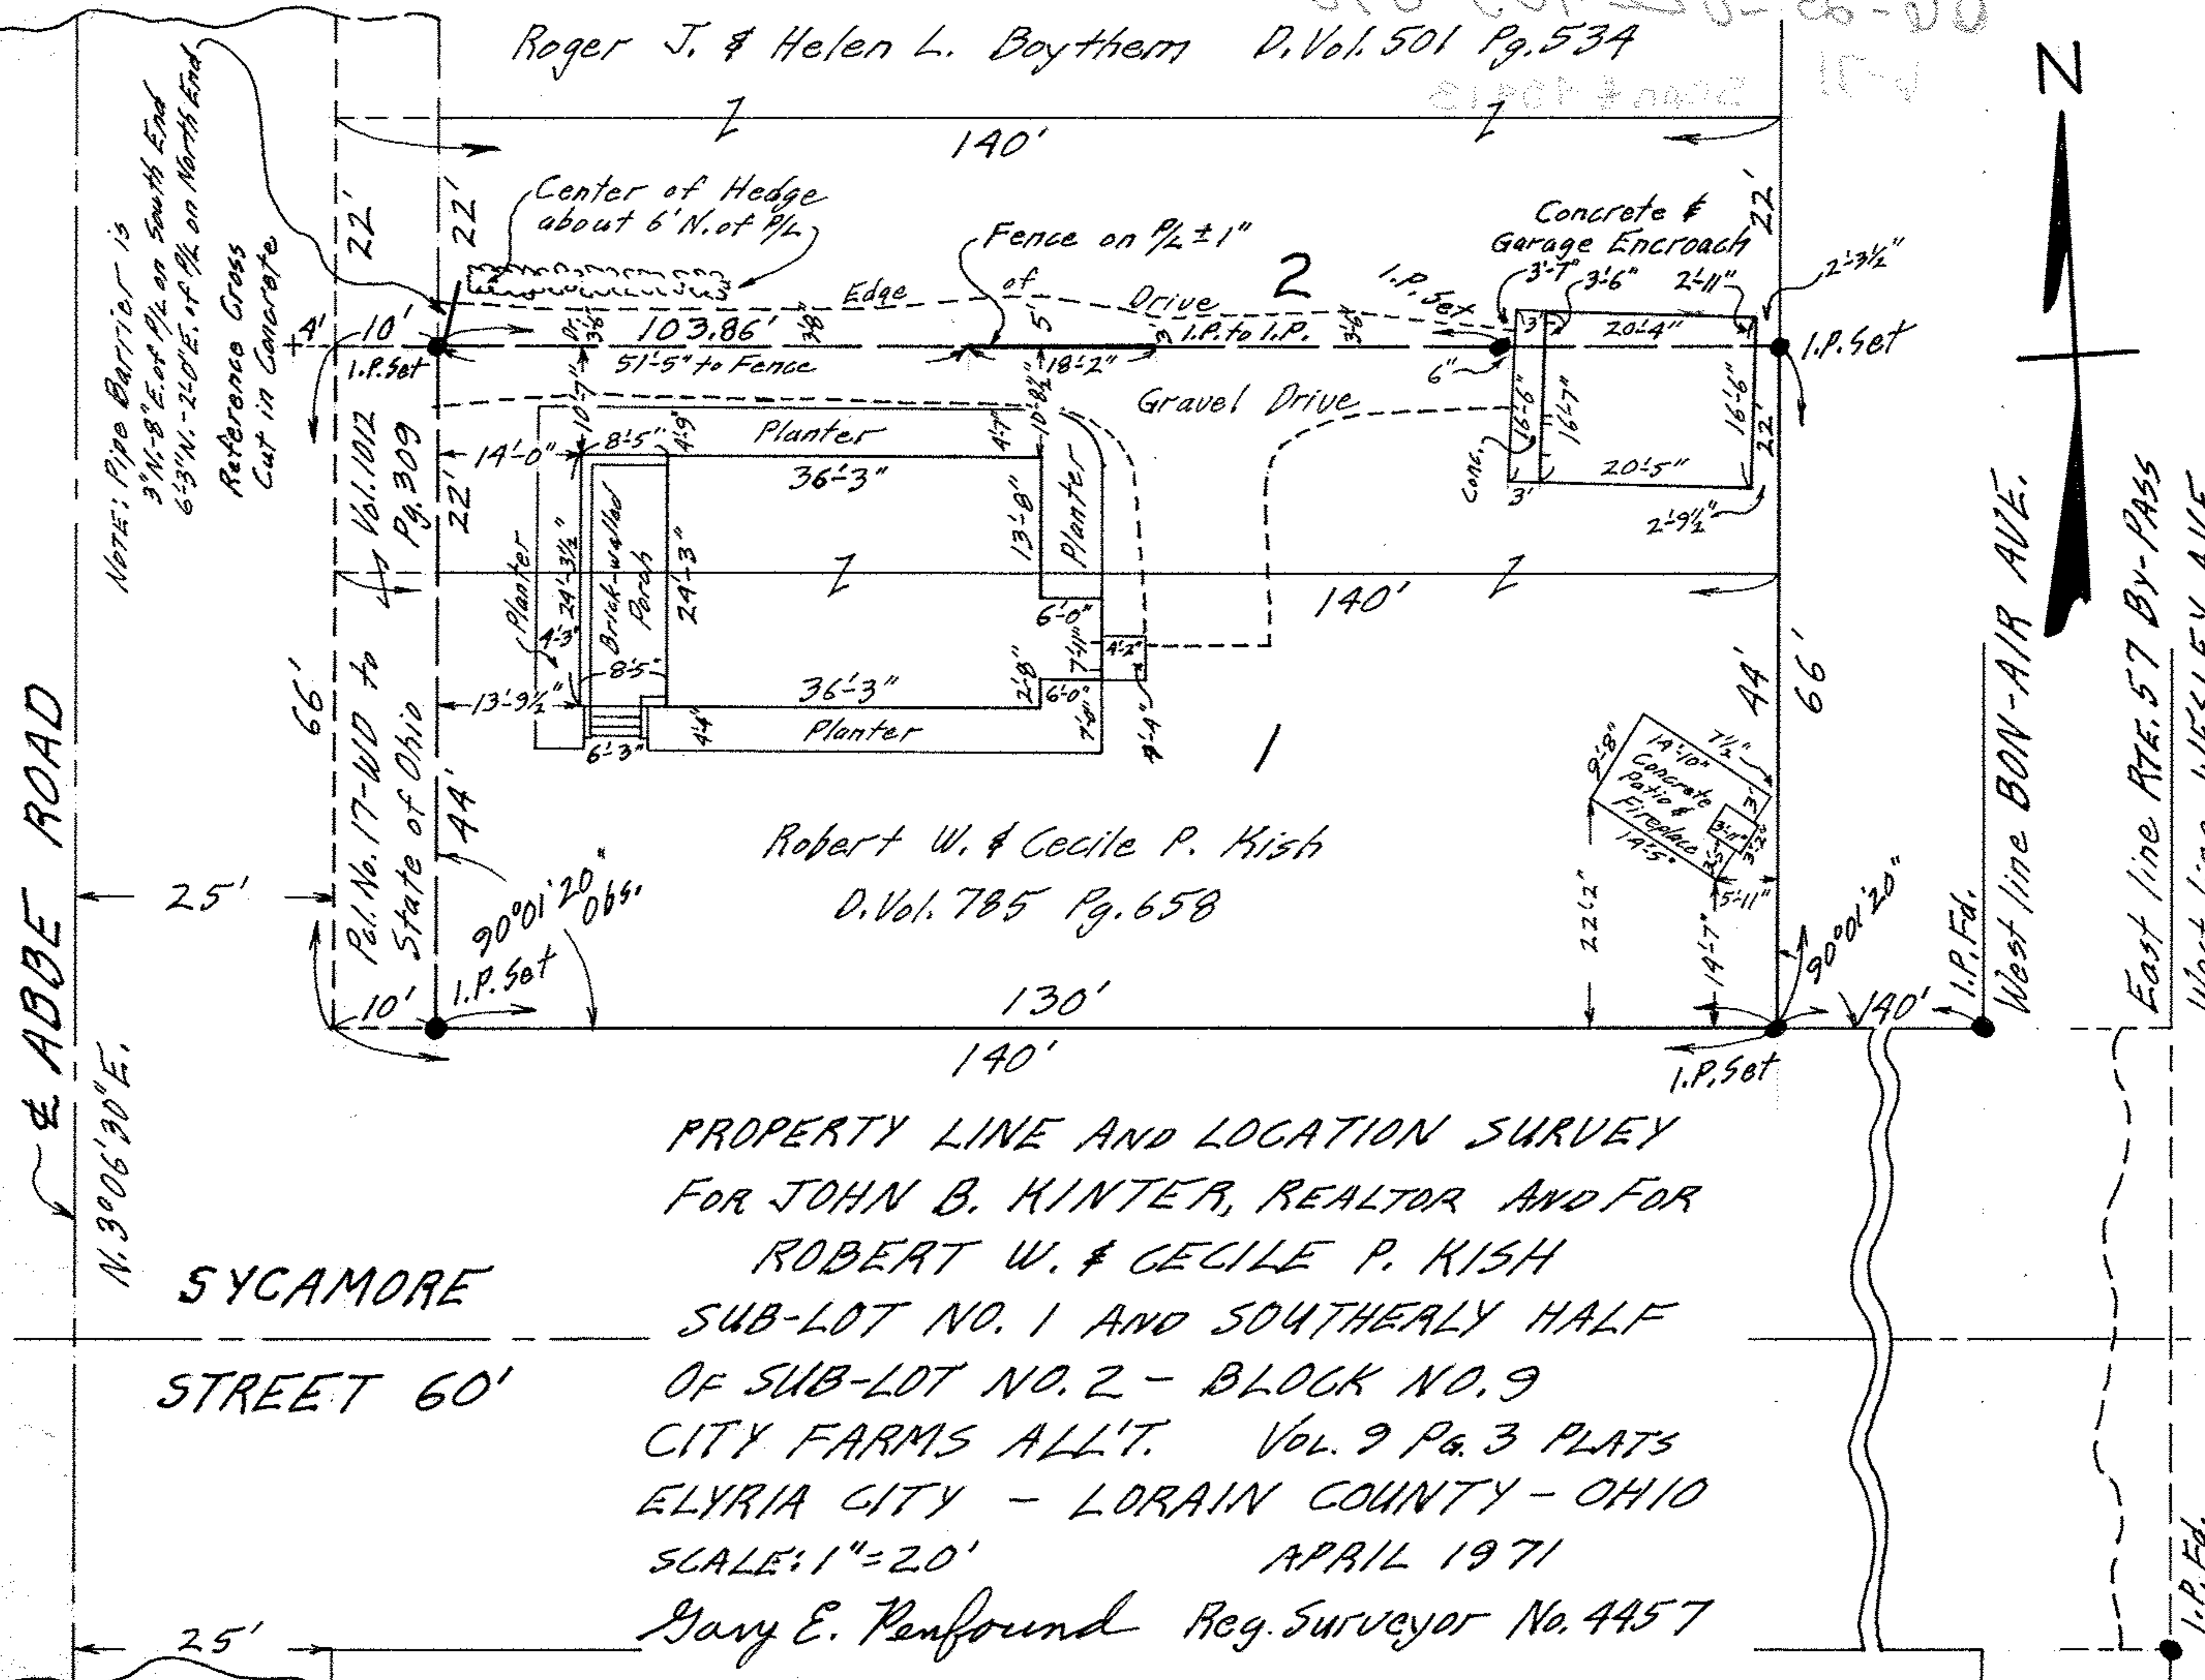

NOTE: Pipe Barrier is
 3" N. 8" E. of P/L on South End
 6" 3" N. - 2" 0" E. of P/L on North End
 Reference Cross
 Cut in Concrete

ABBE ROAD

N. 3° 06' 20" E.

SYCAMORE

STREET 60'

Robert W. & Cecile P. Kish
 D. Vol. 785 Pg. 658

PROPERTY LINE AND LOCATION SURVEY
 FOR JOHN B. HINTER, REALTOR AND FOR
 ROBERT W. & CECILE P. KISH
 SUB-LOT NO. 1 AND SOUTHERLY HALF
 OF SUB-LOT NO. 2 - BLOCK NO. 9
 CITY FARMS ALL'T. Vol. 9 Pg. 3 PLATS
 ELYRIA CITY - LORAIN COUNTY - OHIO
 SCALE: 1" = 20'

Gary E. Penfound Reg. Surveyor No. 4457

West line BON-AIR AVE.

East line RTE. 57 BY-PASS

West line WESLEY AVE.



I.P. Fd.