06-25-023-101-026

6-71

SCAN # 45931

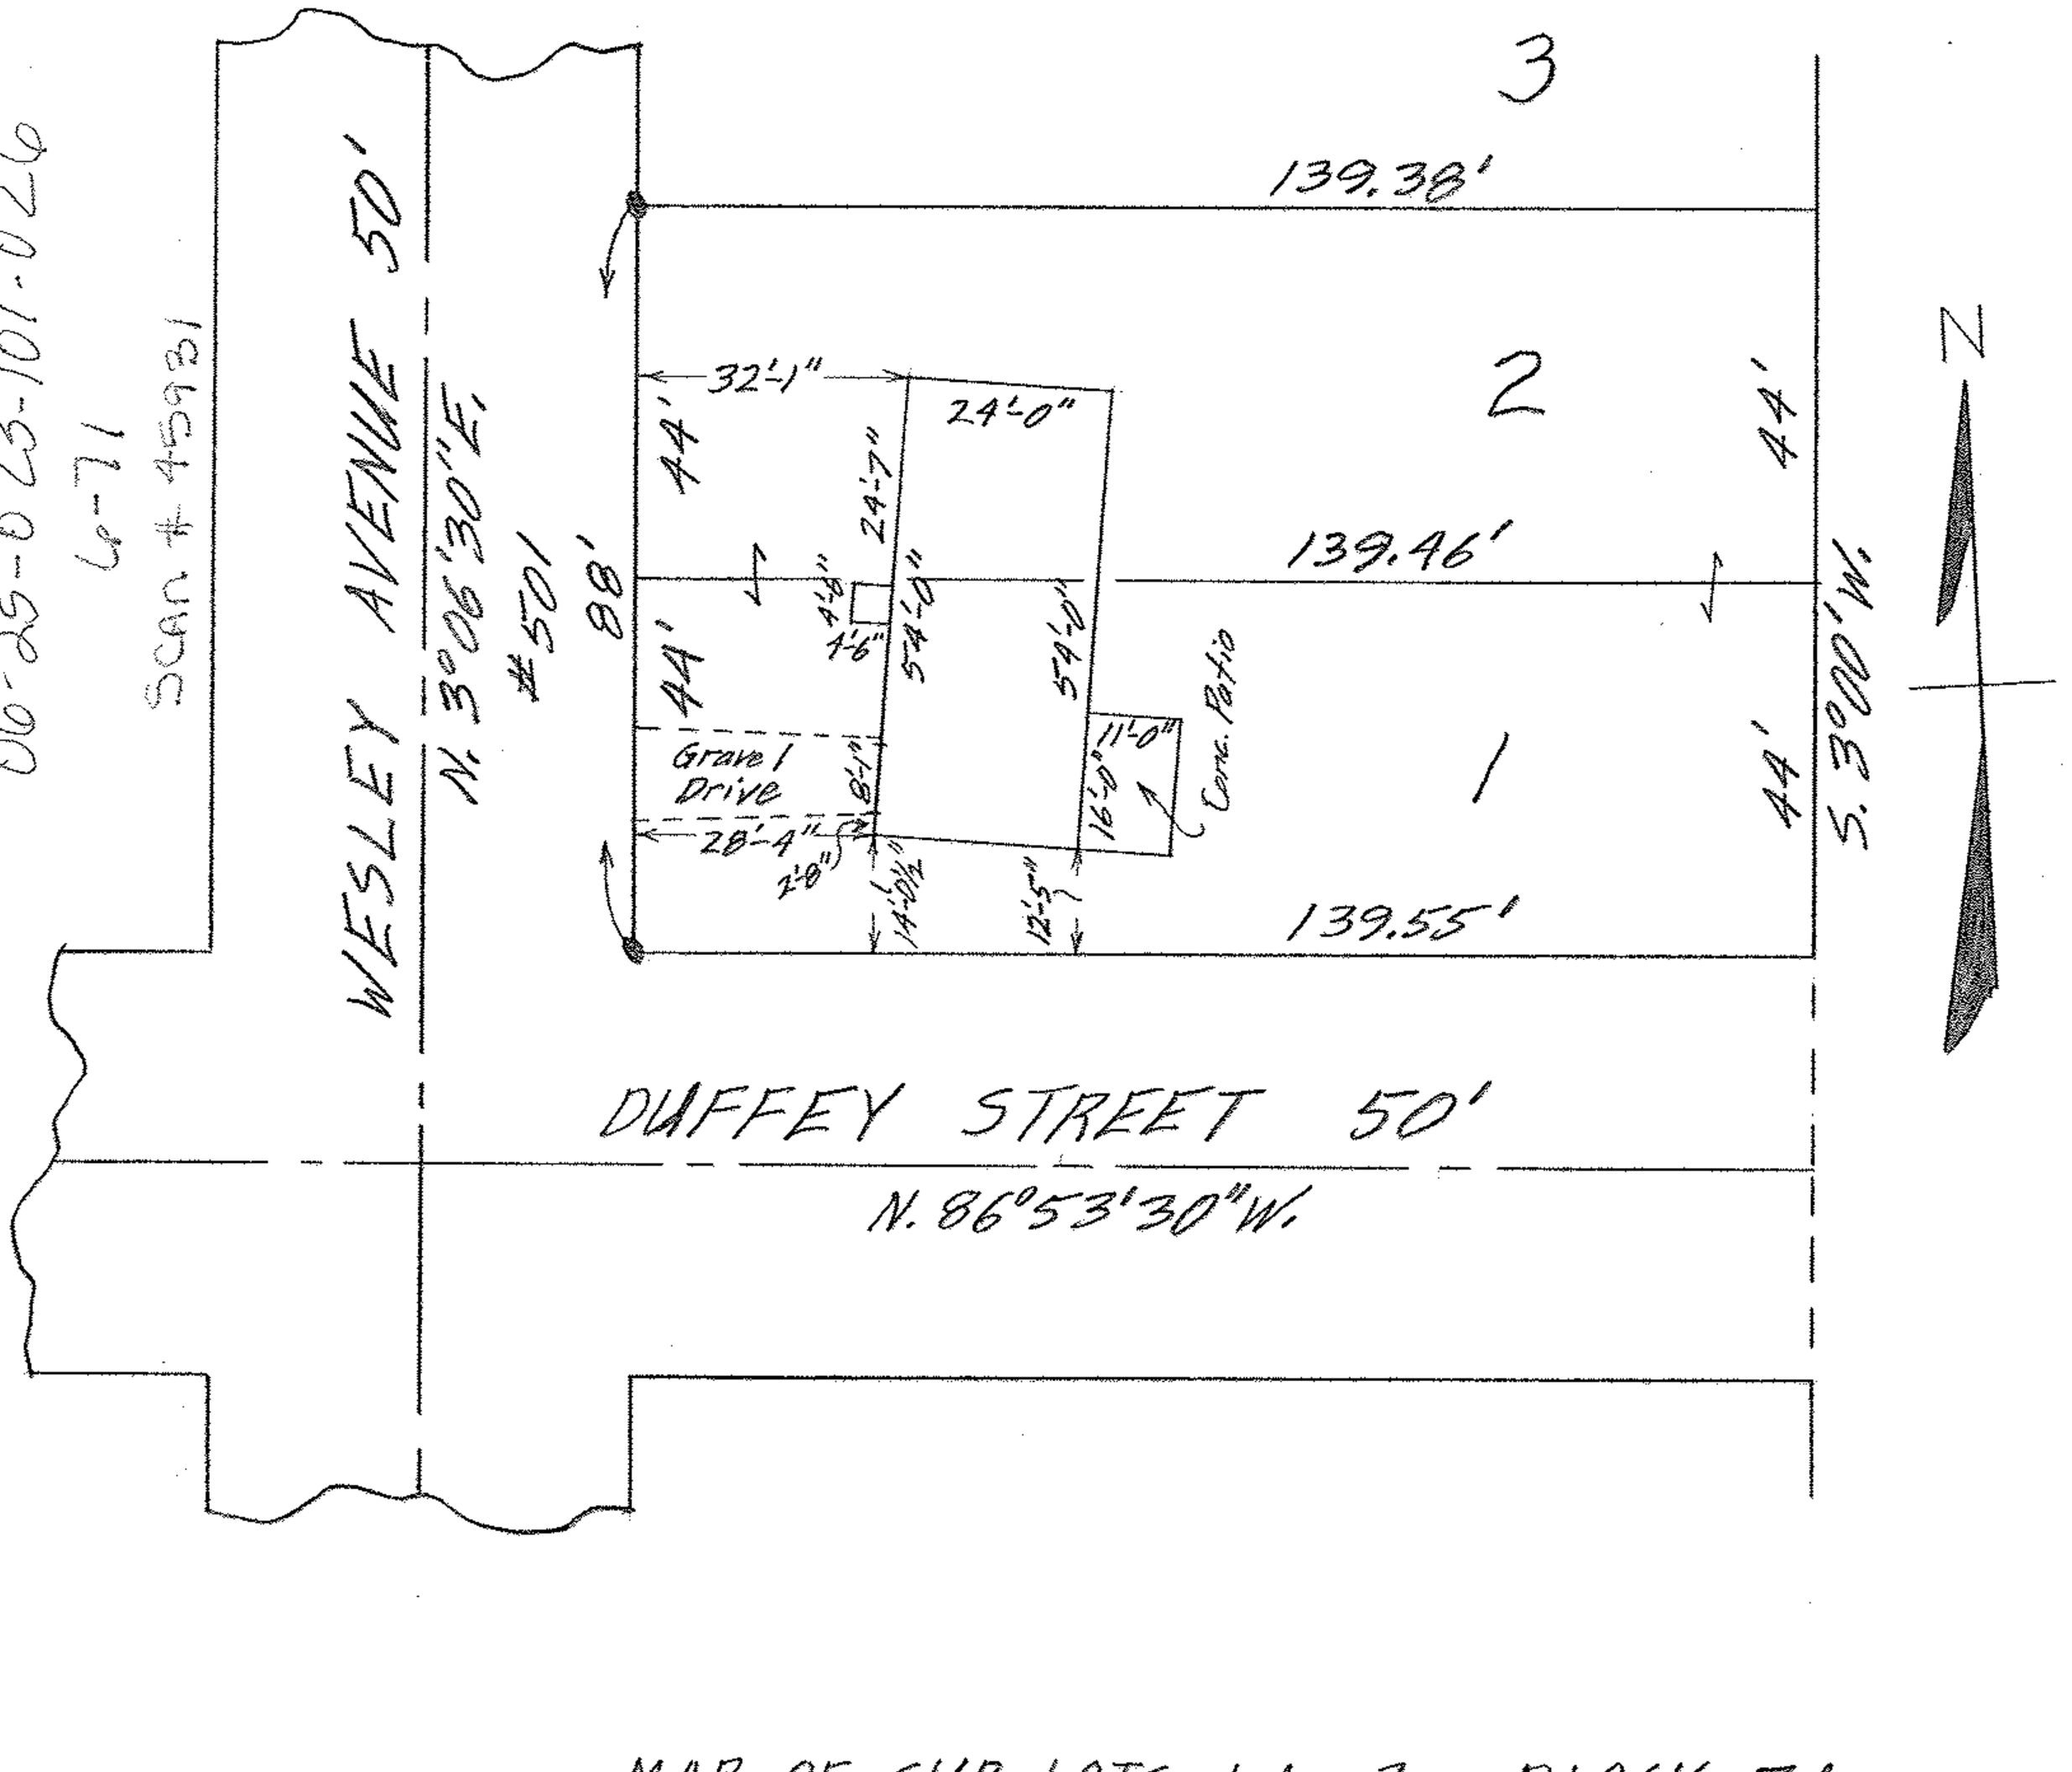

MAP OF SUB-LOTS 1 AND 2 BLOCK 74

CITY FARMS ALL'T. VOL. 9 PG. 3 PLATS

ELYRIA TWP. ELYRIA CITY

LORAIN COUNTY OHIO

SCALE: 1"=30' NOV. 27-1962 4:30 P.M.

Gary E. Penfound REG. SURVEYOR

Fleming H. & Christeen D. Shannon