06-25-023-103-040
6-89

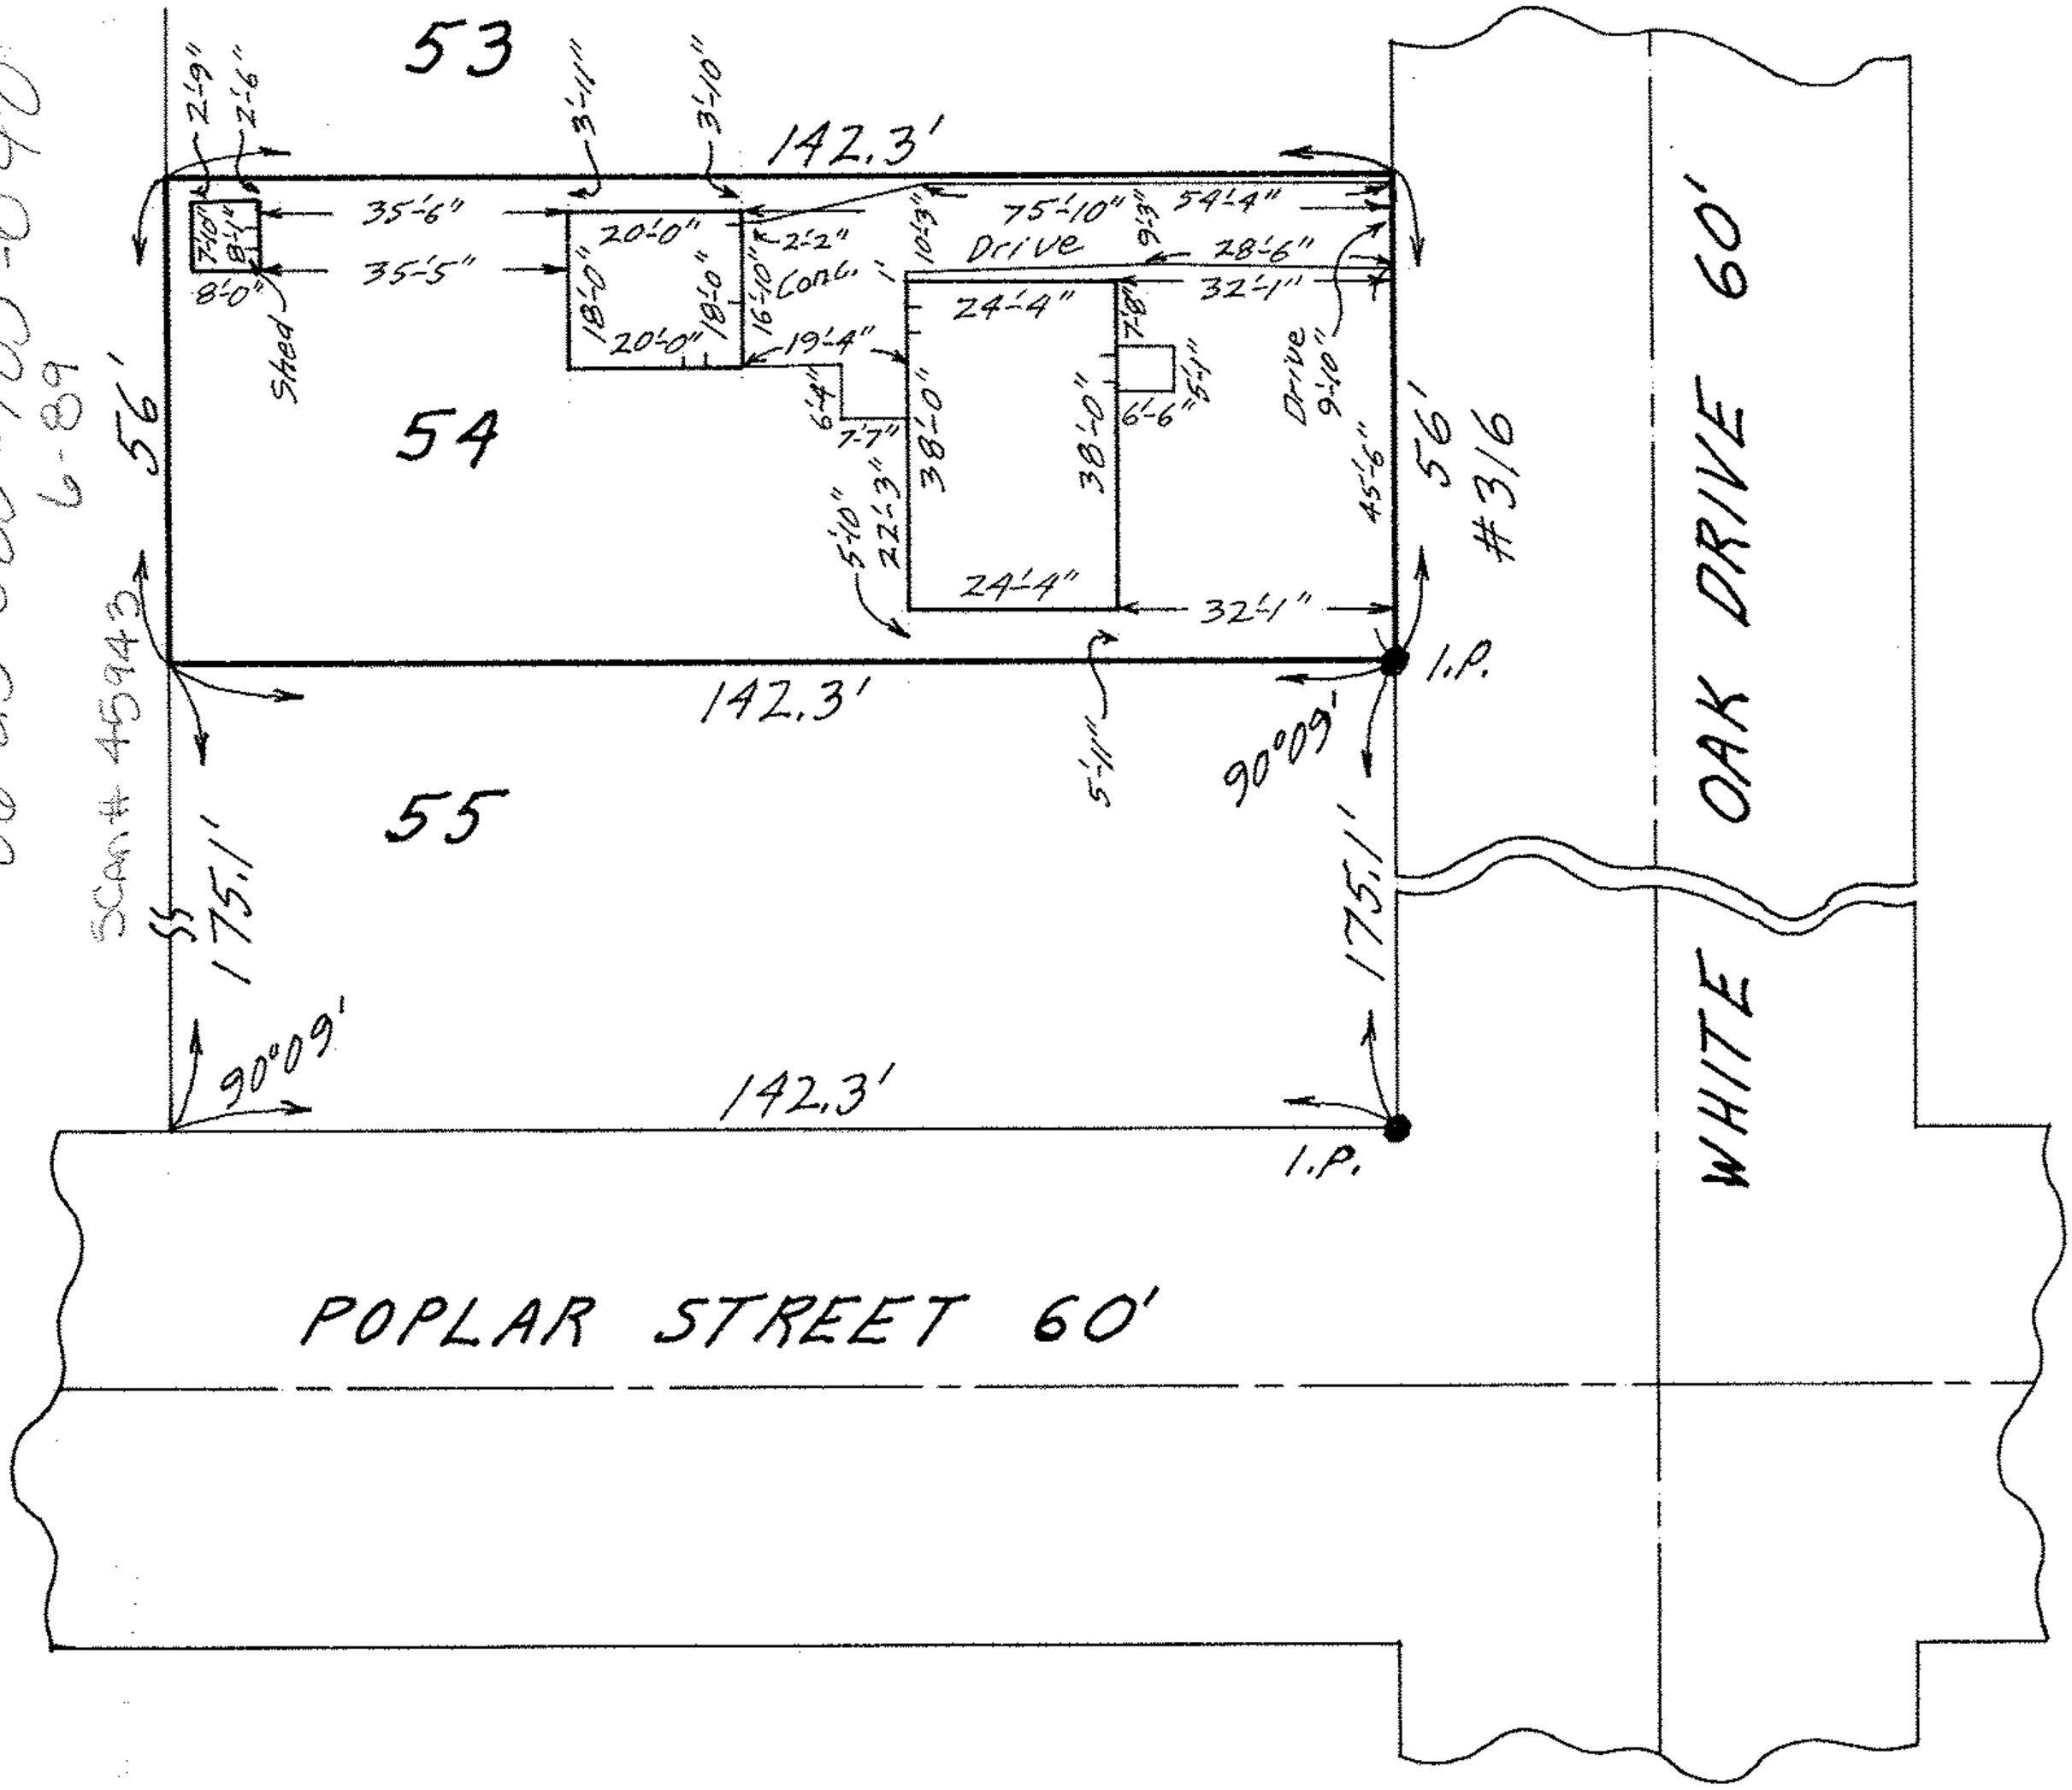

MAP OF SUB-LOT NO. 54
WHITE OAK DRIVE SUB'N. NO. 2 VOL. 19 PG. 4
ORIG. LOT 23 - EAST OF BLACK RIVER
ELYRIA TWP. ELYRIA CITY
LORAIN COUNTY OHIO
SCALE: 1"=30' JUNE 29-1970 9:00 P.M.
NOTE: There are no encroachments on this property.
Gary E. Penfound REG. SURVEYOR NO. 4457
CITY TITLE Co. Order No. E-1186-7
Charlton to Ferguson

N