


Scan# 45950 06-25-023-105-009,010

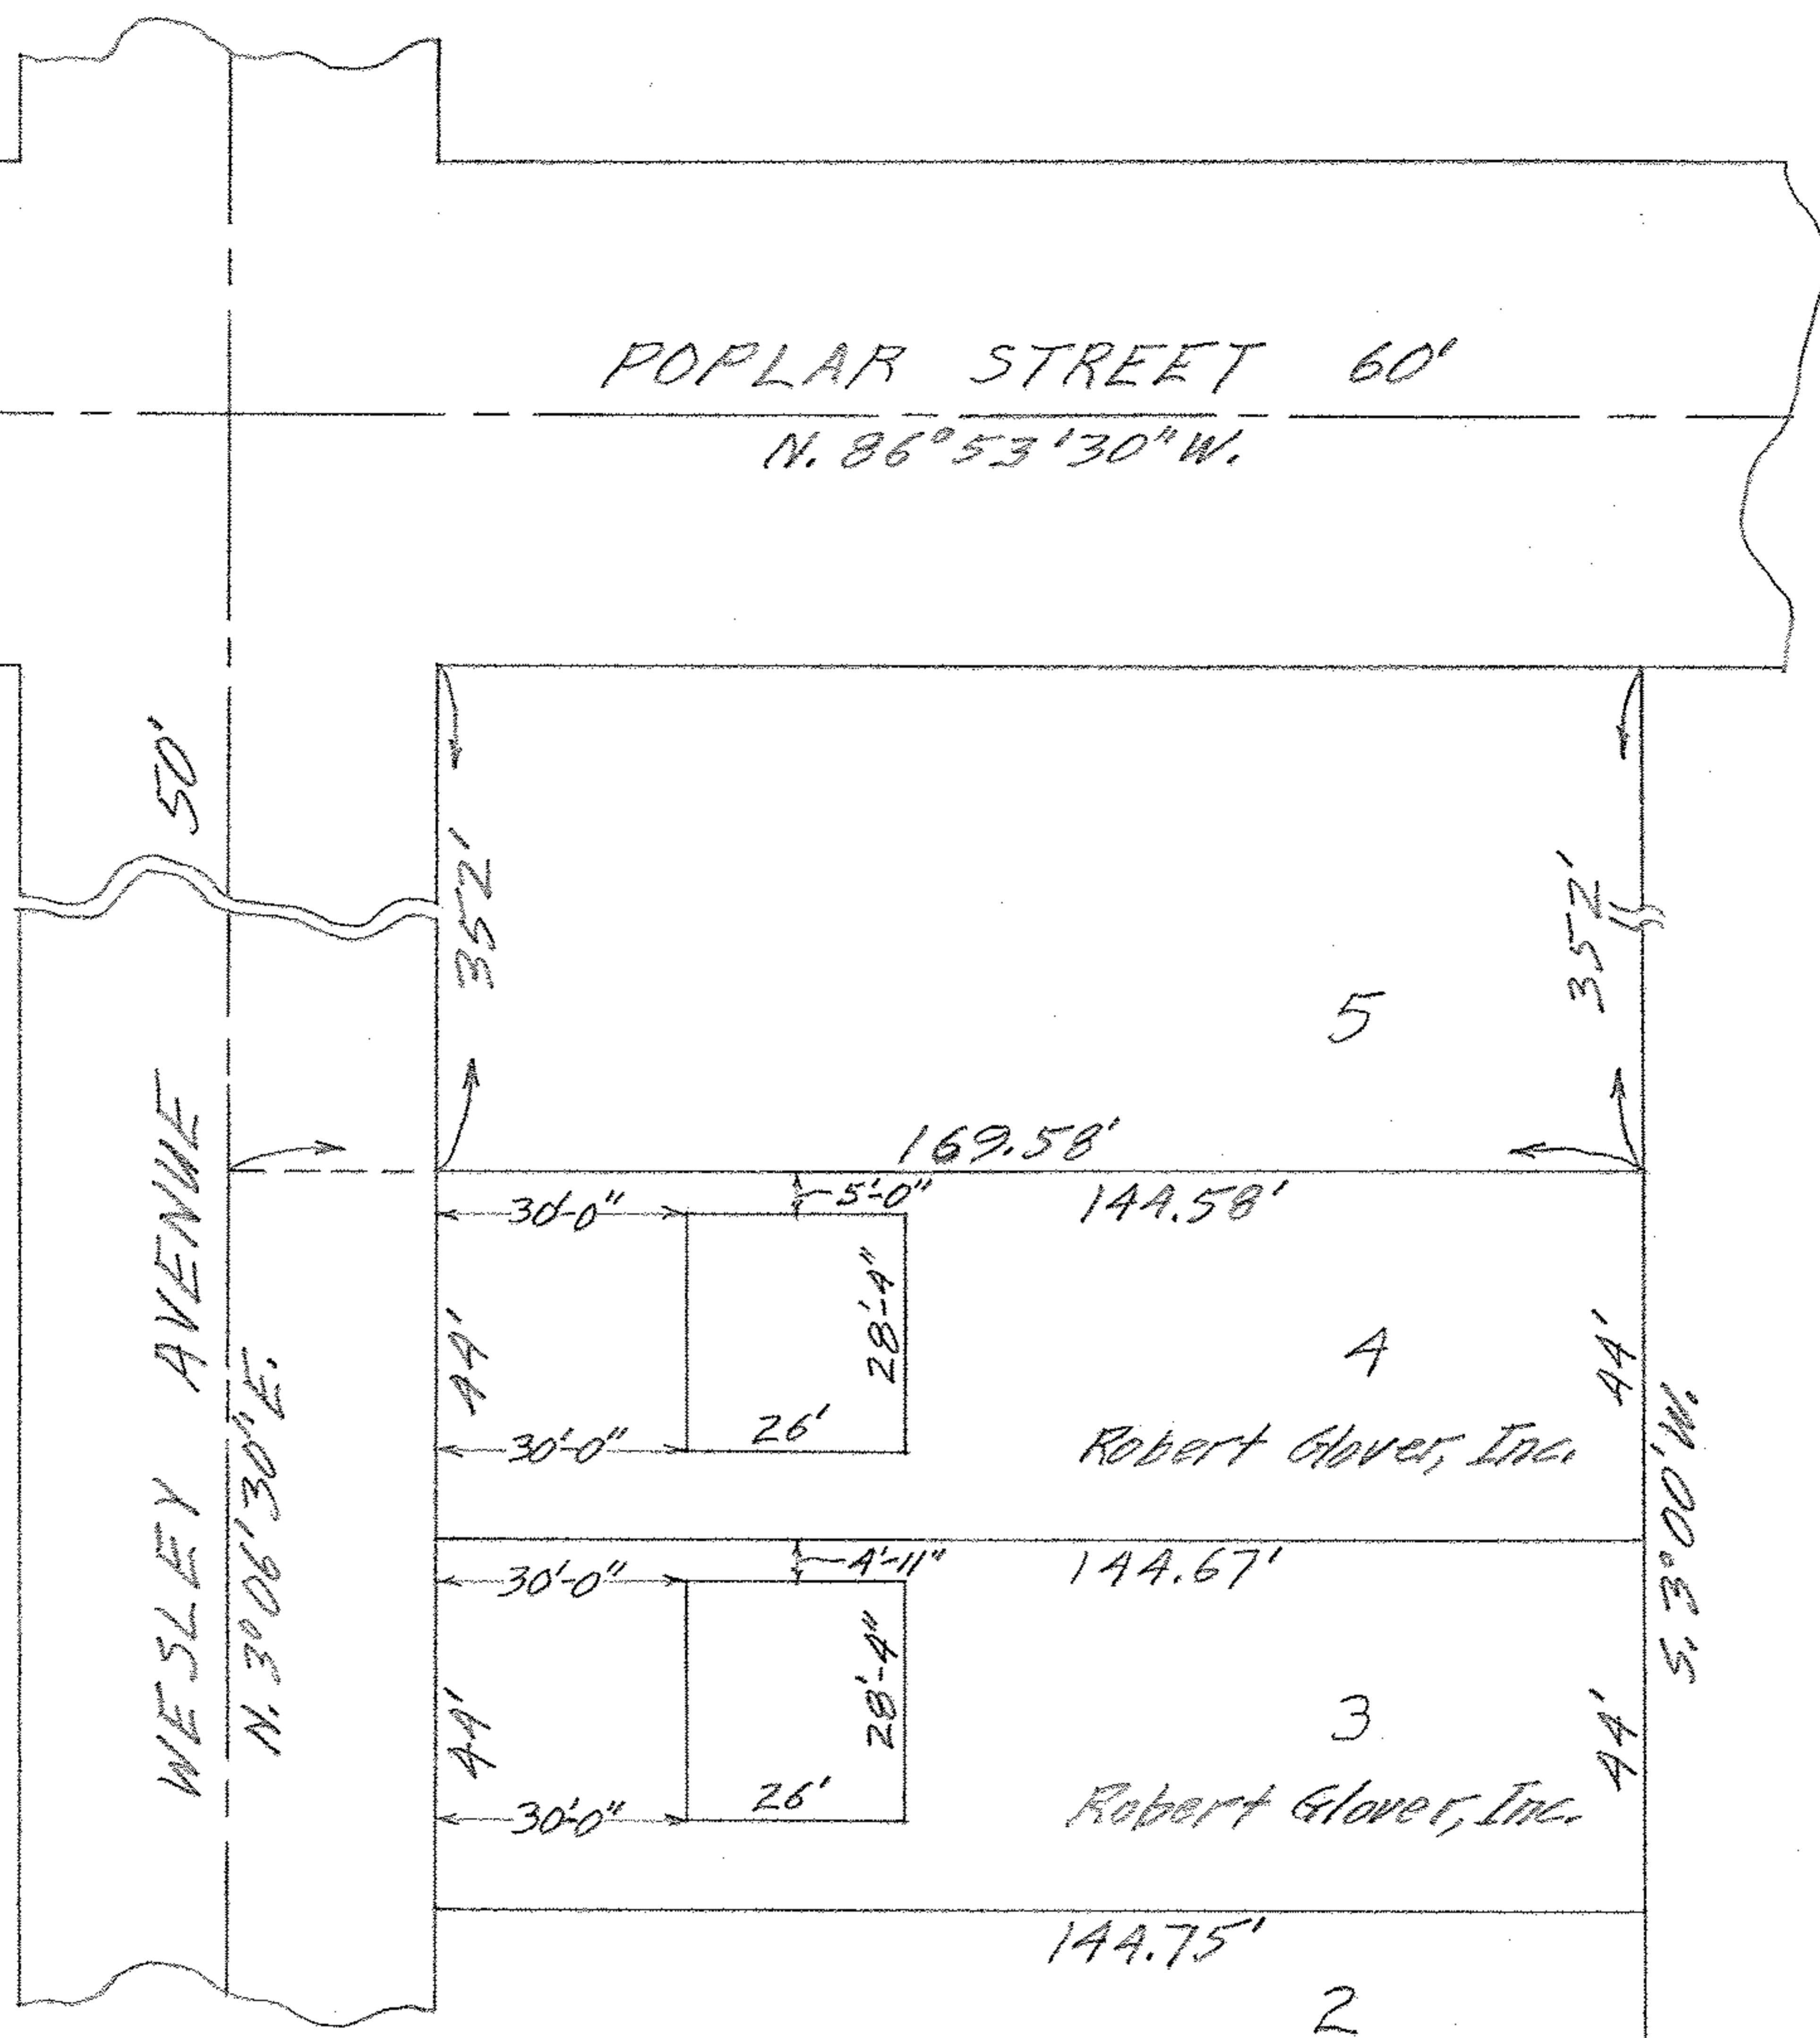

MAP OF SUB-LOT A BLOCK 6A  
 CITY FARMS ALL'T. VOL. 9 PG. 3 PLATS  
 ELYRIA TOWNSHIP ELYRIA CITY  
 LORAIN COUNTY OHIO  
 SCALE: 1" = 30' JULY 9 - 1960 3:10 P.M.  
 Gary E. Penland REG. SURVEYOR W W

Made for and at the instance of Security Federal Savings & Loan Co. and Lawyers Title Insurance Co. - A.H. West, APPROVED ATTORNEY