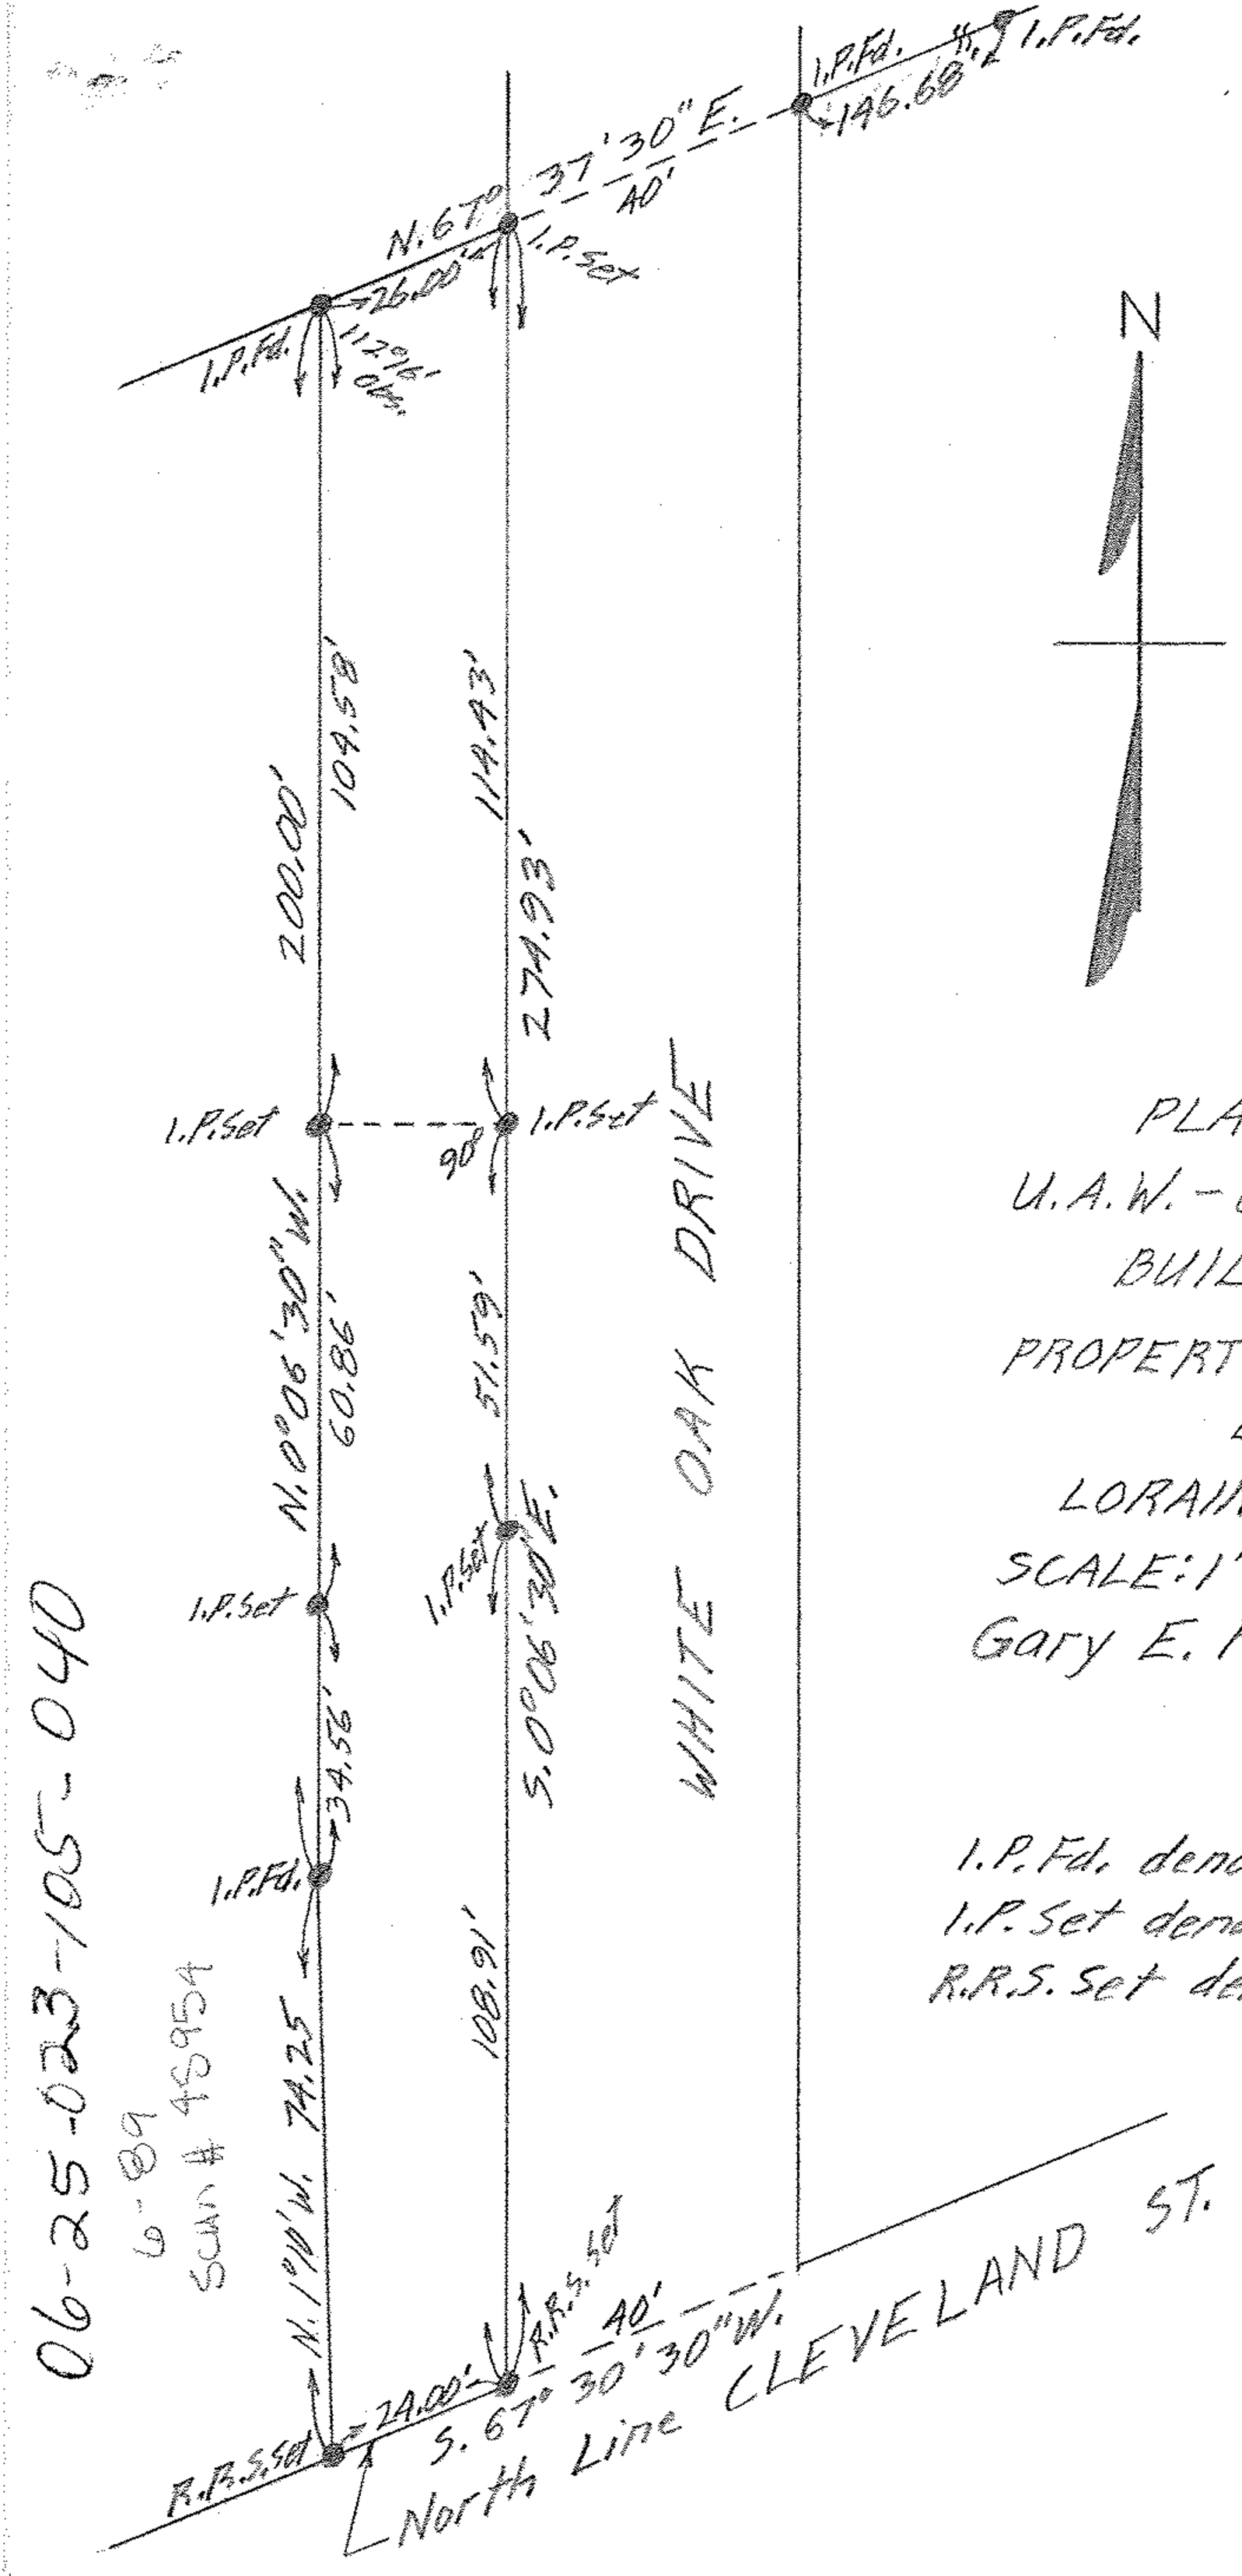

N

PLAT OF SURVEY FOR
U.A.W.-C.I.O., LOCAL No. 971
BUILDING CORPORATION
PROPERTY AT 824 CLEVELAND ST.
ELYRIA CITY
LORAIN COUNTY OHIO
SCALE: 1"=30' MARCH 17-1960
Gary E. Penfound - Reg. Surveyor

I.P.Fd. denotes iron pin found.
I.P.Set denotes iron pin set.
R.R.S. Set denotes railroad spike set.