


CITY TITLE Co. Order No. E-876-7  
 Robert E. & Mary Terrell to  
 William R. & Kathleen S. Mugford

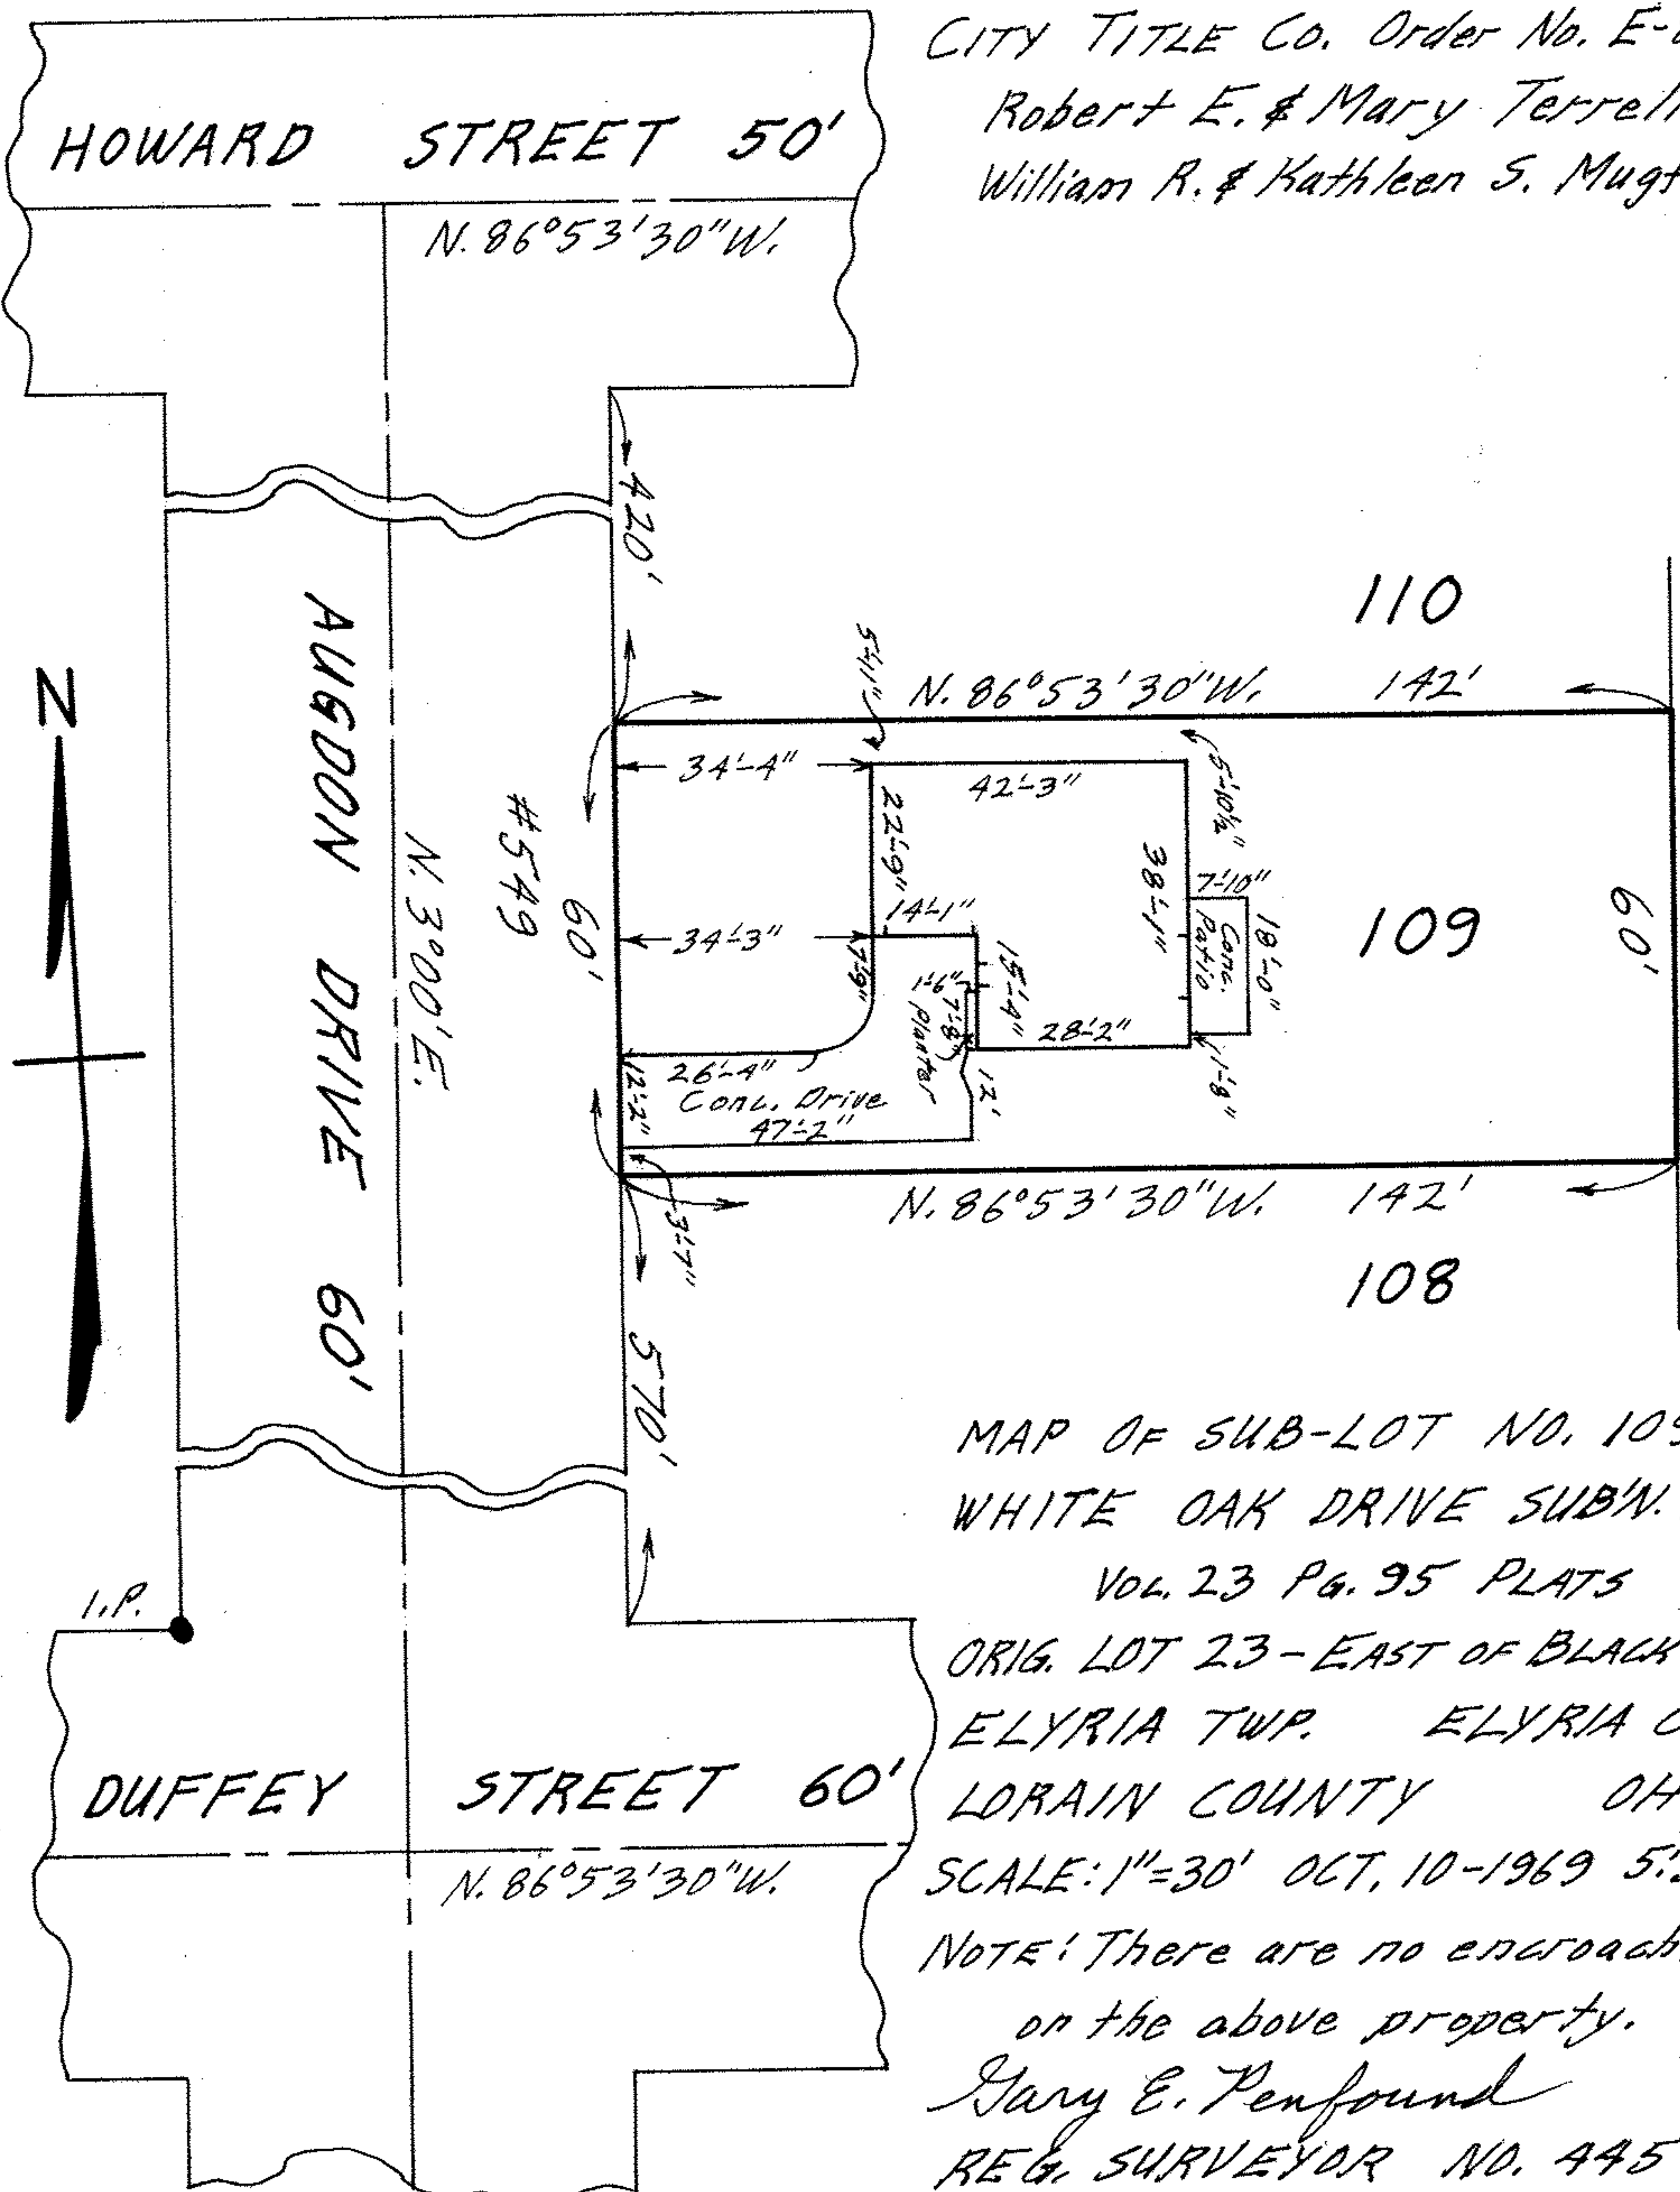

MAP OF SUB-LOT NO. 109  
 WHITE OAK DRIVE SUB'N. NO. 5  
 VOL. 23 PG. 95 PLATS  
 ORIG. LOT 23 - EAST OF BLACK RIVER  
 ELYRIA TWP. ELYRIA CITY  
 LORAIN COUNTY OHIO  
 SCALE: 1"=30' OCT. 10-1969 5:30 P.M.

NOTE: There are no encroachments  
 on the above property.  
 Gary E. Penfound  
 REG. SURVEYOR NO. 4457

06-85-000-101-002  
 6-89  
 SCAN 45956