06-25-027-108-030
6-54
Scan # 45961

MAP OF THE EASTERLY 18 FEET OF SUB-LOT NO. 40 AND THE WESTERLY 52 FEET OF SUB-LOT NO. 41 OF SHERWOOD MANOR SUB'N. NO. 3 - VOL. 22 PG. 79
ORIG. LOT 27 - EAST OF BLACK RIVER - ELYRIA TWP.
ELYRIA CITY - LORAIN COUNTY - OHIO
SCALE: 1" = 30' SEPT. 10-1969 2:15 P.M.

NOTE: There are no encroachments on this property.
Gary E. Penfound REG. SURVEYOR NO. 4457

CITY TITLE CO. Order No. E-832
William & Mary Walters to
Paul J. & Patricia Biancardi
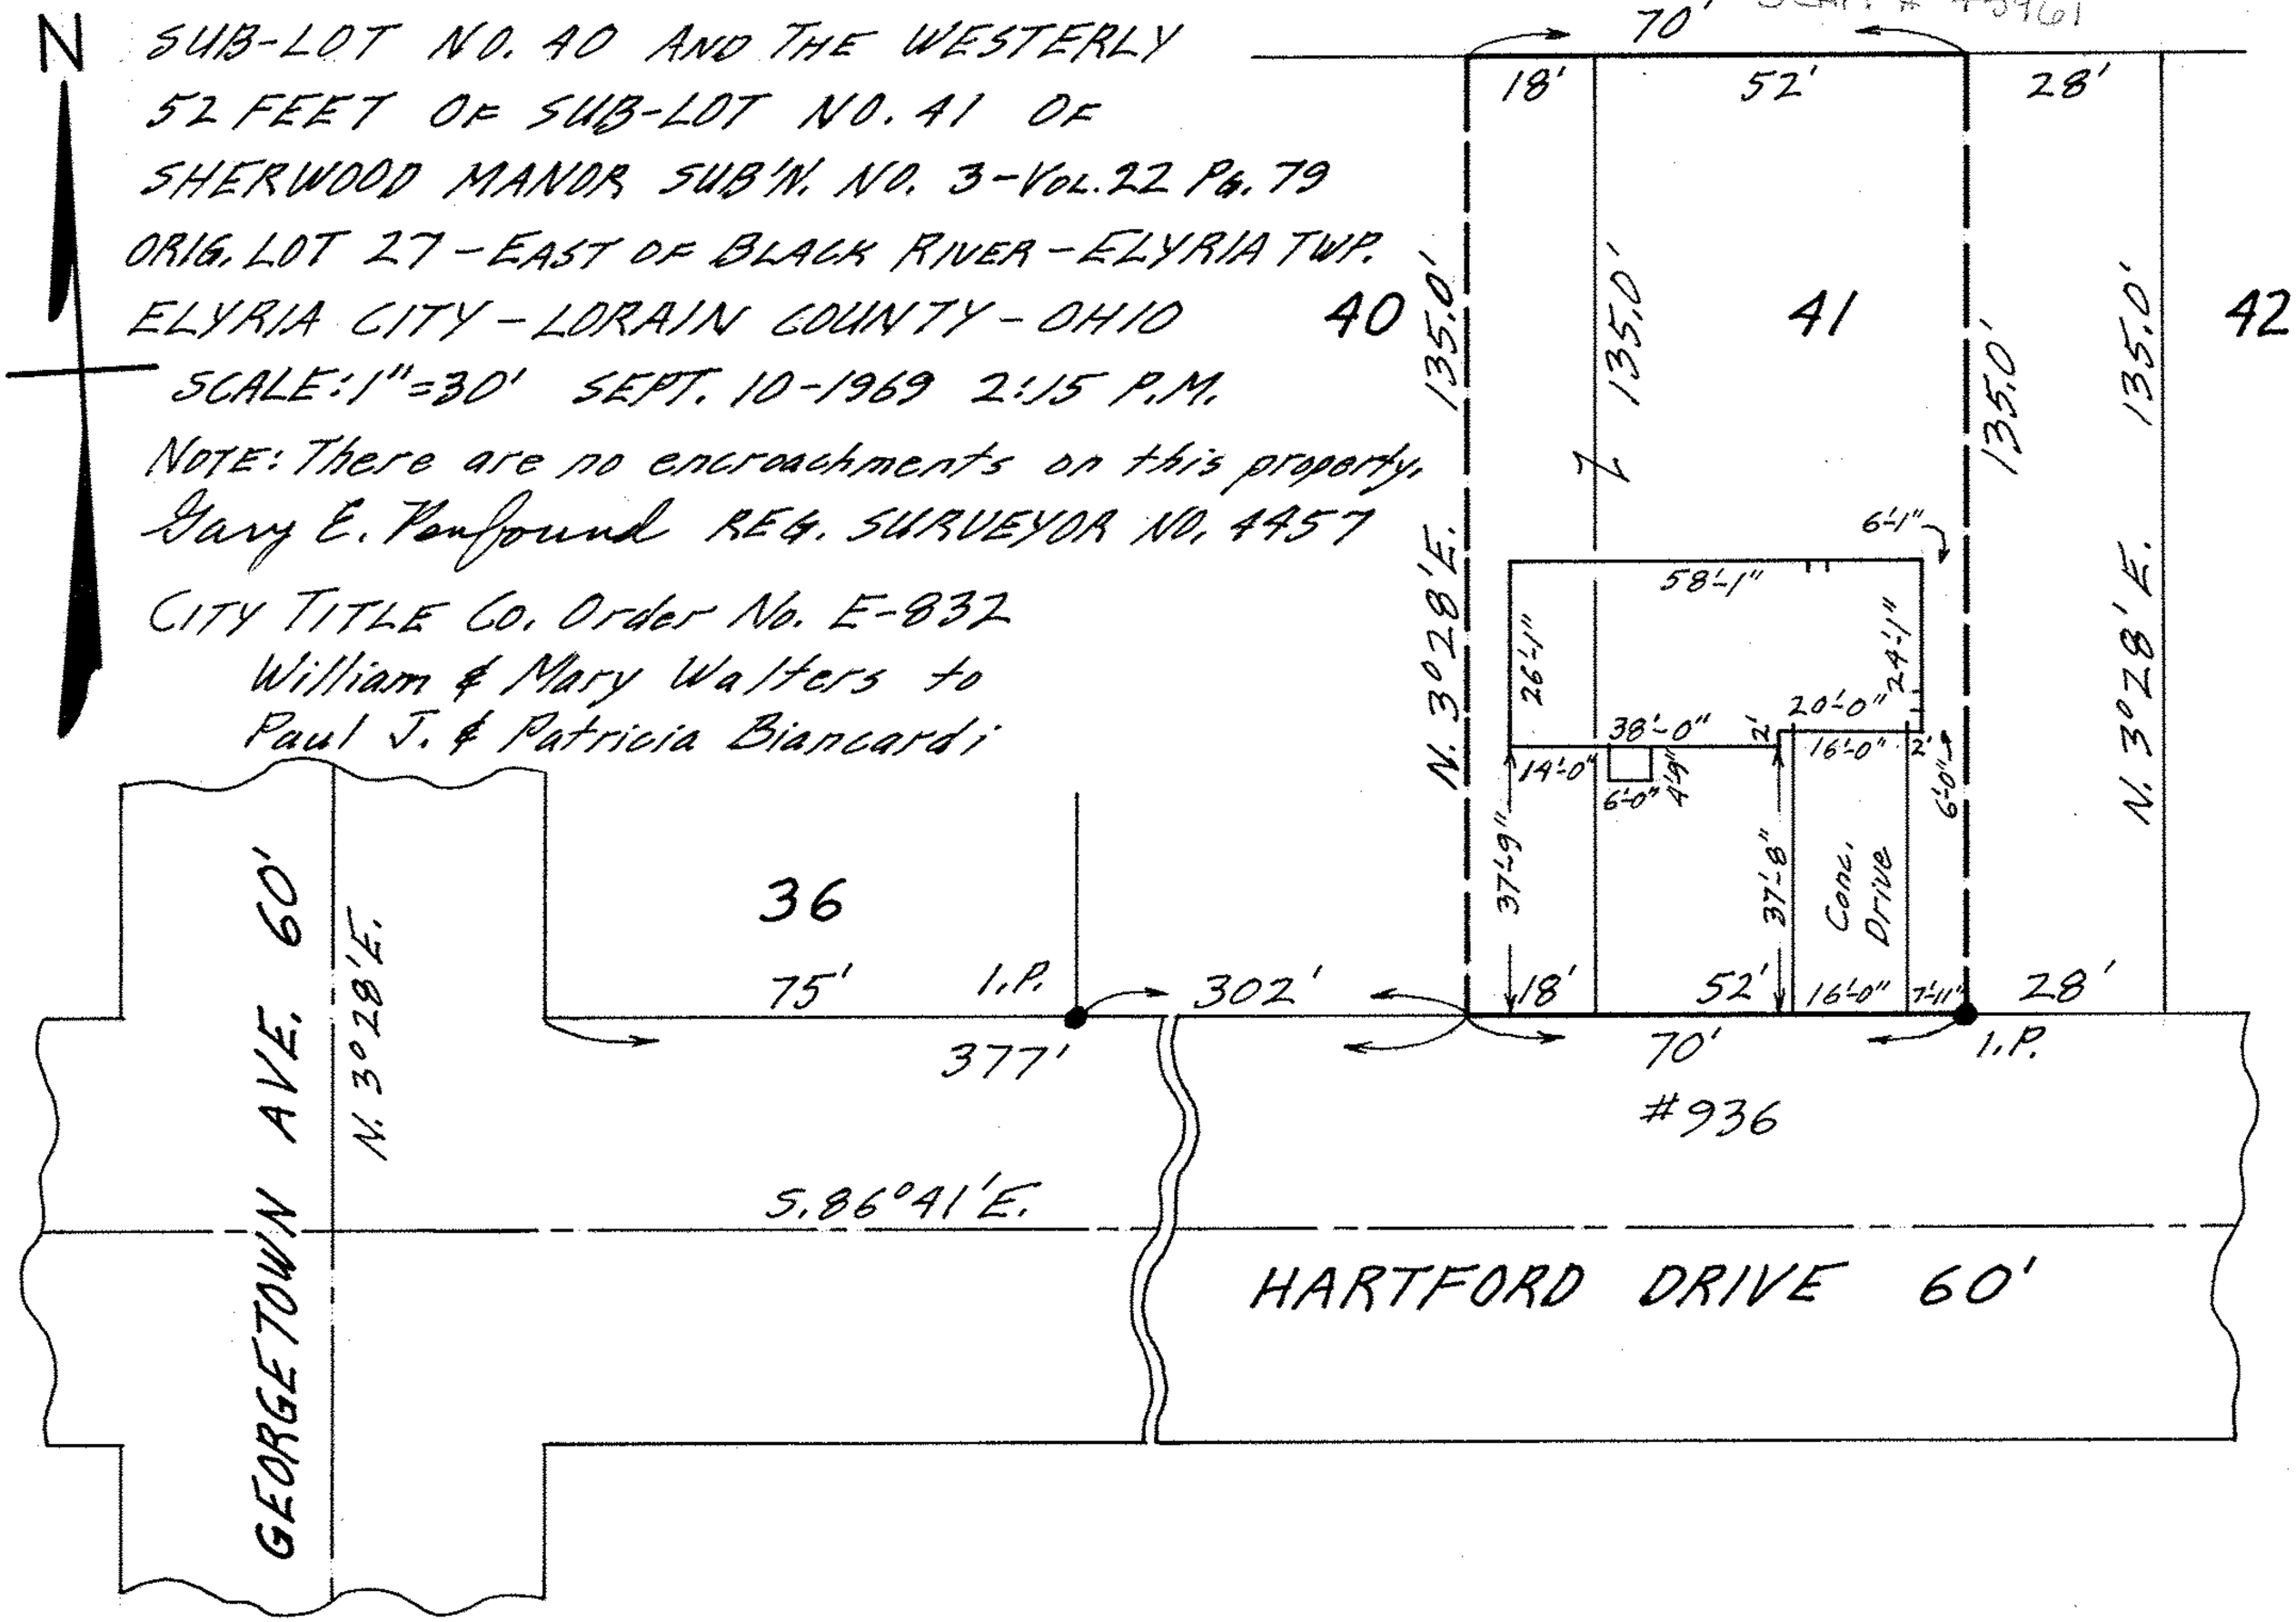
N