


00-25-032-106 009, 010

6-68

SCAN #45980

CRESTVIEW ALLT. VOL. 13 PG. 28

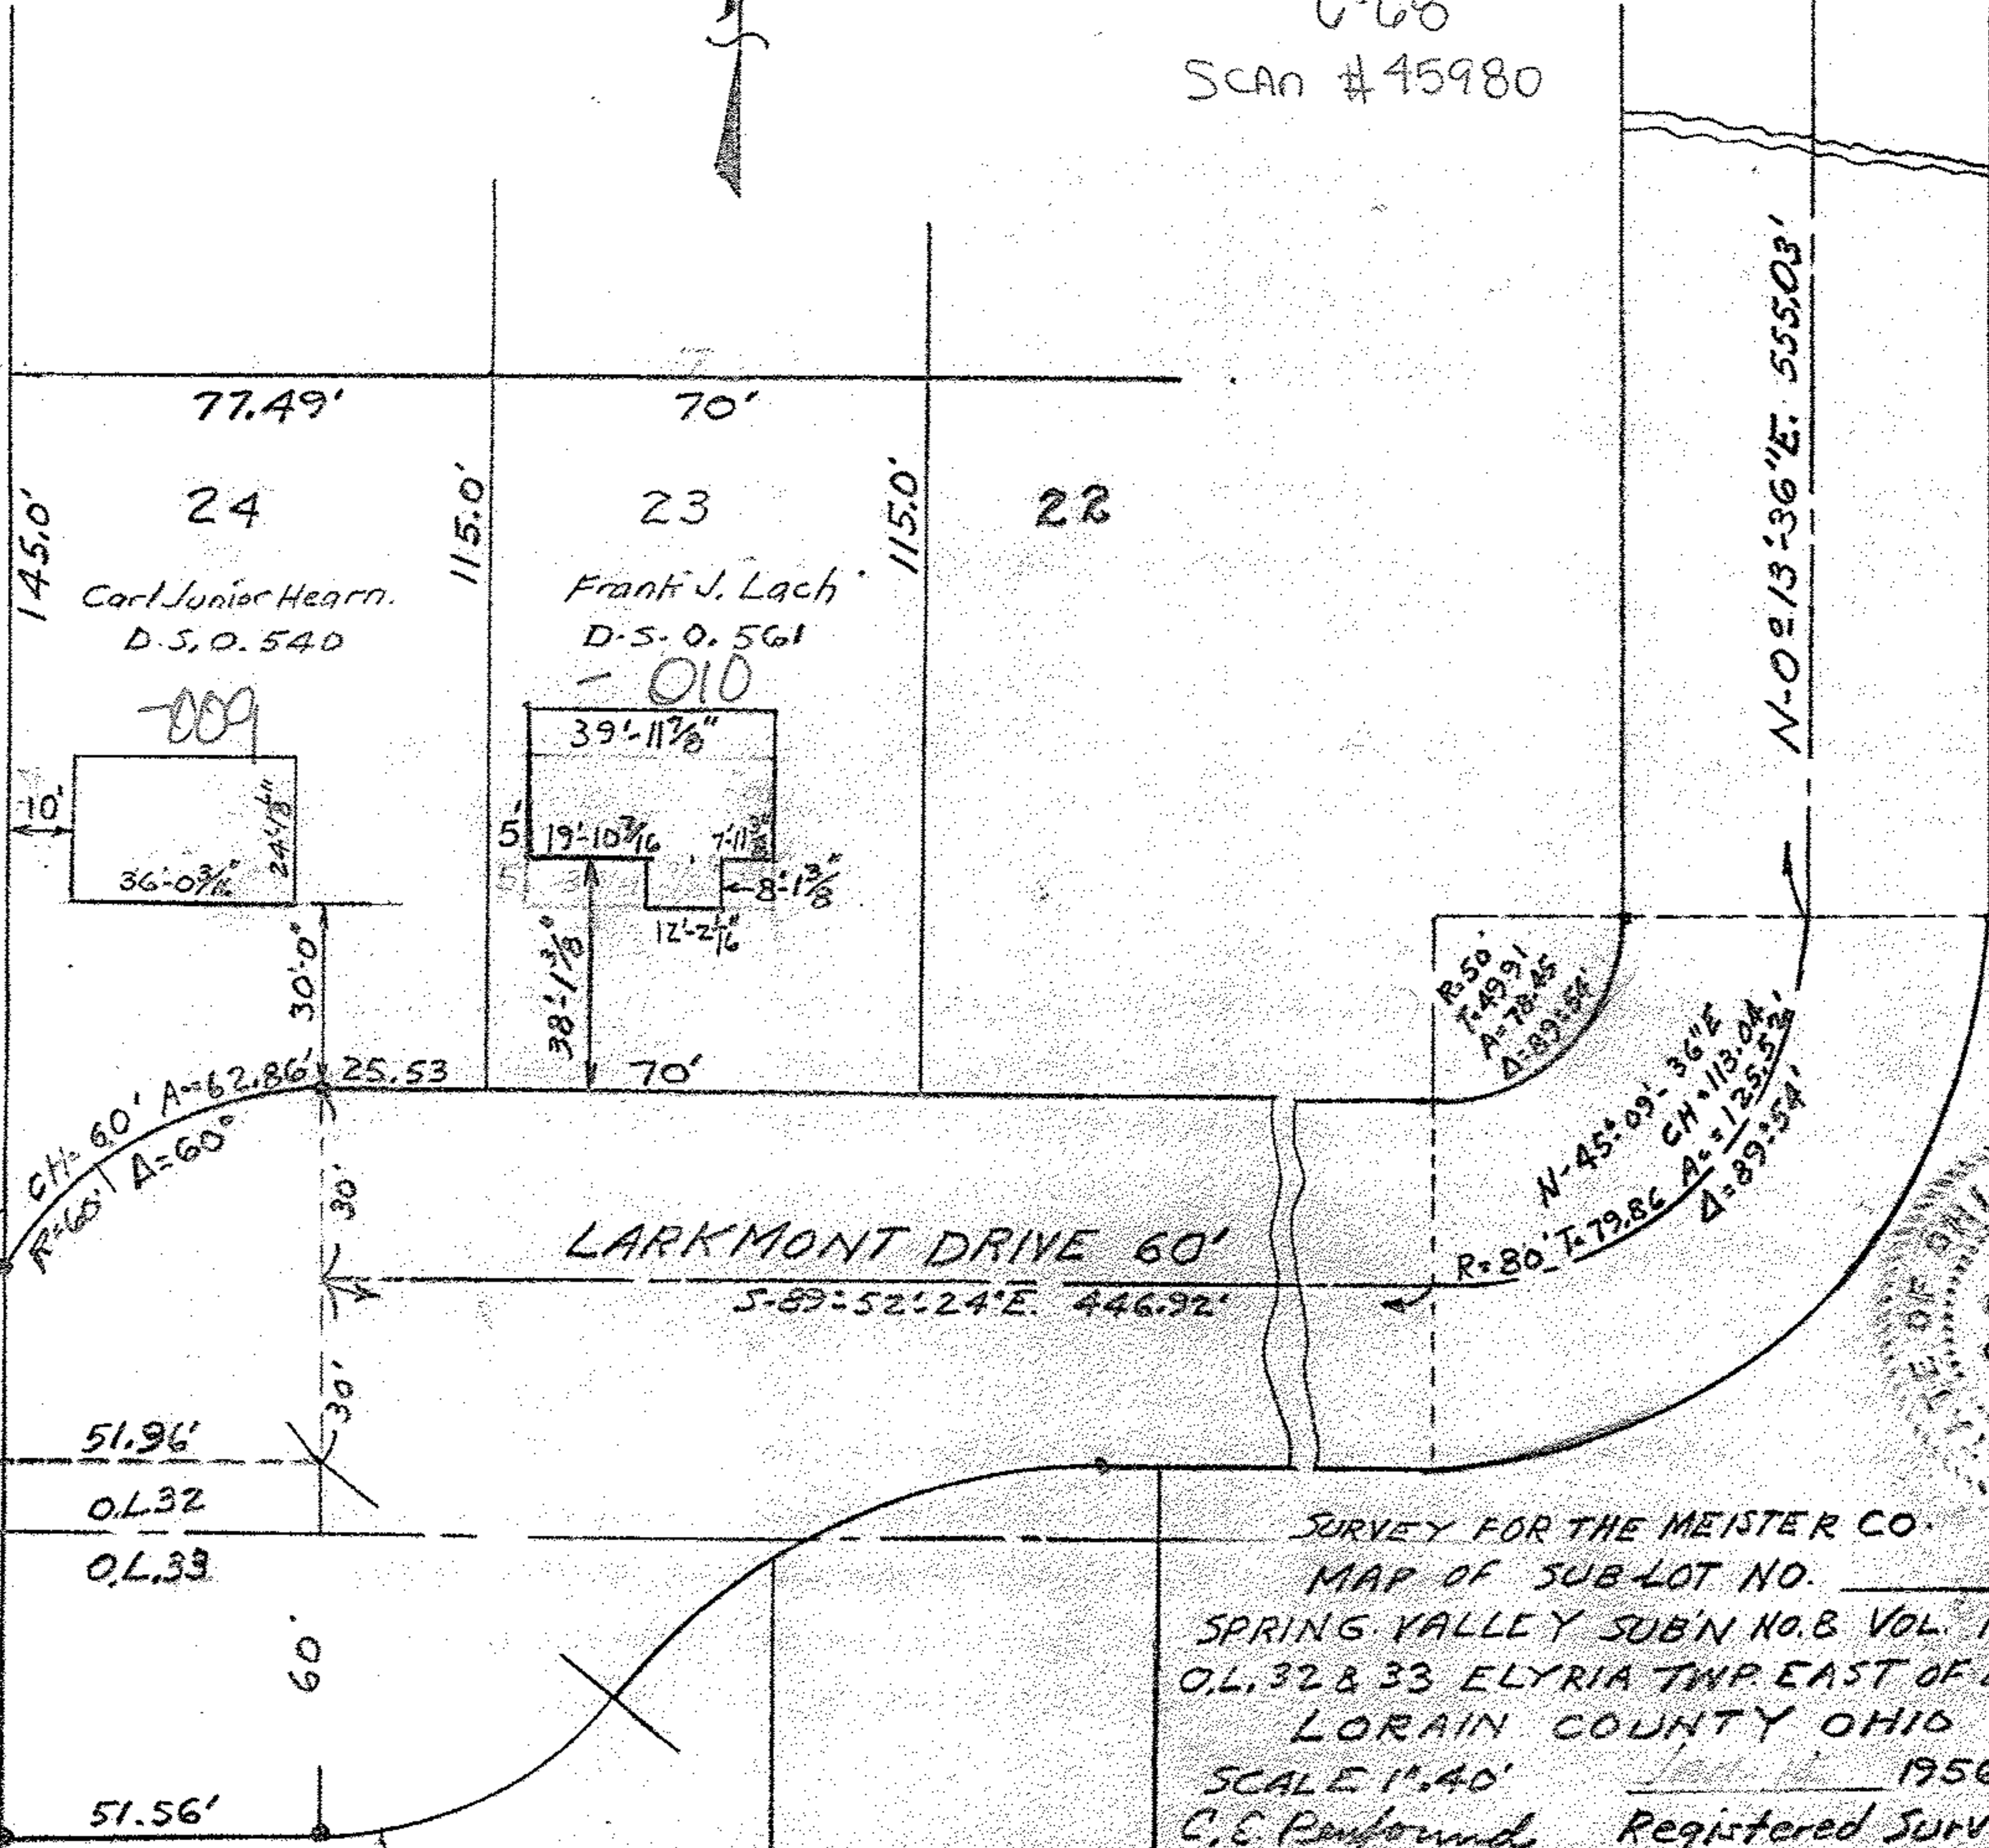

Emery & Florence Smith

Carl Junior Hearn
D.S. 0.540

Frank J. Lach
D.S. 0.561

LARKMONT DRIVE 60'

S-89°52'24"E. 446.92'

SURVEY FOR THE MEISTER CO.
MAP OF SUB LOT NO. _____

SPRING VALLEY SUB'N NO. 8 VOL. 18 PG. 28
O.L. 32 & 33 ELYRIA TWP EAST OF BLACK RIVER
LORAIN COUNTY OHIO

SCALE 1"=40' _____ 1956
C.E. Penfound Registered Surveyor
C.H.

