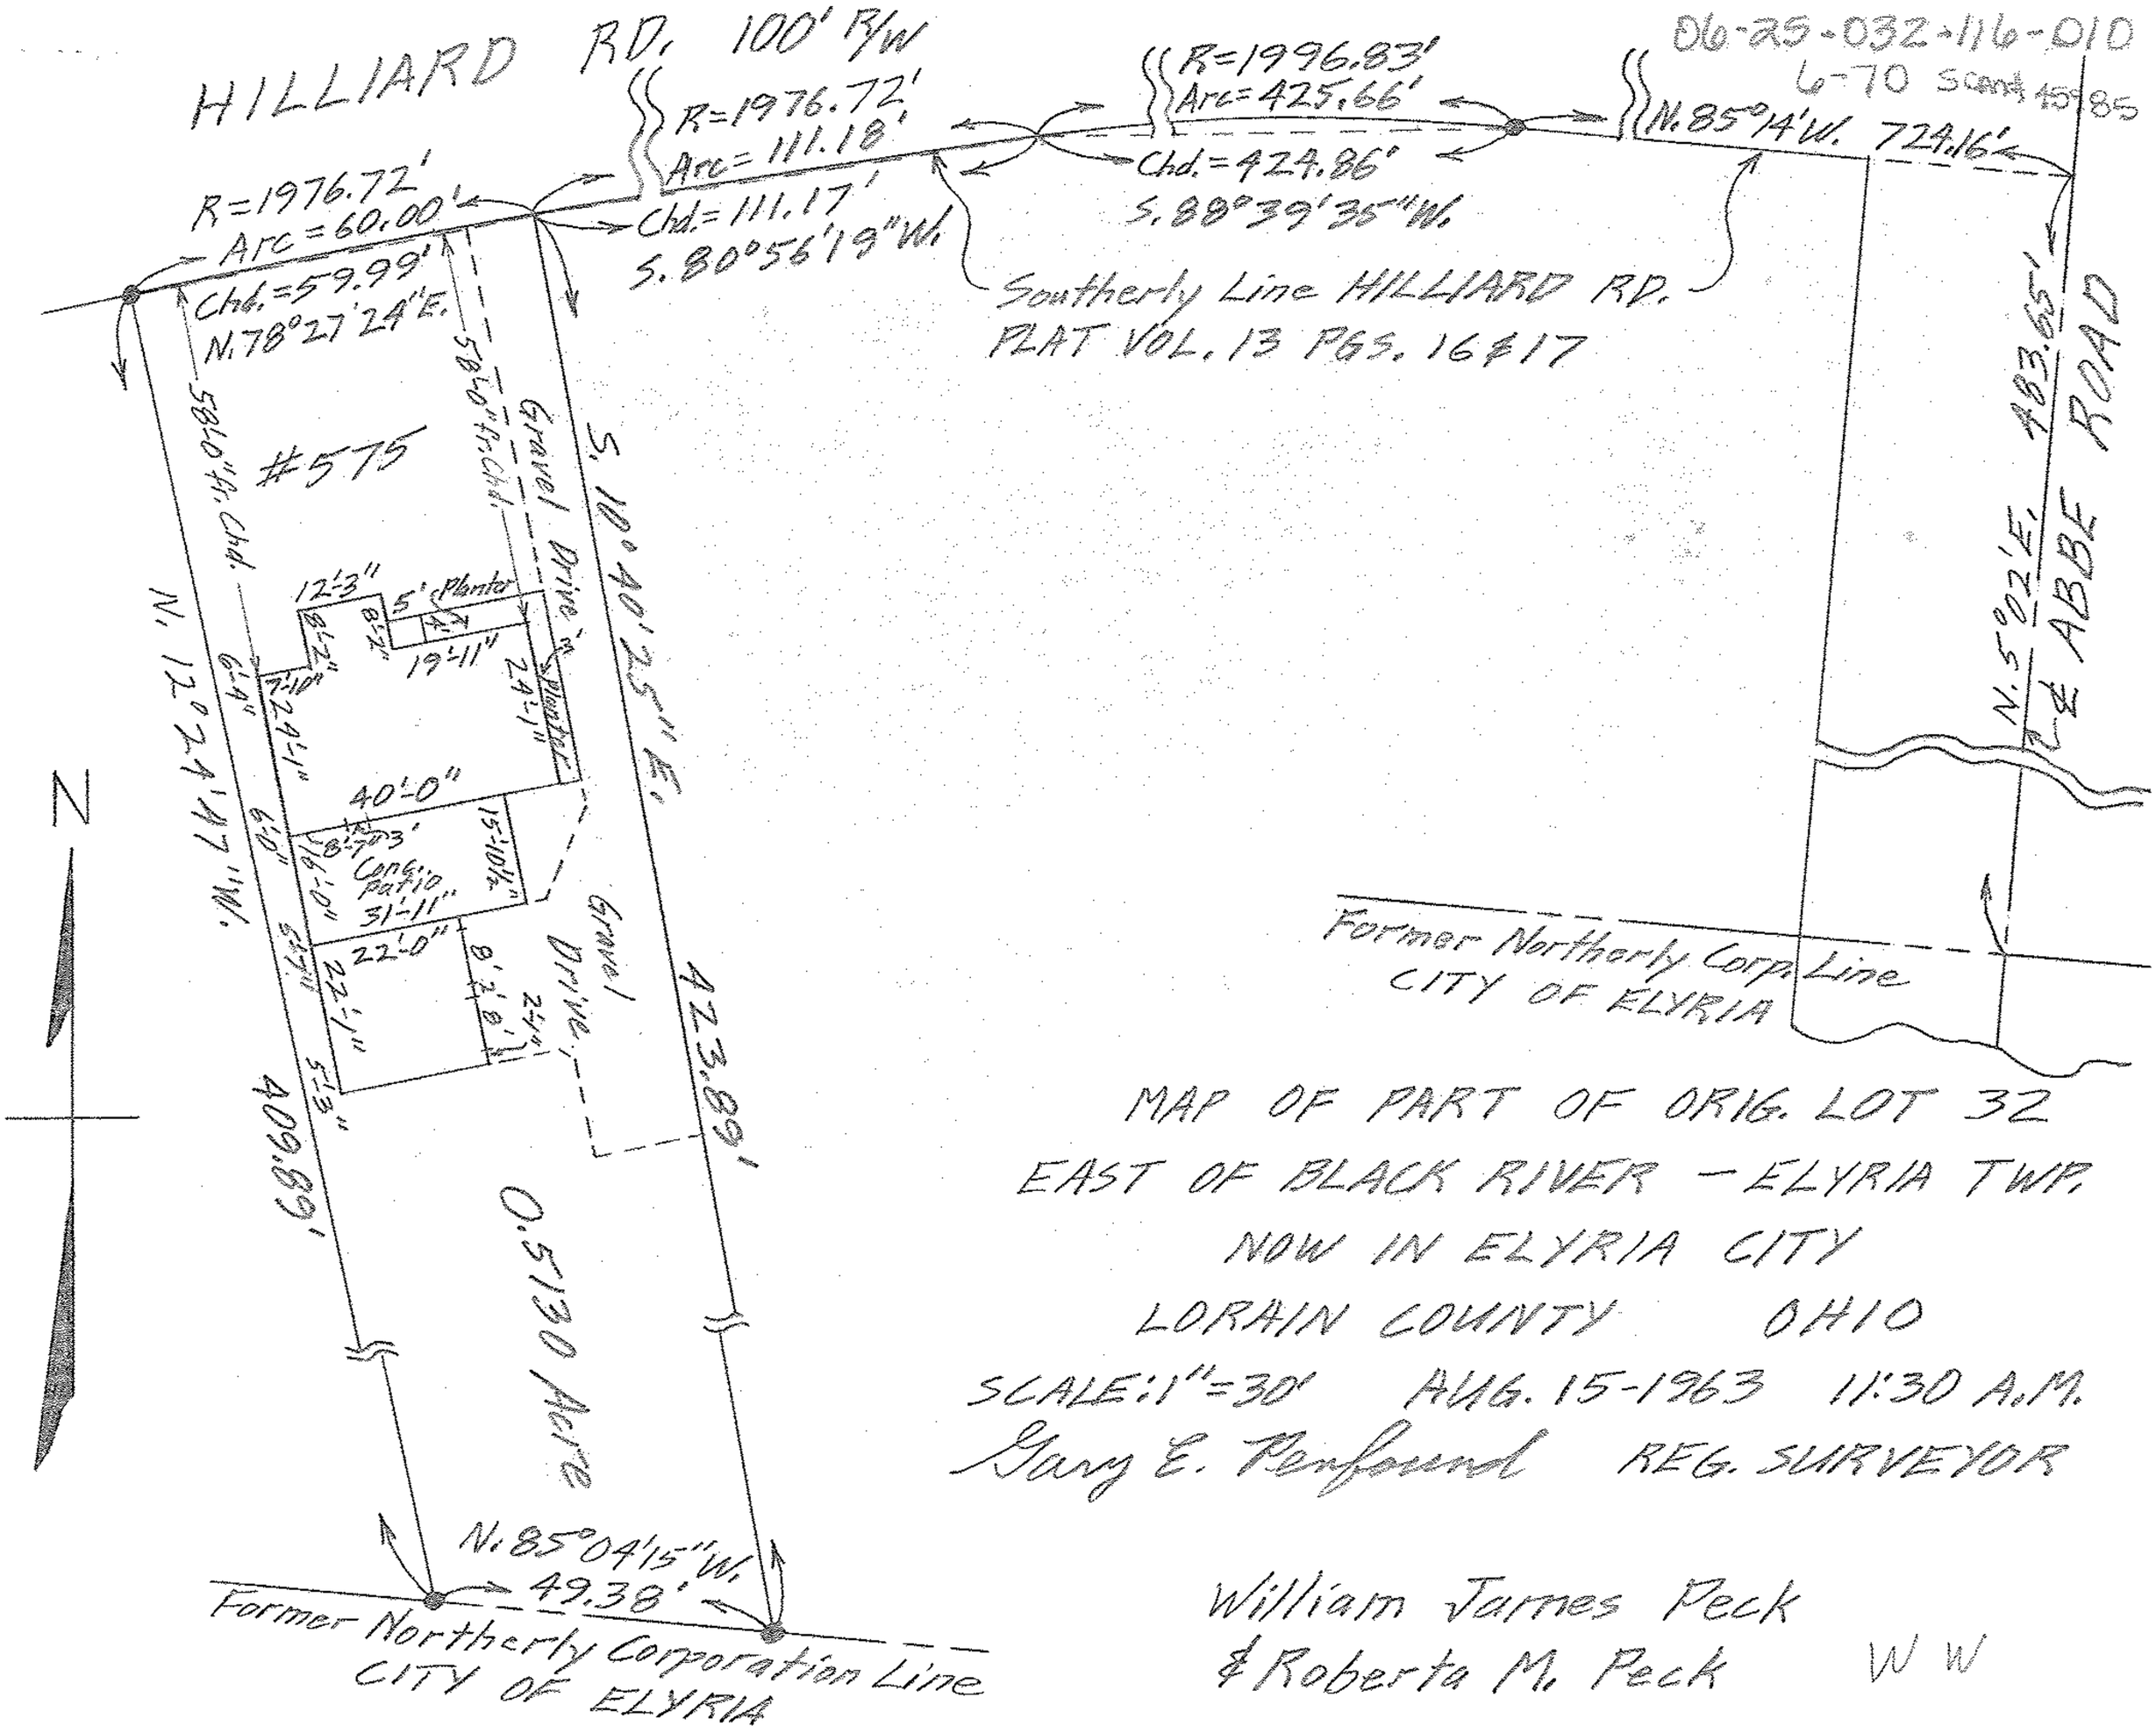

MAP OF PART OF ORIG. LOT 32
EAST OF BLACK RIVER - ELYRIA TWP.
NOW IN ELYRIA CITY
LORAIN COUNTY OHIO
SCALE: 1" = 30' AUG. 15-1963 11:30 A.M.
Gary E. Penfound REG. SURVEYOR

William James Peck
& Roberta M. Peck

W W