06-25-033-101-011, 012, 013

SCAN# 45987

6-68

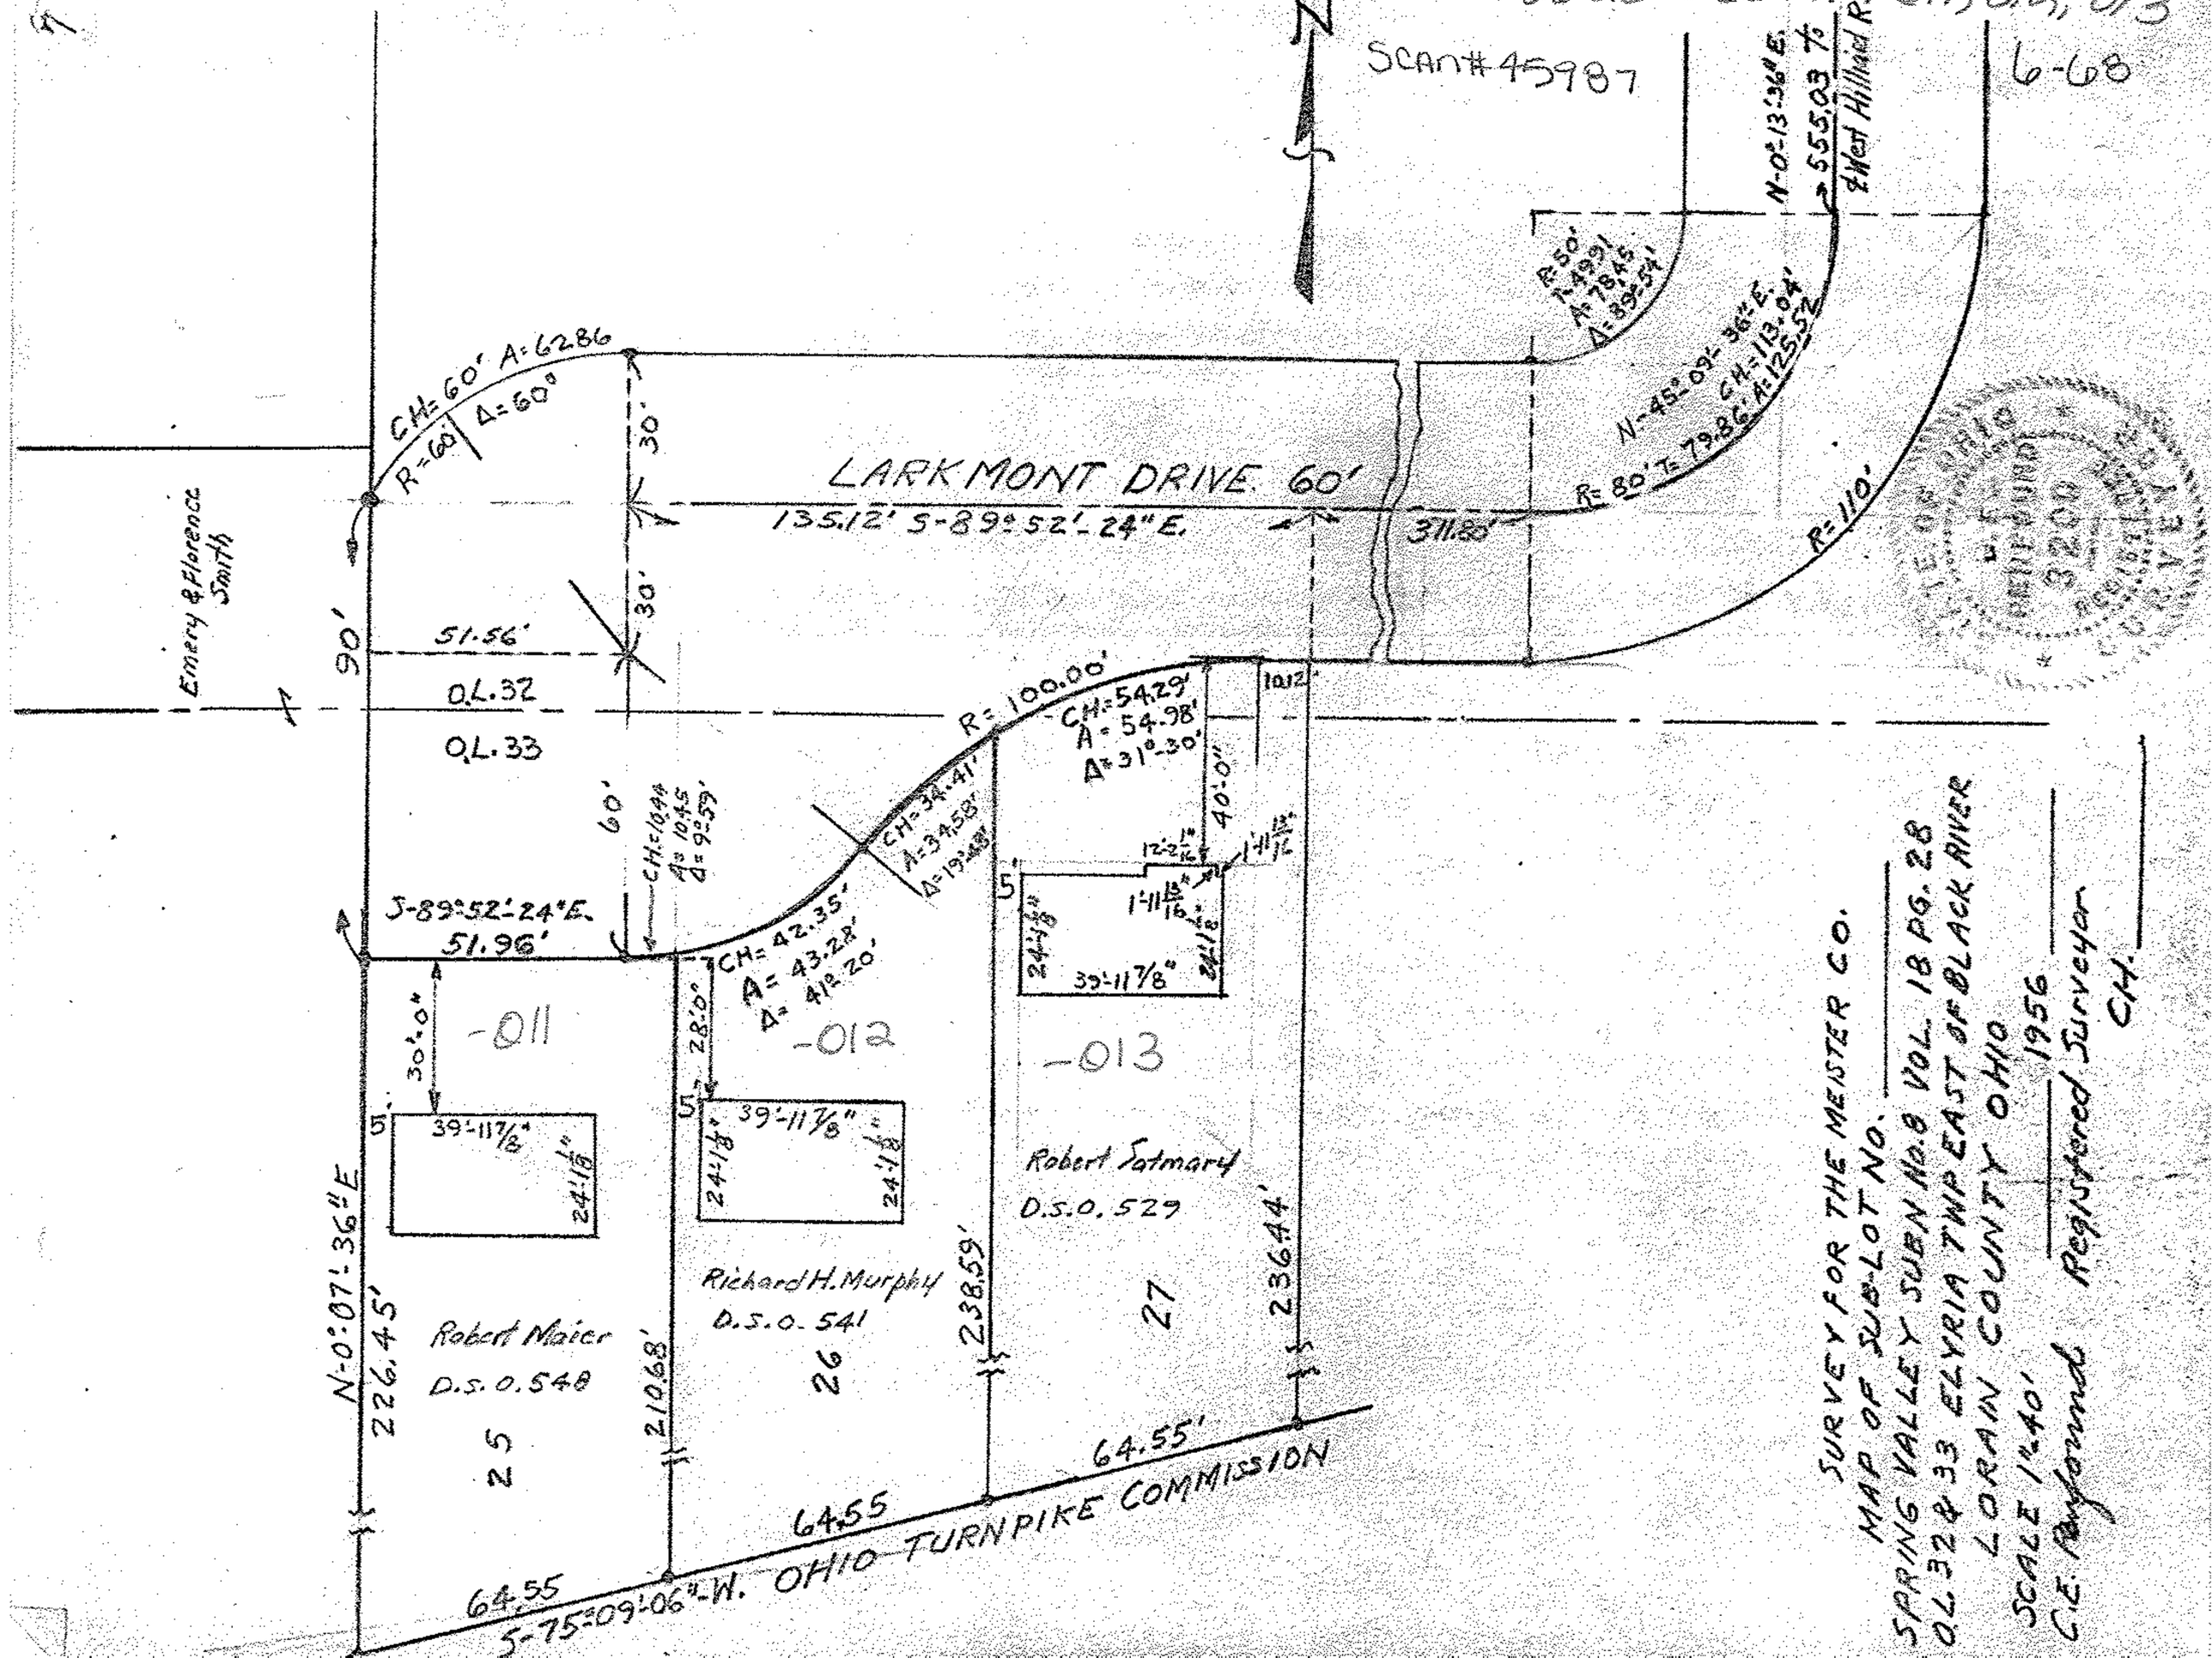

SURVEY FOR THE MEISTER CO.
MAP OF SUB-LOT NO. _____
SPRING VALLEY SUBN NO. 8 VOL. 18 PG. 28
O.L. 32 & 33 ELYRIA TWP EAST OF BLACK RIVER
LORAIN COUNTY OHIO
SCALE 1"=40' 1956
C.E. Ranfound Registered Surveyor
CH. _____