6-25-035-105-004
6-84
Scan #4992

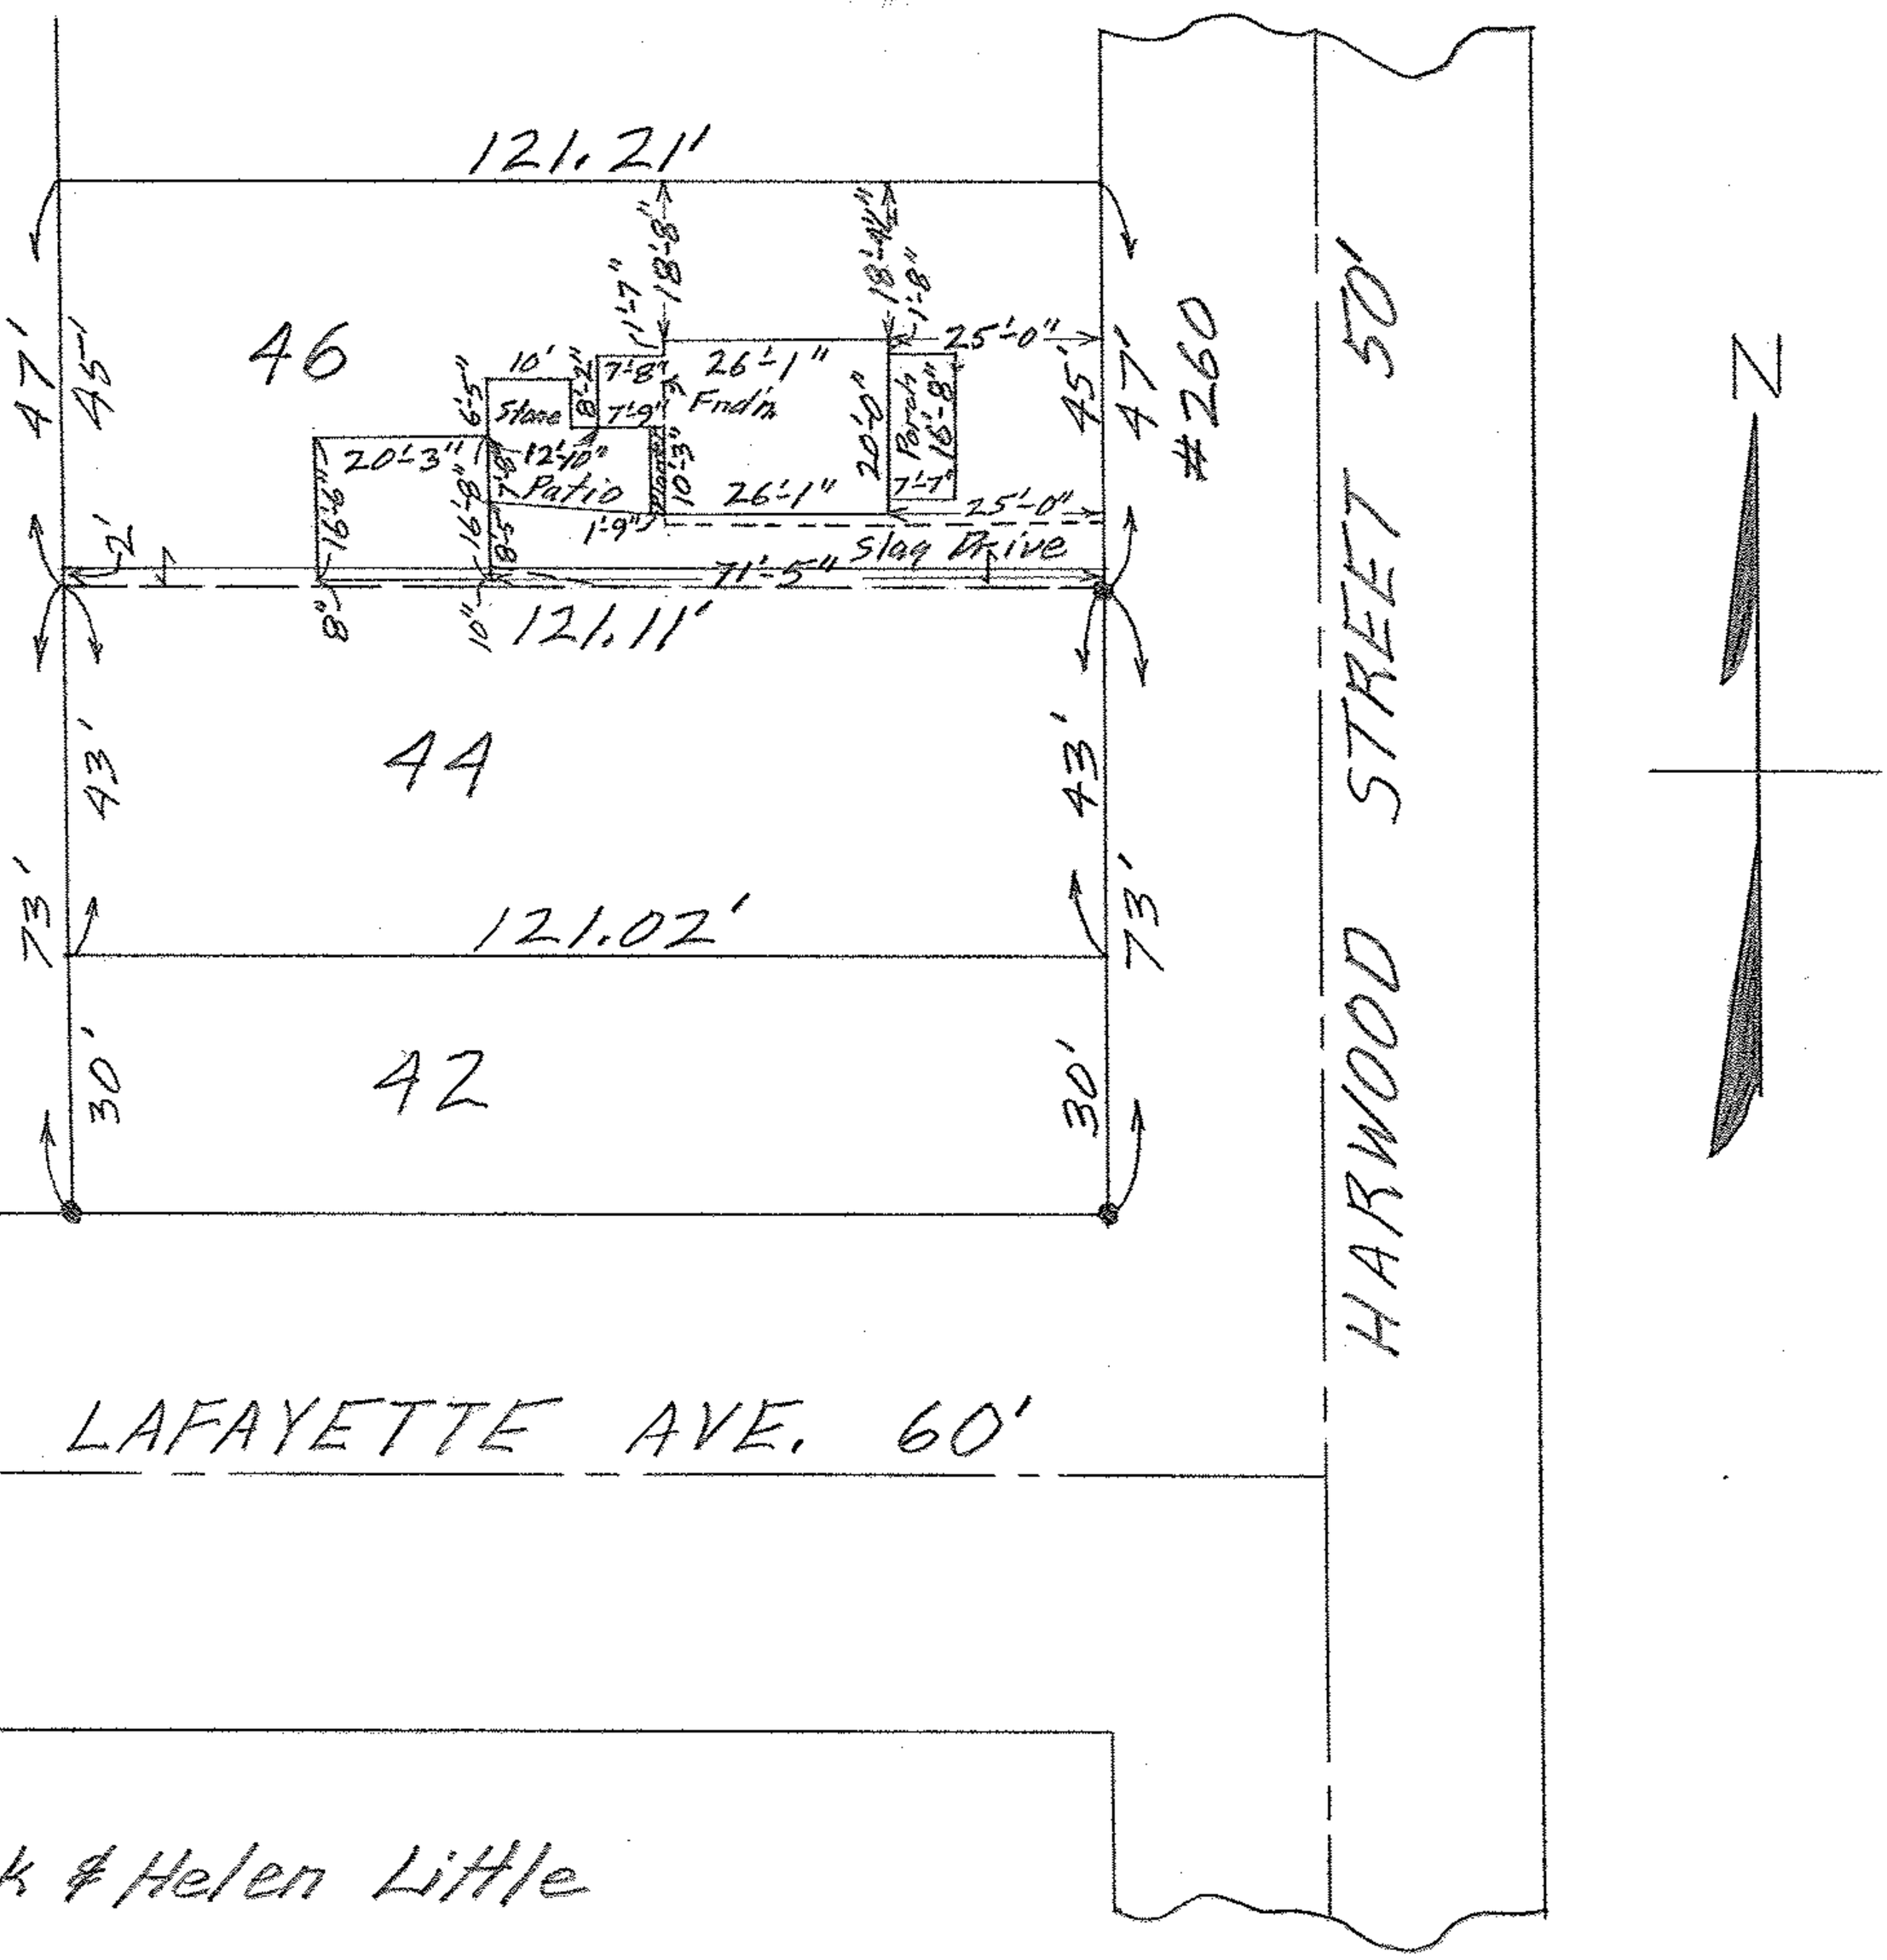

Jack & Helen Little

MAP OF SUB-LOT NO. 46 AND THE
NORTHERLY 2' OF SUB-LOT NO. 44
R. B. LERSCH ALL'T. VOL. 6 PG. 22 PLATS
ELYRIA TWP. ELYRIA CITY
LORAIN COUNTY OHIO
SCALE: 1" = 30' JUNE 20-1963 12:30 P.M.
Gary E. Penfound REG. SURVEYOR

W W