

Anne Ekelovsky & Stephen J. Shulik  
D. Vol. 378 P. 921


Florence M. Durmen, Ralph W. Storden  
& Grace L. Meacham D. Vol. 277 P. 419

Albert R. Haake  
D. Vol. 447 P. 235

Nelson & Naomi O. Harman  
D. Vol. 338 P. 269

Gabriel W. & Lillian Enyedy.  
D. Vol. 311-P. 144.

J.M. & Stella James  
2  
R.B. LERSCH ADDN

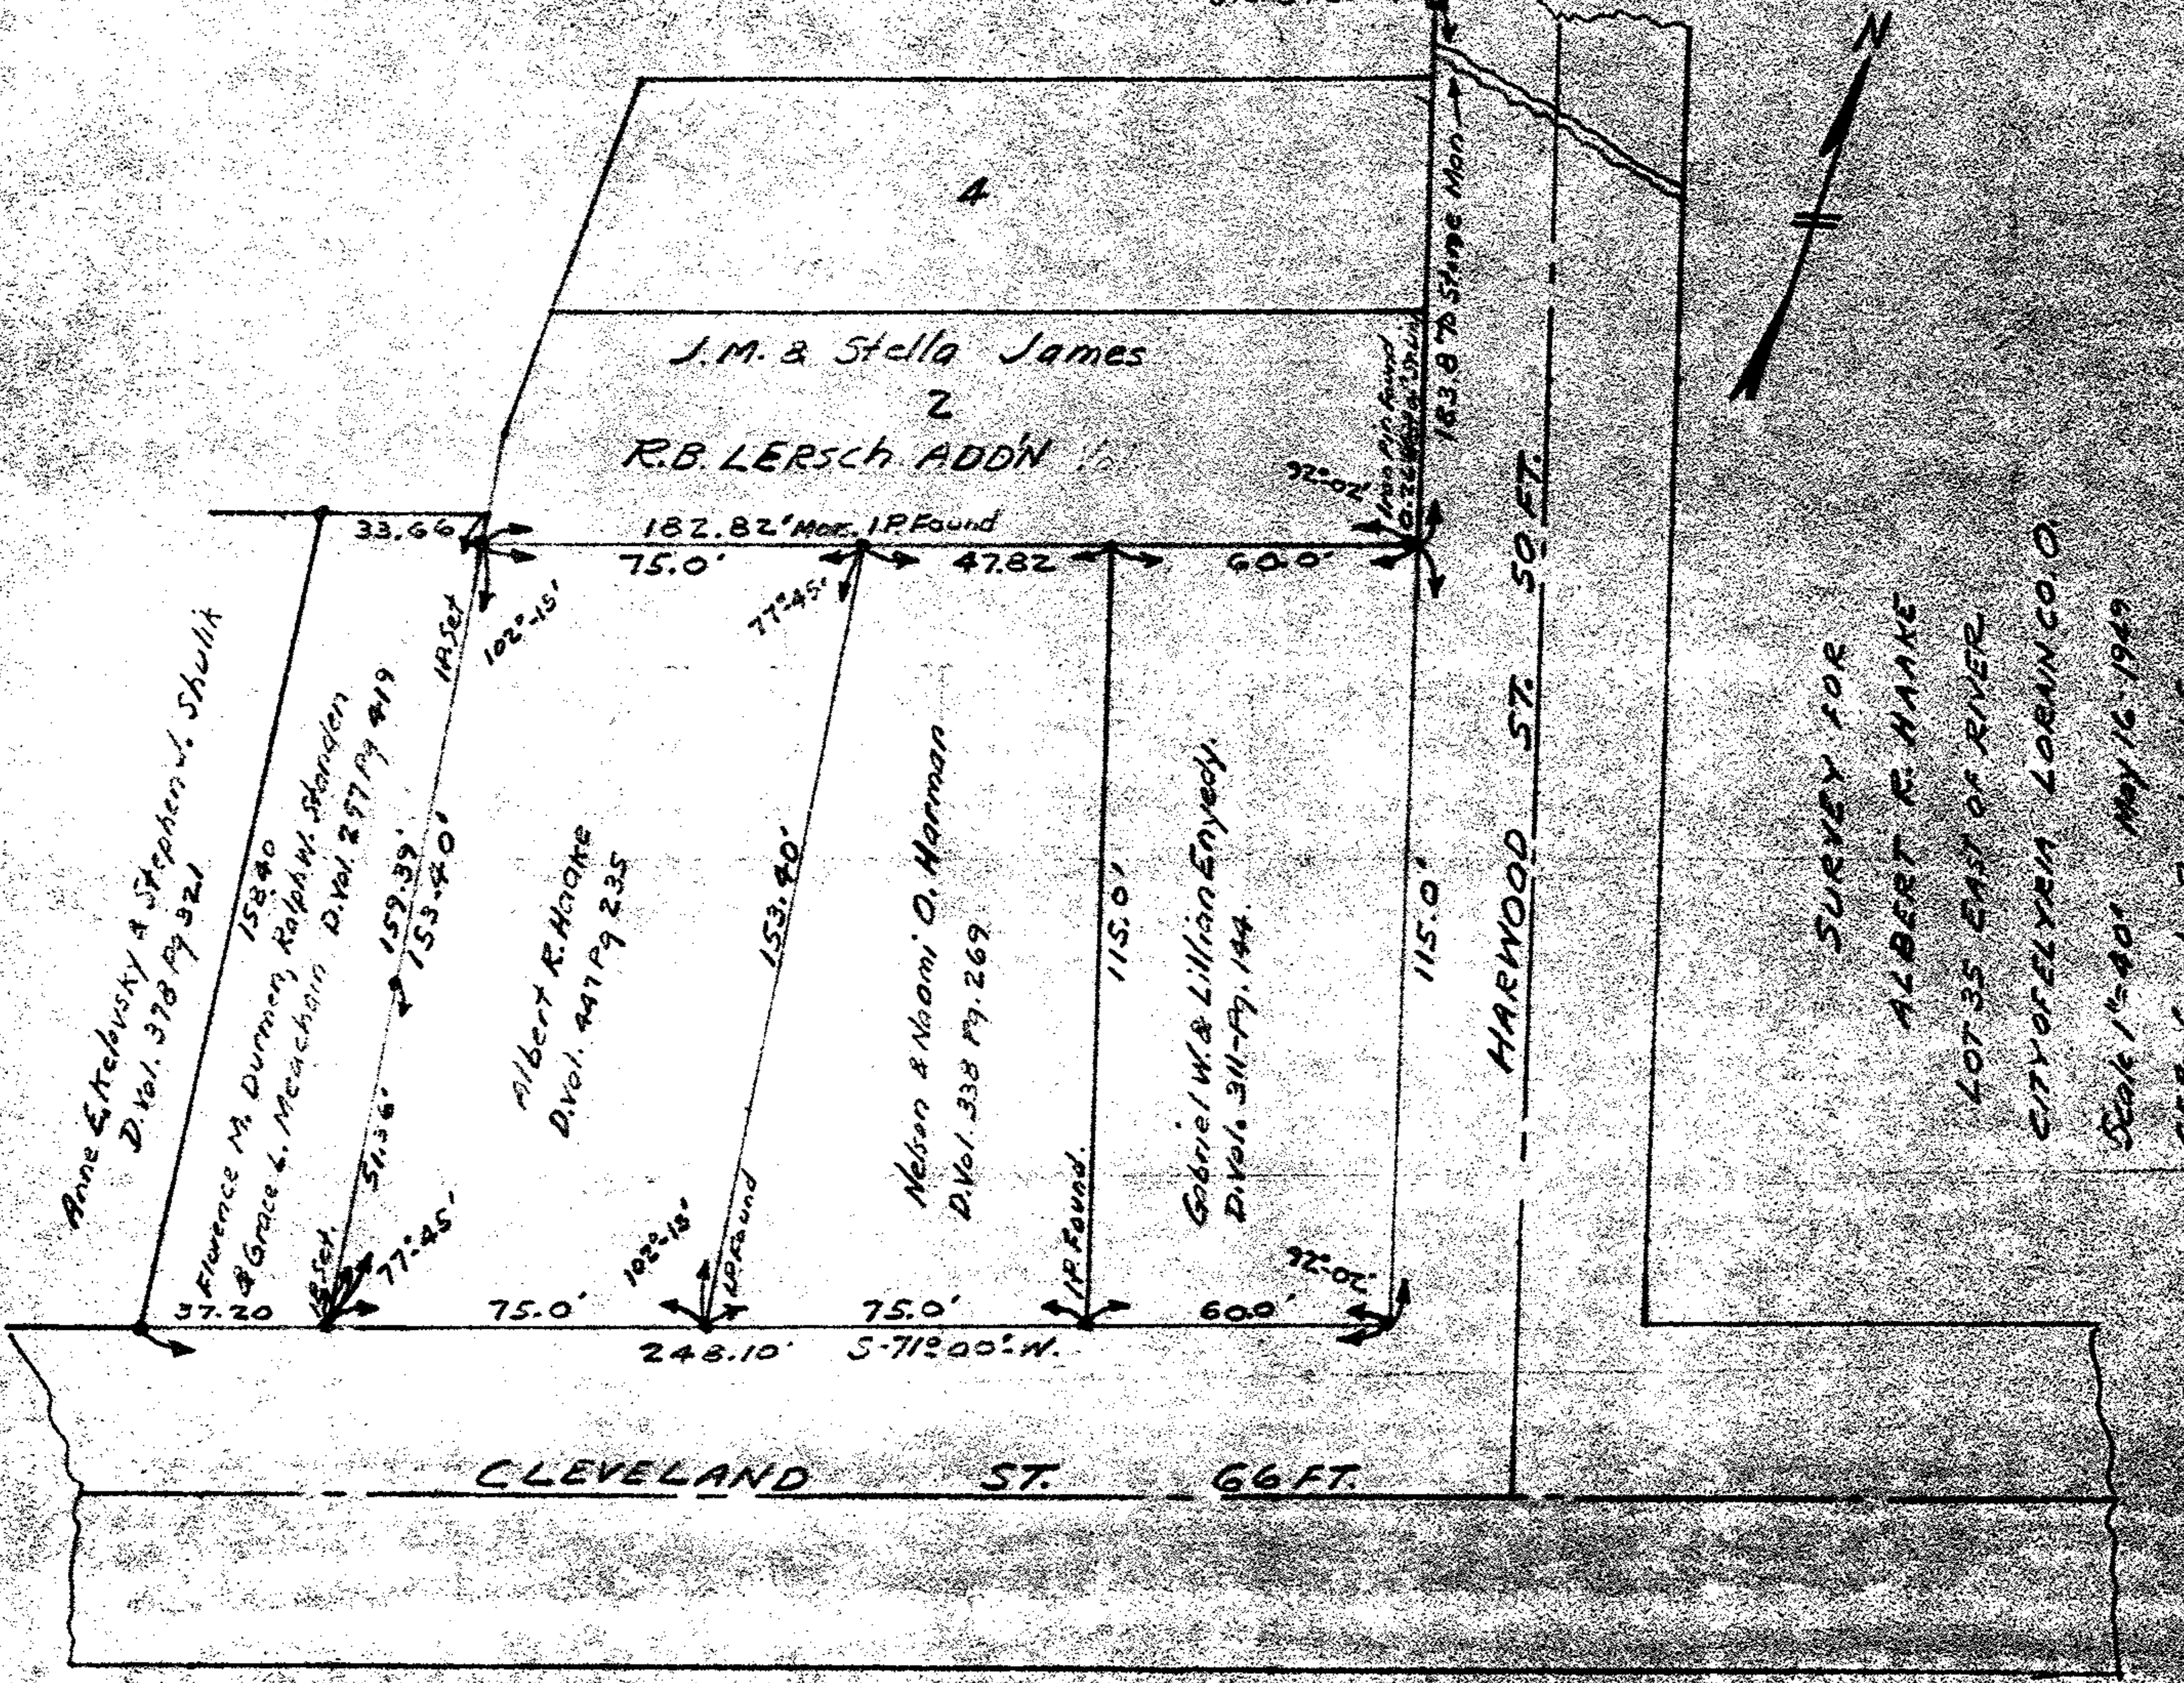

37.20'

33.66'

102°-15'  
102°-15'  


159.39'

153.40'

77°-45'

75.0'

182.82' Mor. I.P. Found

75.0'

47.82'

60.0'

248.10' S-71°-00'-W.

153.40'

75.0'

115.0'

60.0'

115.0'

HARWOOD ST. 50 FT.

CLEVELAND ST. 66 FT.

Stone Found

Stone Found

SURVEY FOR  
ALBERT R. HAAKE  
LOT 35 EAST OF RIVER  
Scale 1"=40' May 16, 1949  
C. E. Penfound Registered Surveyor