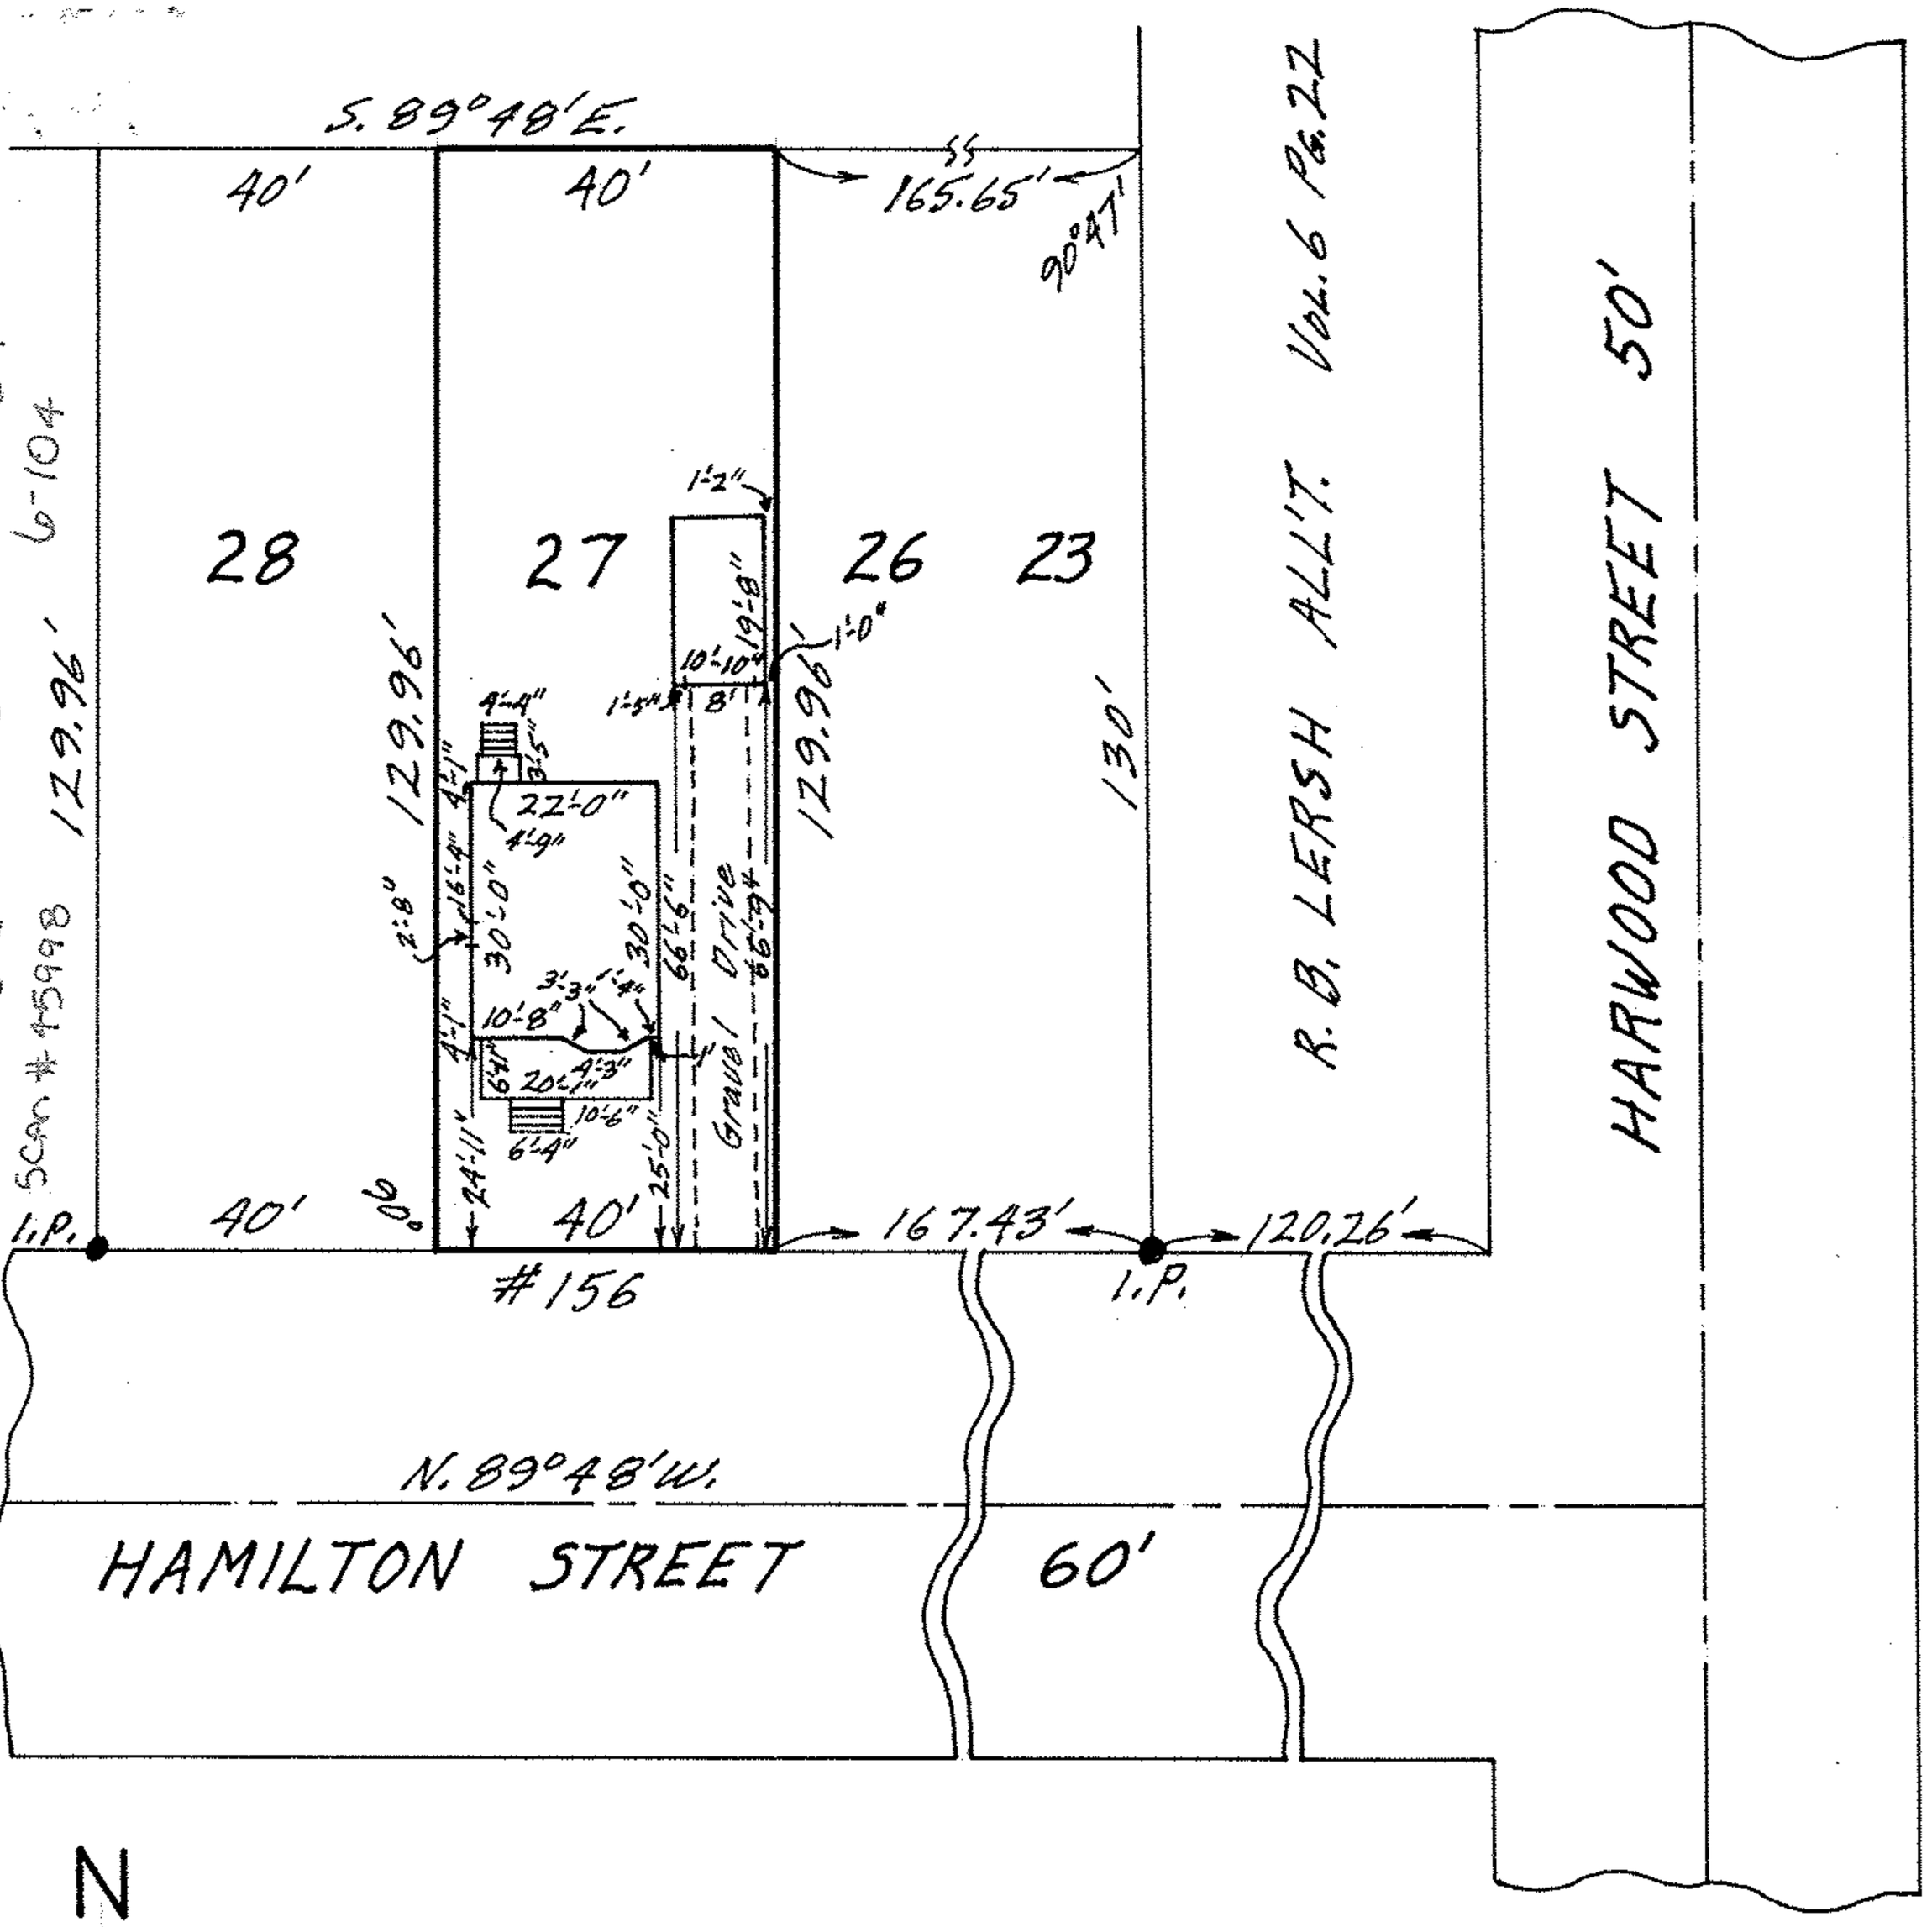

MAP OF SUB-LOT NO. 27

H. W. INGERSOLL'S SUB'N. NO. 1 VOL. 7 PG. 43

O.L. 36 EAST OF BLACK RIVER ELYRIA TWP.

ELYRIA CITY LORAIN COUNTY OHIO

SCALE: 1" = 30' NOV. 6 -1966 2:00 P.M.

Gary E. Penfound
for C. E. Penfound REG. SURVEYORS

G.L. 1746 Donald & Laura Fiebiger