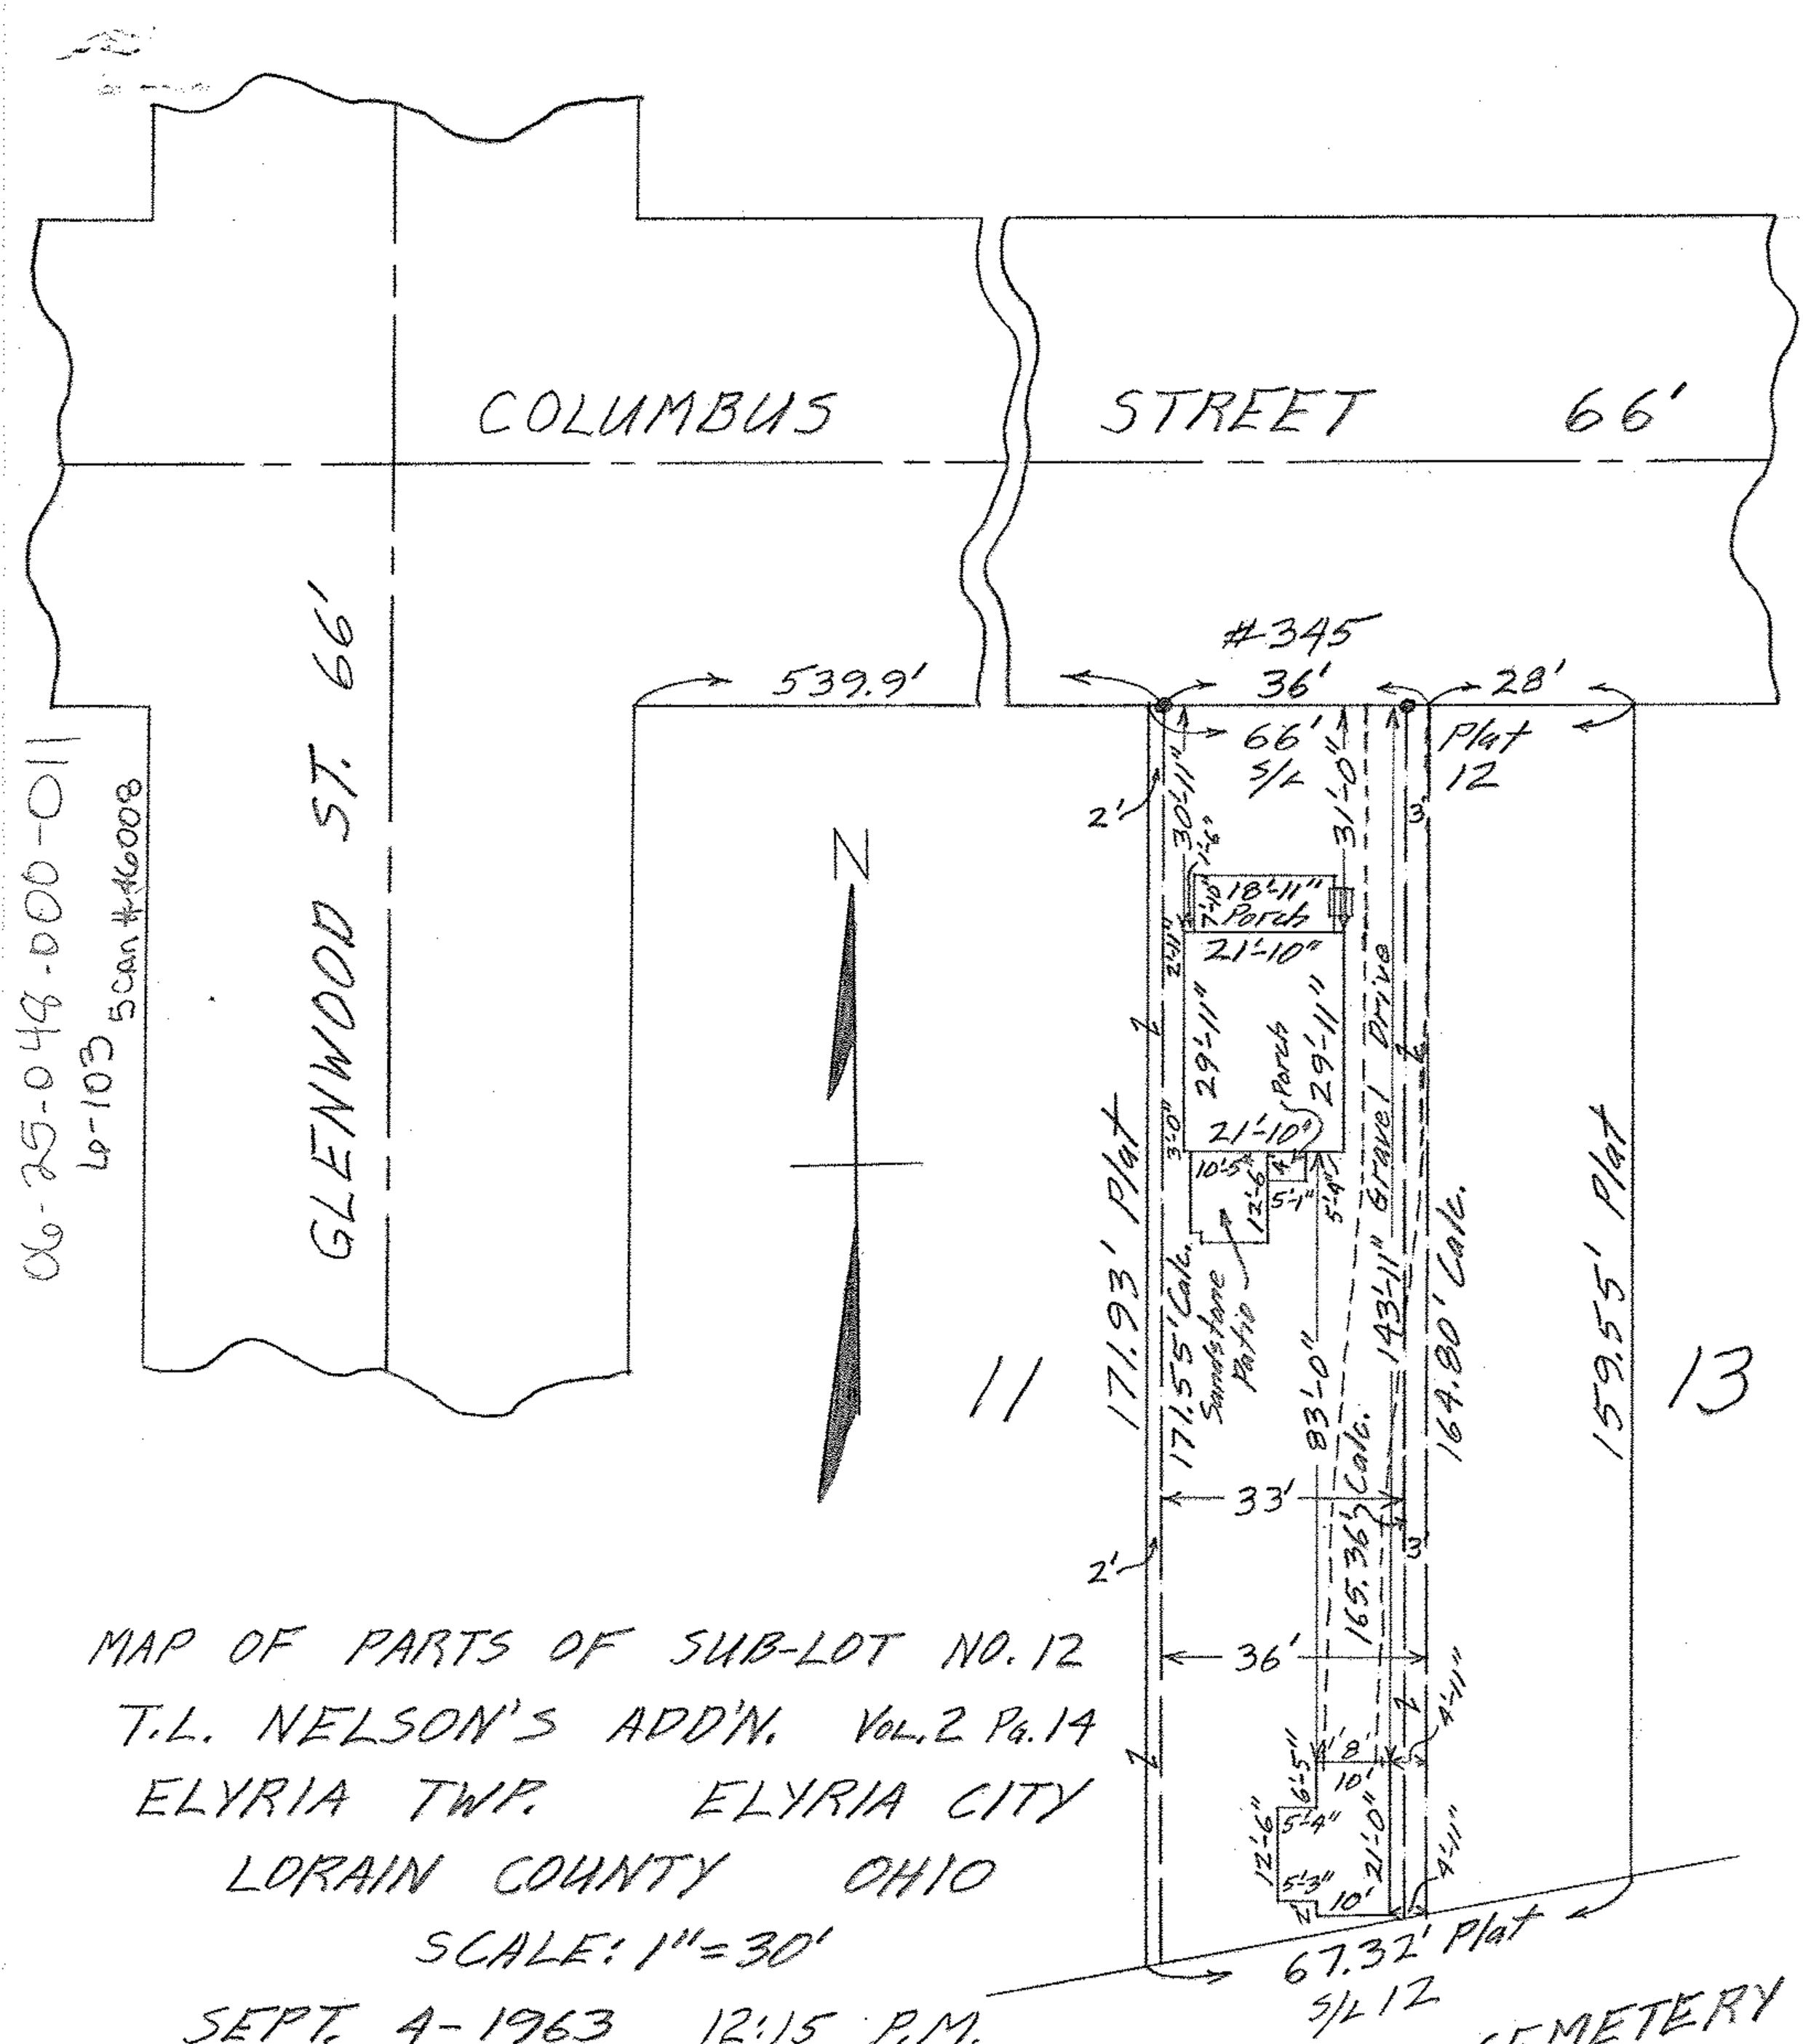

Lo-25-048-000-011
Lo-103 Scan #46008

MAP OF PARTS OF SUB-LOT NO. 12
T.L. NELSON'S ADD'N. VOL. 2 PG. 14
ELYRIA TWP. ELYRIA CITY
LORAIN COUNTY OHIO
SCALE: 1" = 30'
SEPT. 4-1963 12:15 P.M.
Gary E. Penfound REG. SURVEYOR RIDGELAWN CEMETERY

John W Collins & Rhoda R Collins

W W