06-25-004-000-004
6-103
Scan #40013

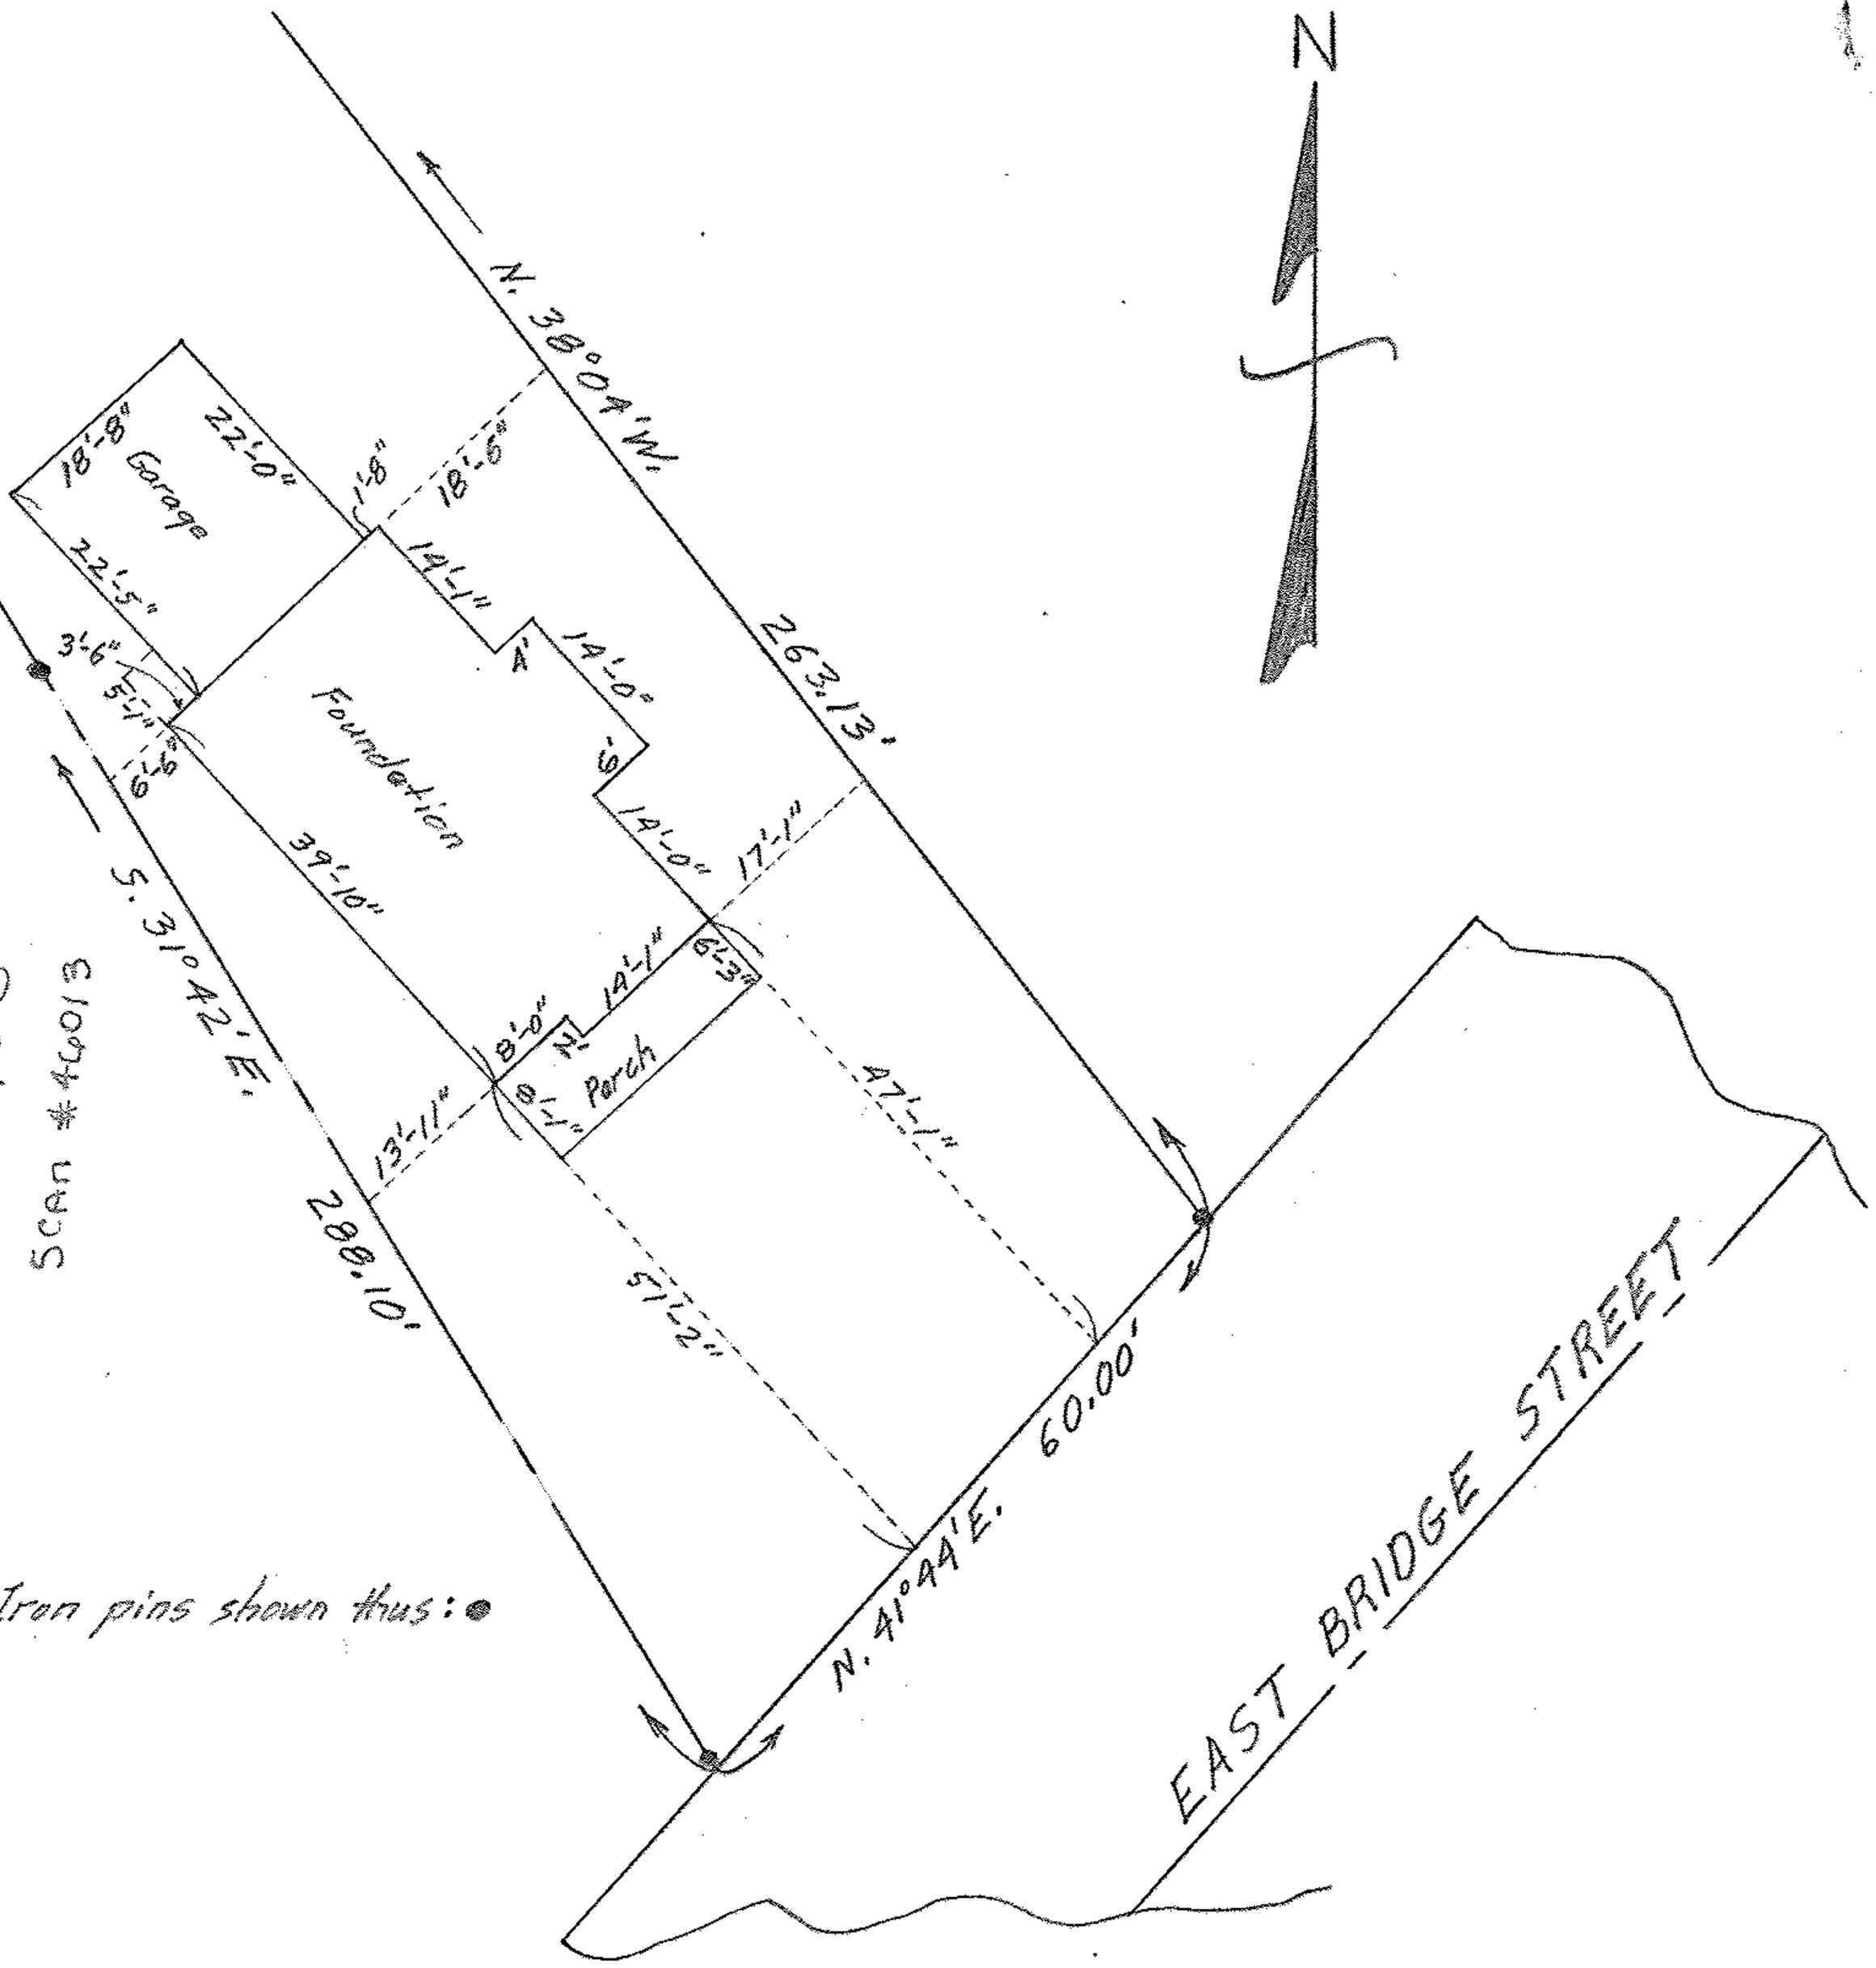

NOTE: Iron pins shown thus: ●

PLAT OF SURVEY FOR ALBERT F. KAYE

LOCATION OF BUILDING ON LAND OF HOWARD AND MARY BOTAMER

O.L. 64 EAST OF RIVER ELYRIA TOWNSHIP

ELYRIA CITY – LORAIN COUNTY – OHIO

SCALE: 1" = 20' AUGUST 15, 1956

C.E. Perfound Registered Surveyor