MAP OF SUB-LOT NO. 2

THE EASTERN HEIGHTS LAND CO.'S SUB'N. NO. 1 Vol. 6 Pg. 23
ELYRIA TWP. - ELYRIA CITY - LORAIN COUNTY - OHIO
SCALE: 1" = 30' SEPT. 8-1969 8:15 P.M.
NOTE: There are no encroachments on this property.
Gary E. Penfound REG. SURVEYOR NO. 4457
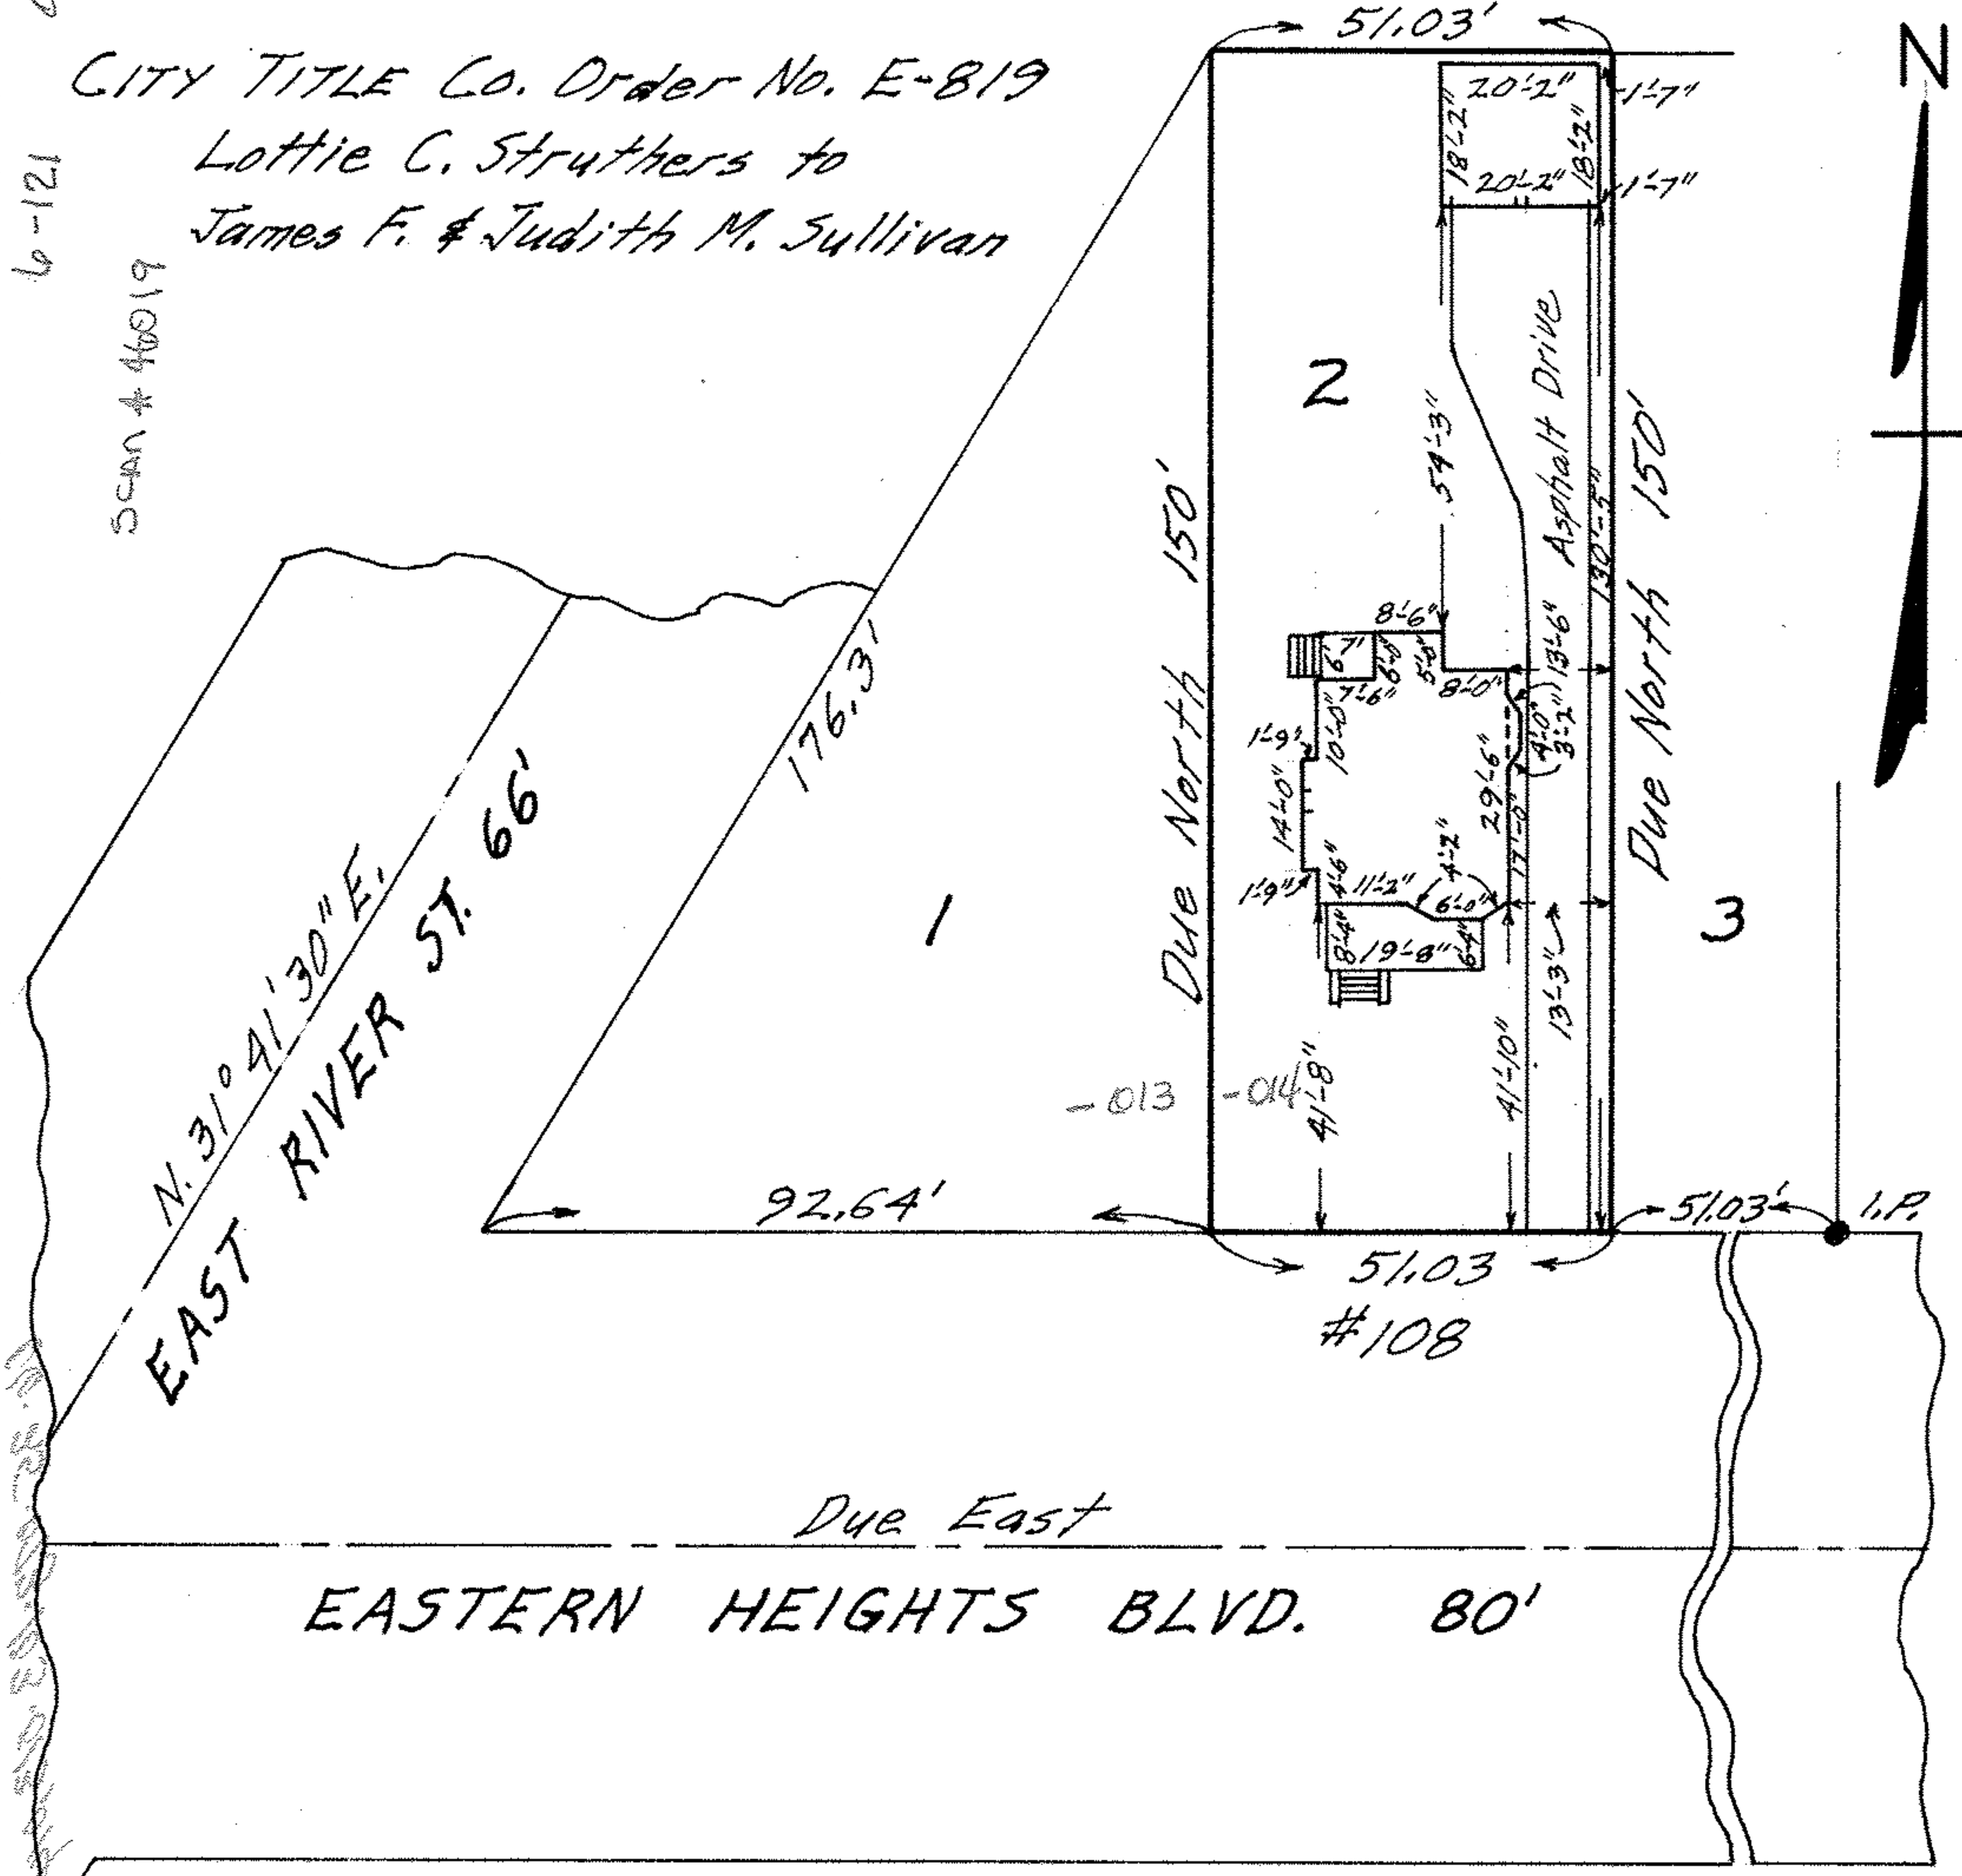
CITY TITLE Co. Order No. E-819
Lottie C. Struthers to
James F. & Judith M. Sullivan