06-25-075-103-007

06-25-075-103-007

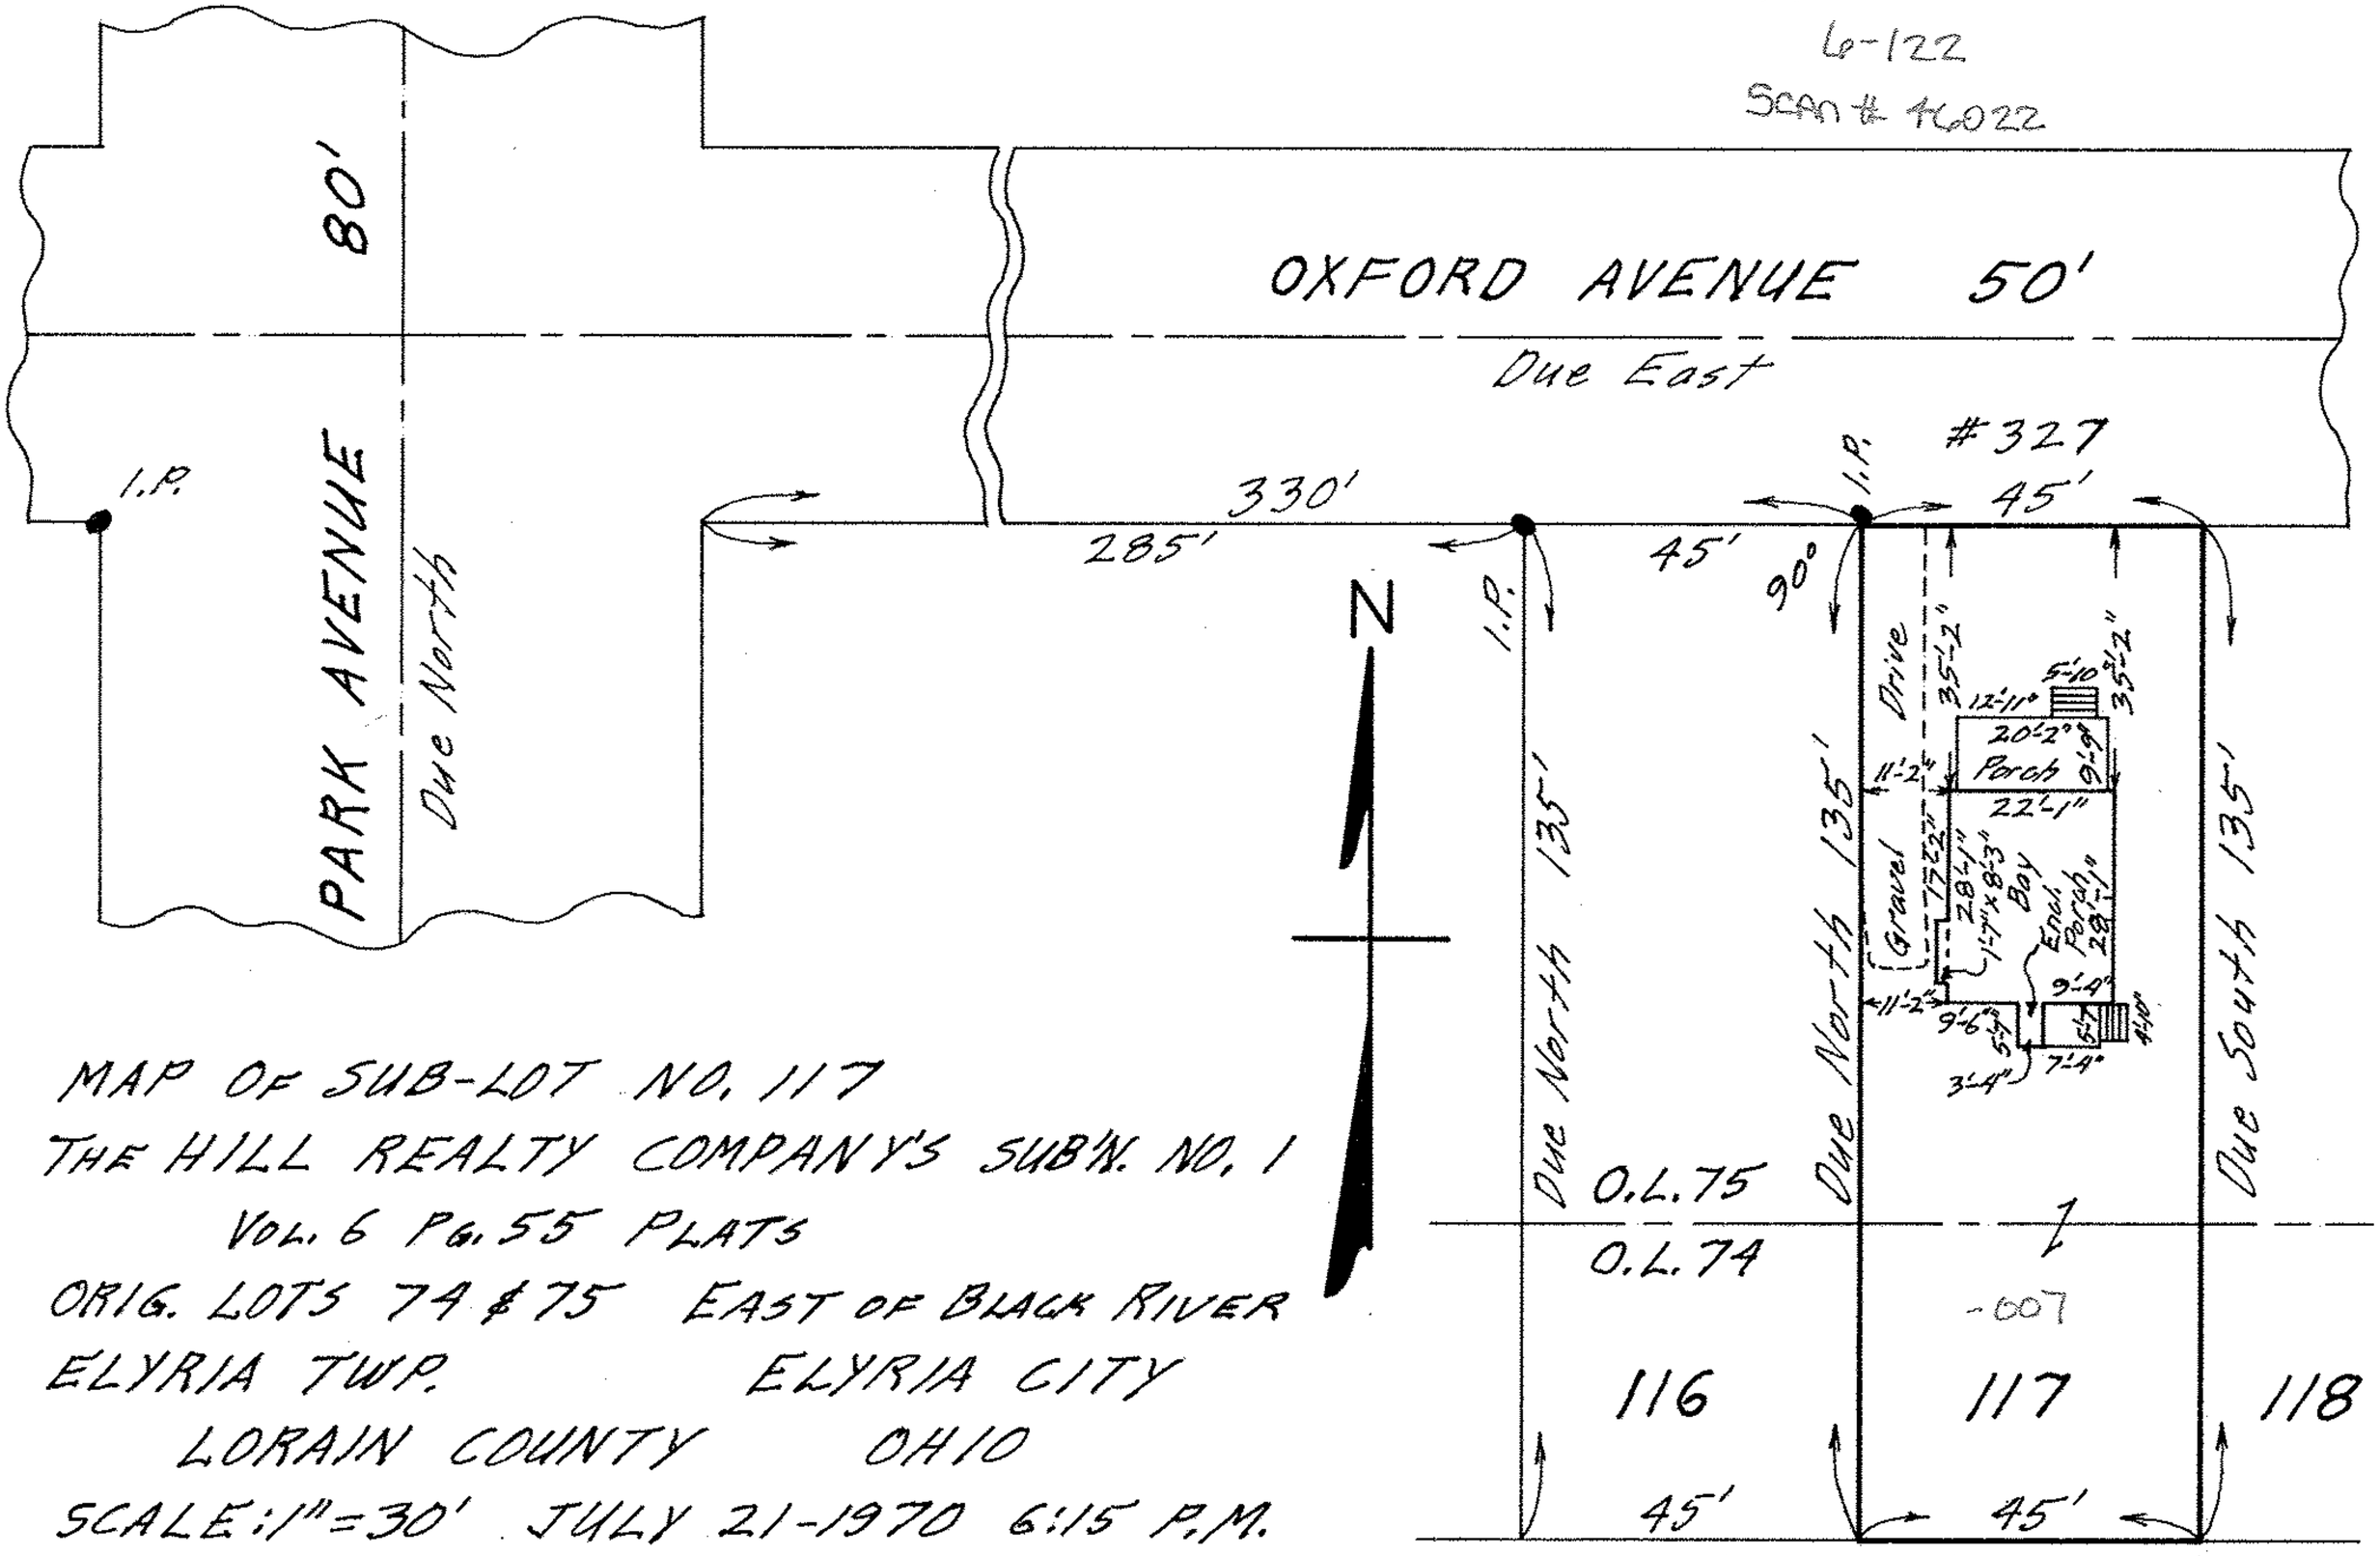

MAP OF SUB-LOT NO. 117
THE HILL REALTY COMPANY'S SUB'N. NO. 1
VOL. 6 PG. 55 PLATS
ORIG. LOTS 74 & 75 EAST OF BLACK RIVER
ELYRIA TWP. ELYRIA CITY
LORAIN COUNTY OHIO
SCALE: 1" = 30' JULY 21-1970 6:15 P.M.
NOTE: There are no encroachments on this property.
Gary E. Penfound REG. SURVEYOR NO. 4457

CITY TITLE Co. Order No. E-1202-3 Lindquist to Cheney