SUBLOTS 8, 9, 10, & 43 OF LAUNDON ALLOTMENT
LORAIN COUNTY PLAT VOL. 8, PG 1
PART OF ORIG. LOT'S 77 & 78 - EAST OF RIVER
LOCATED IN CITY OF ELYRIA, OHIO

S.L. 8	- P.P. # 06-25-077-102-002	DEED VOL. 670	PG 489
S.L. 9	" " -003	" " 600	" 52
S.L. 10	" " -004	" " 511	" 75
S.L. 43	" " -007	" " 891	" 363

TOPOGRAPHIC SURVEY & PLOT PLAN
FOR
FRIENDLY ICE CREAM CORPORATION

1855 BOSTON ROAD
WILBRAHAM, MASSACHUSETTS
& CHICAGO TITLE INSURANCE COMPANY
BY

McGLINCHY & ASSOCIATES
538 W. BROAD ST.-SUITE 403
ELYRIA, OHIO 44035
PROJECT 75209 MAR 26, 1975 DLI

STATE OF OHIO LAWRENCE V. McGLINCHY 4970 REGISTERED SURVEYOR

STATE OF OHIO LAWRENCE V. McGLINCHY 27501 REGISTERED PROFESSIONAL ENGINEER

THIS SURVEY IS TO BE CERTIFIED TO FRIENDLY ICE CREAM CORPORATION AND ANY TITLE INSURANCE CO OF FRIENDLY ICE CREAM CORP'S CHOOSING.

1" = 10'

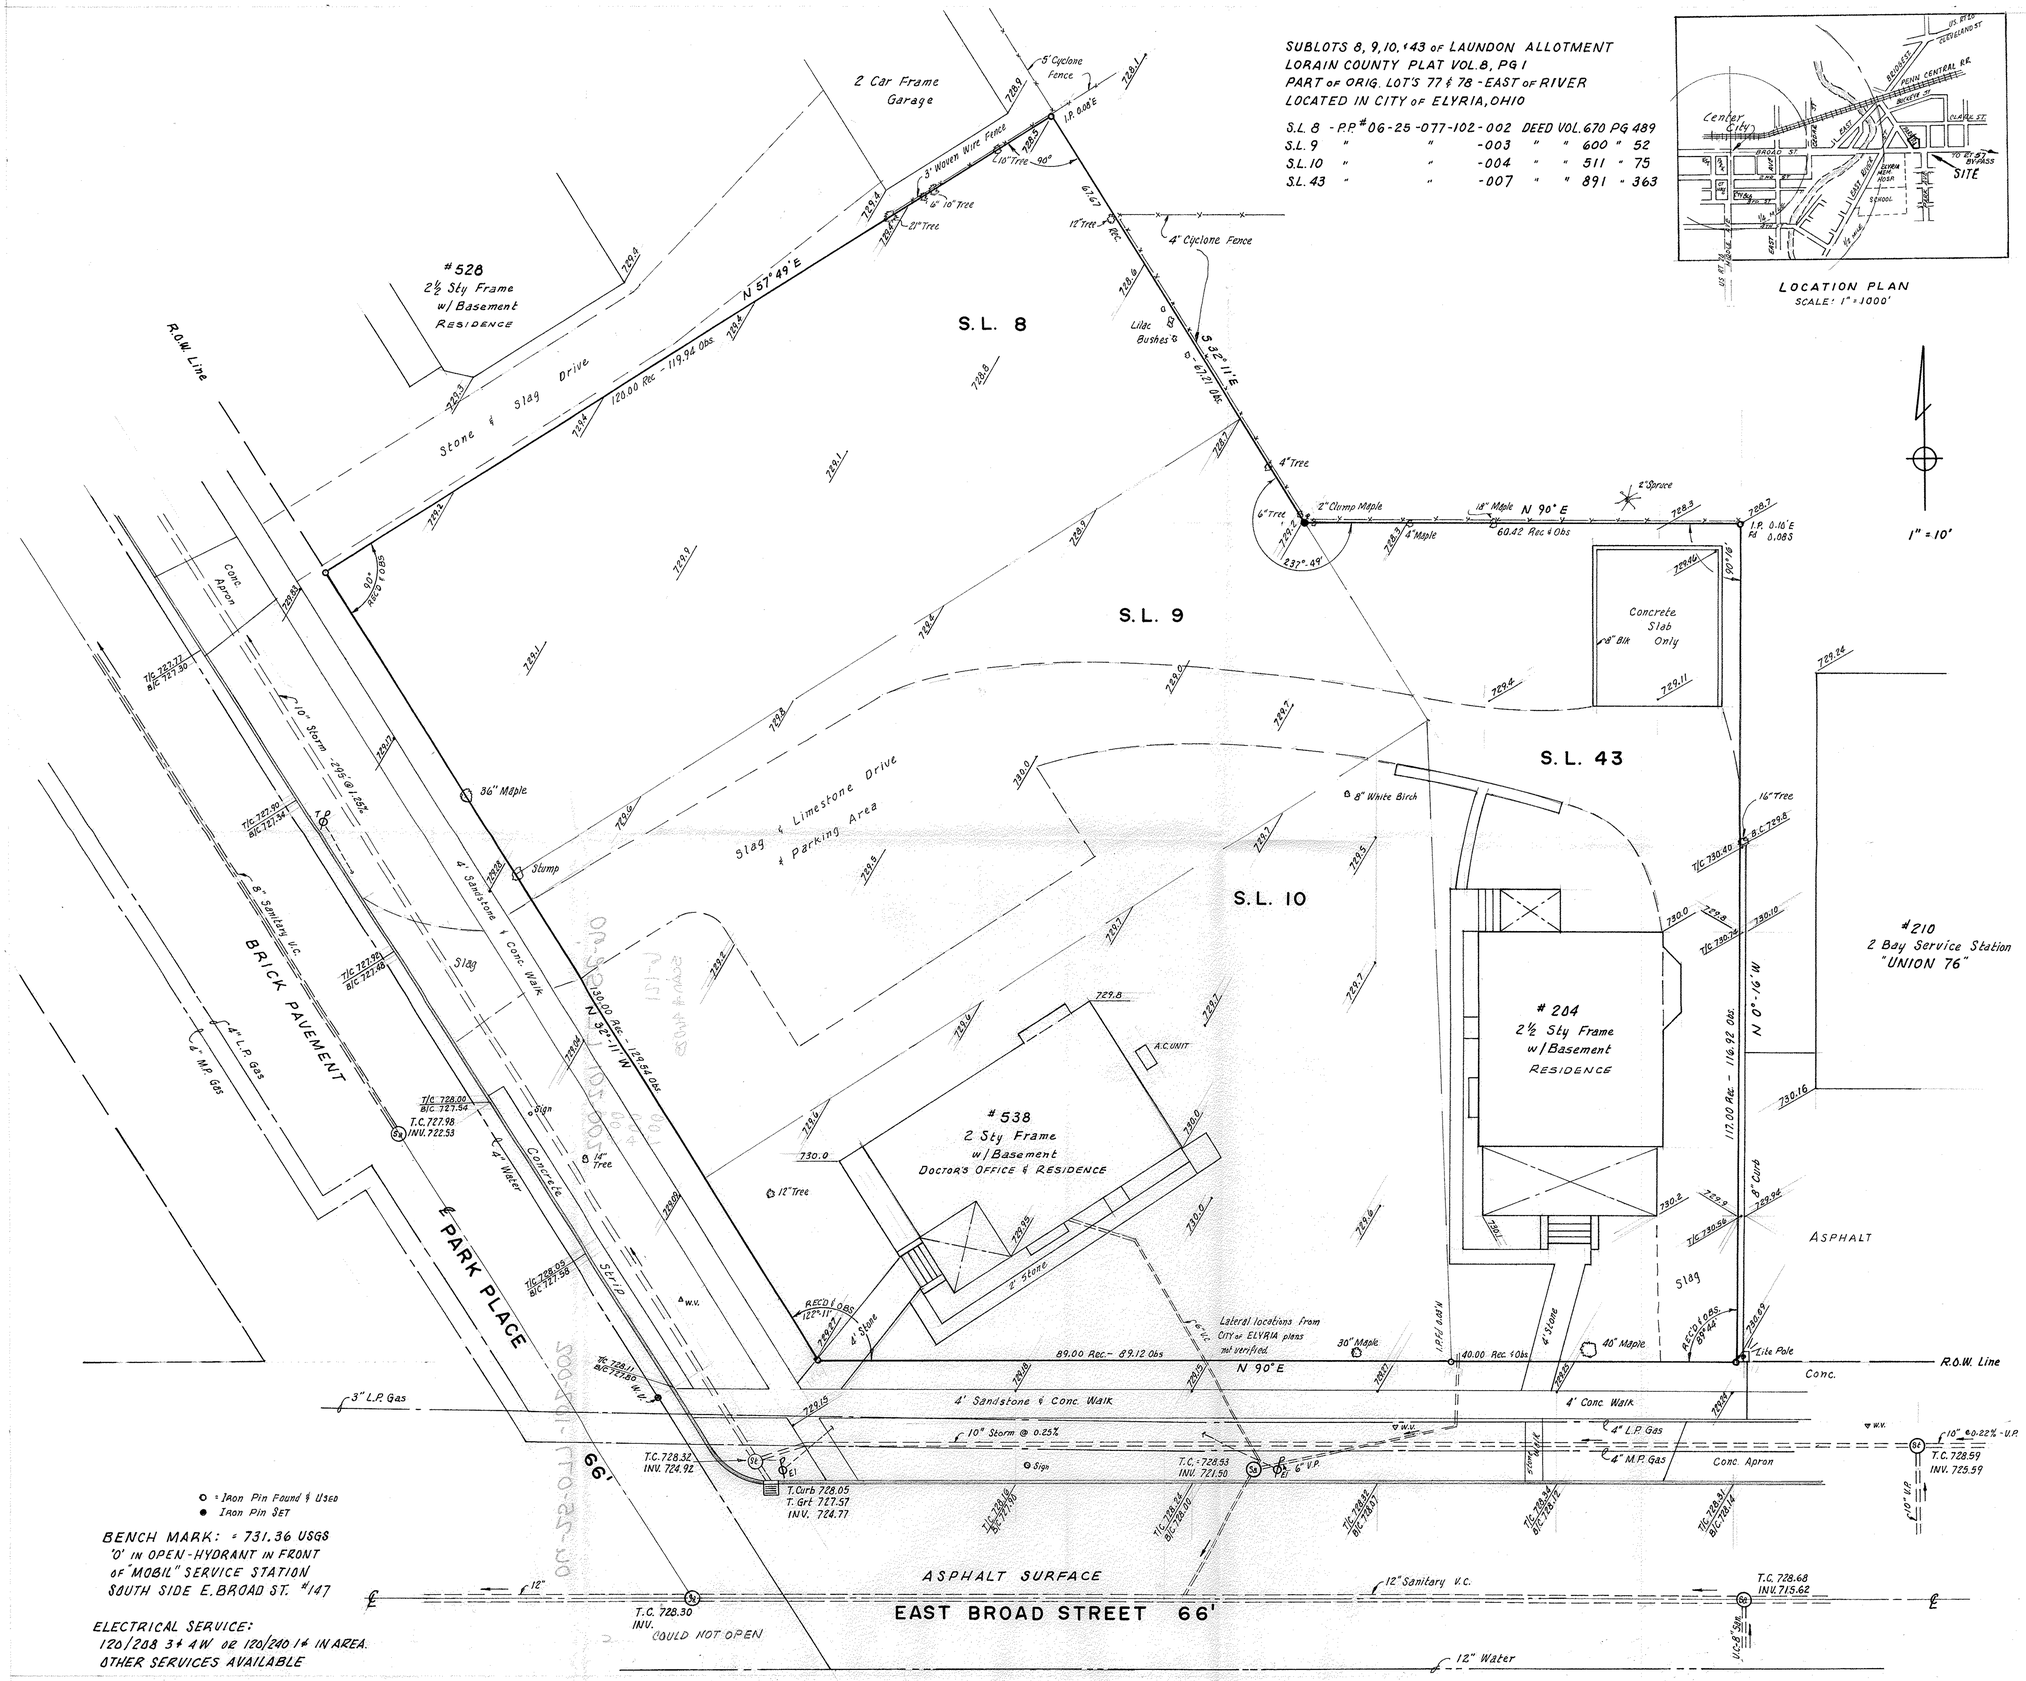

○ = Iron Pin Found & Used
● Iron Pin Set

BENCH MARK: = 731.36 USGS
"0" IN OPEN-HYDRANT IN FRONT
OF "MOBIL" SERVICE STATION
SOUTH SIDE E. BROAD ST. #147

ELECTRICAL SERVICE:
120/208 3 + 4W OR 120/240 1 ϕ IN AREA.
OTHER SERVICES AVAILABLE