06-25-096-000-014

L-120

Theodore Haury
May 10, 1922 D. Vol. 185 Pg. 216

Scan # 46026

-014

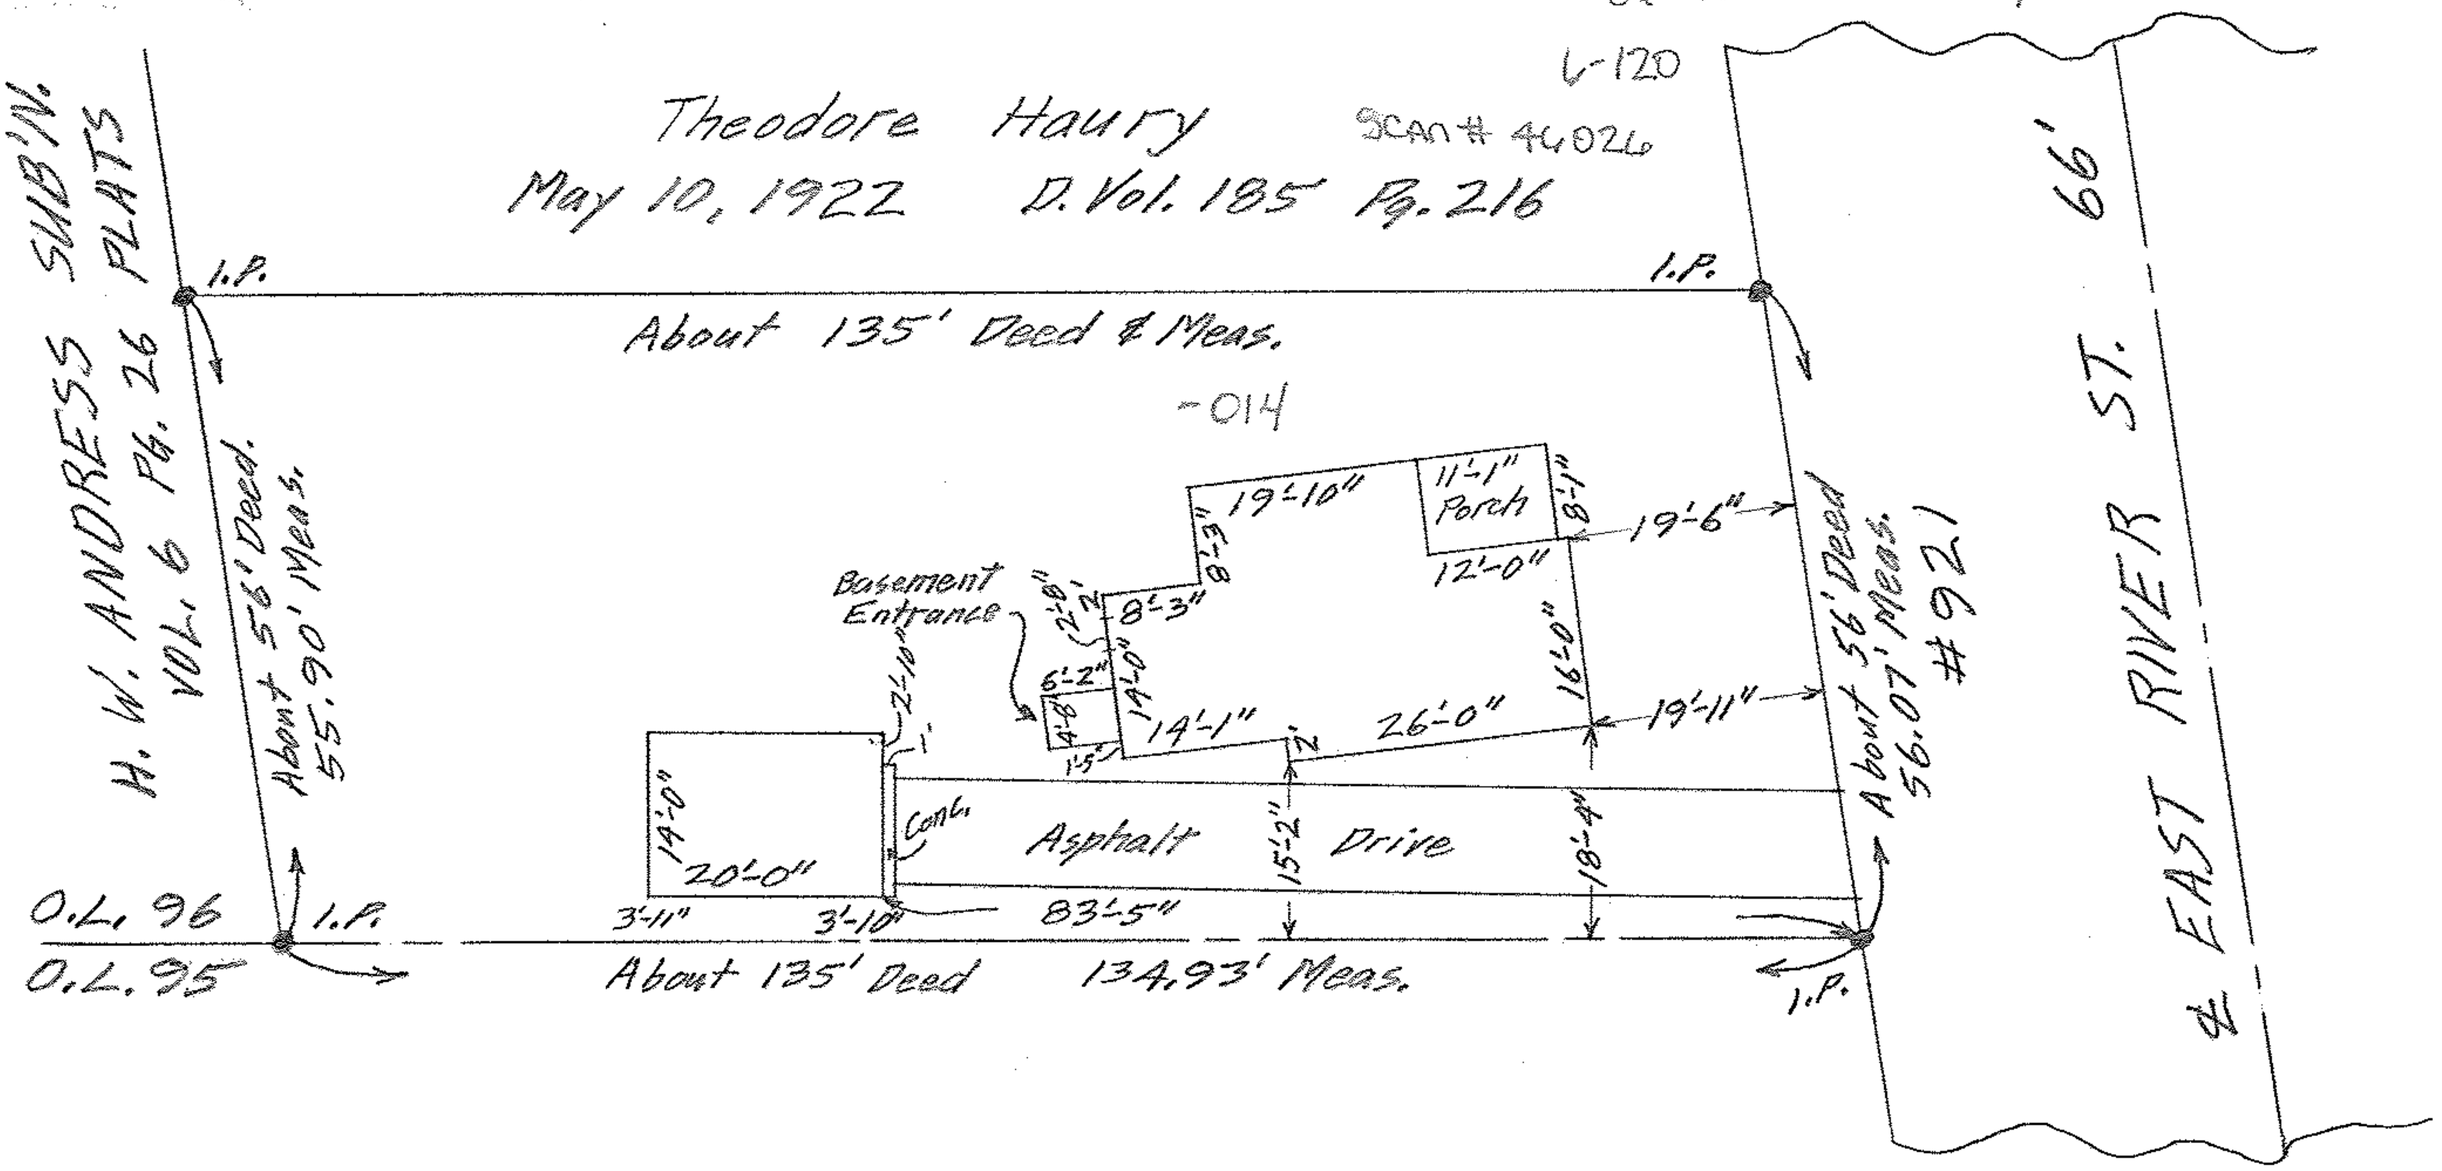

MAP OF PART OF ORIG. LOT NO. 96
EAST OF BLACK RIVER - ELYRIA TWP.
ELYRIA CITY - LORAIN COUNTY - OHIO
SCALE: 1"=20' JUNE 13-1963 11:30 A.M.
Gary E. Penfound REG. SURVEYOR

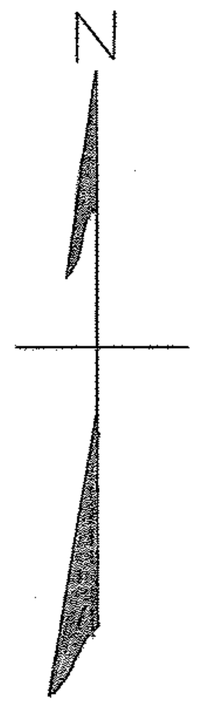

BERKS TITLE INS. CO. Order No. 1206
Kohler to Myers