06-25-176-104-039
-028
6-51
SCAN # 46033

MAP OF SURVEY FOR
W. George Opal
PART OF SUB-LOT 342 SPRING VALLEY
LAND CO. SUBN. NO 4 VOL. 13 PG. 7 & 8
AND PART OF O.L. 176 ELYRIA TWP. EAST OF RIVER
LORAIN COUNTY OHIO
SCALE 1" = 40' AUGUST 20 - 1953
C.E. Penfound Registered Surveyor

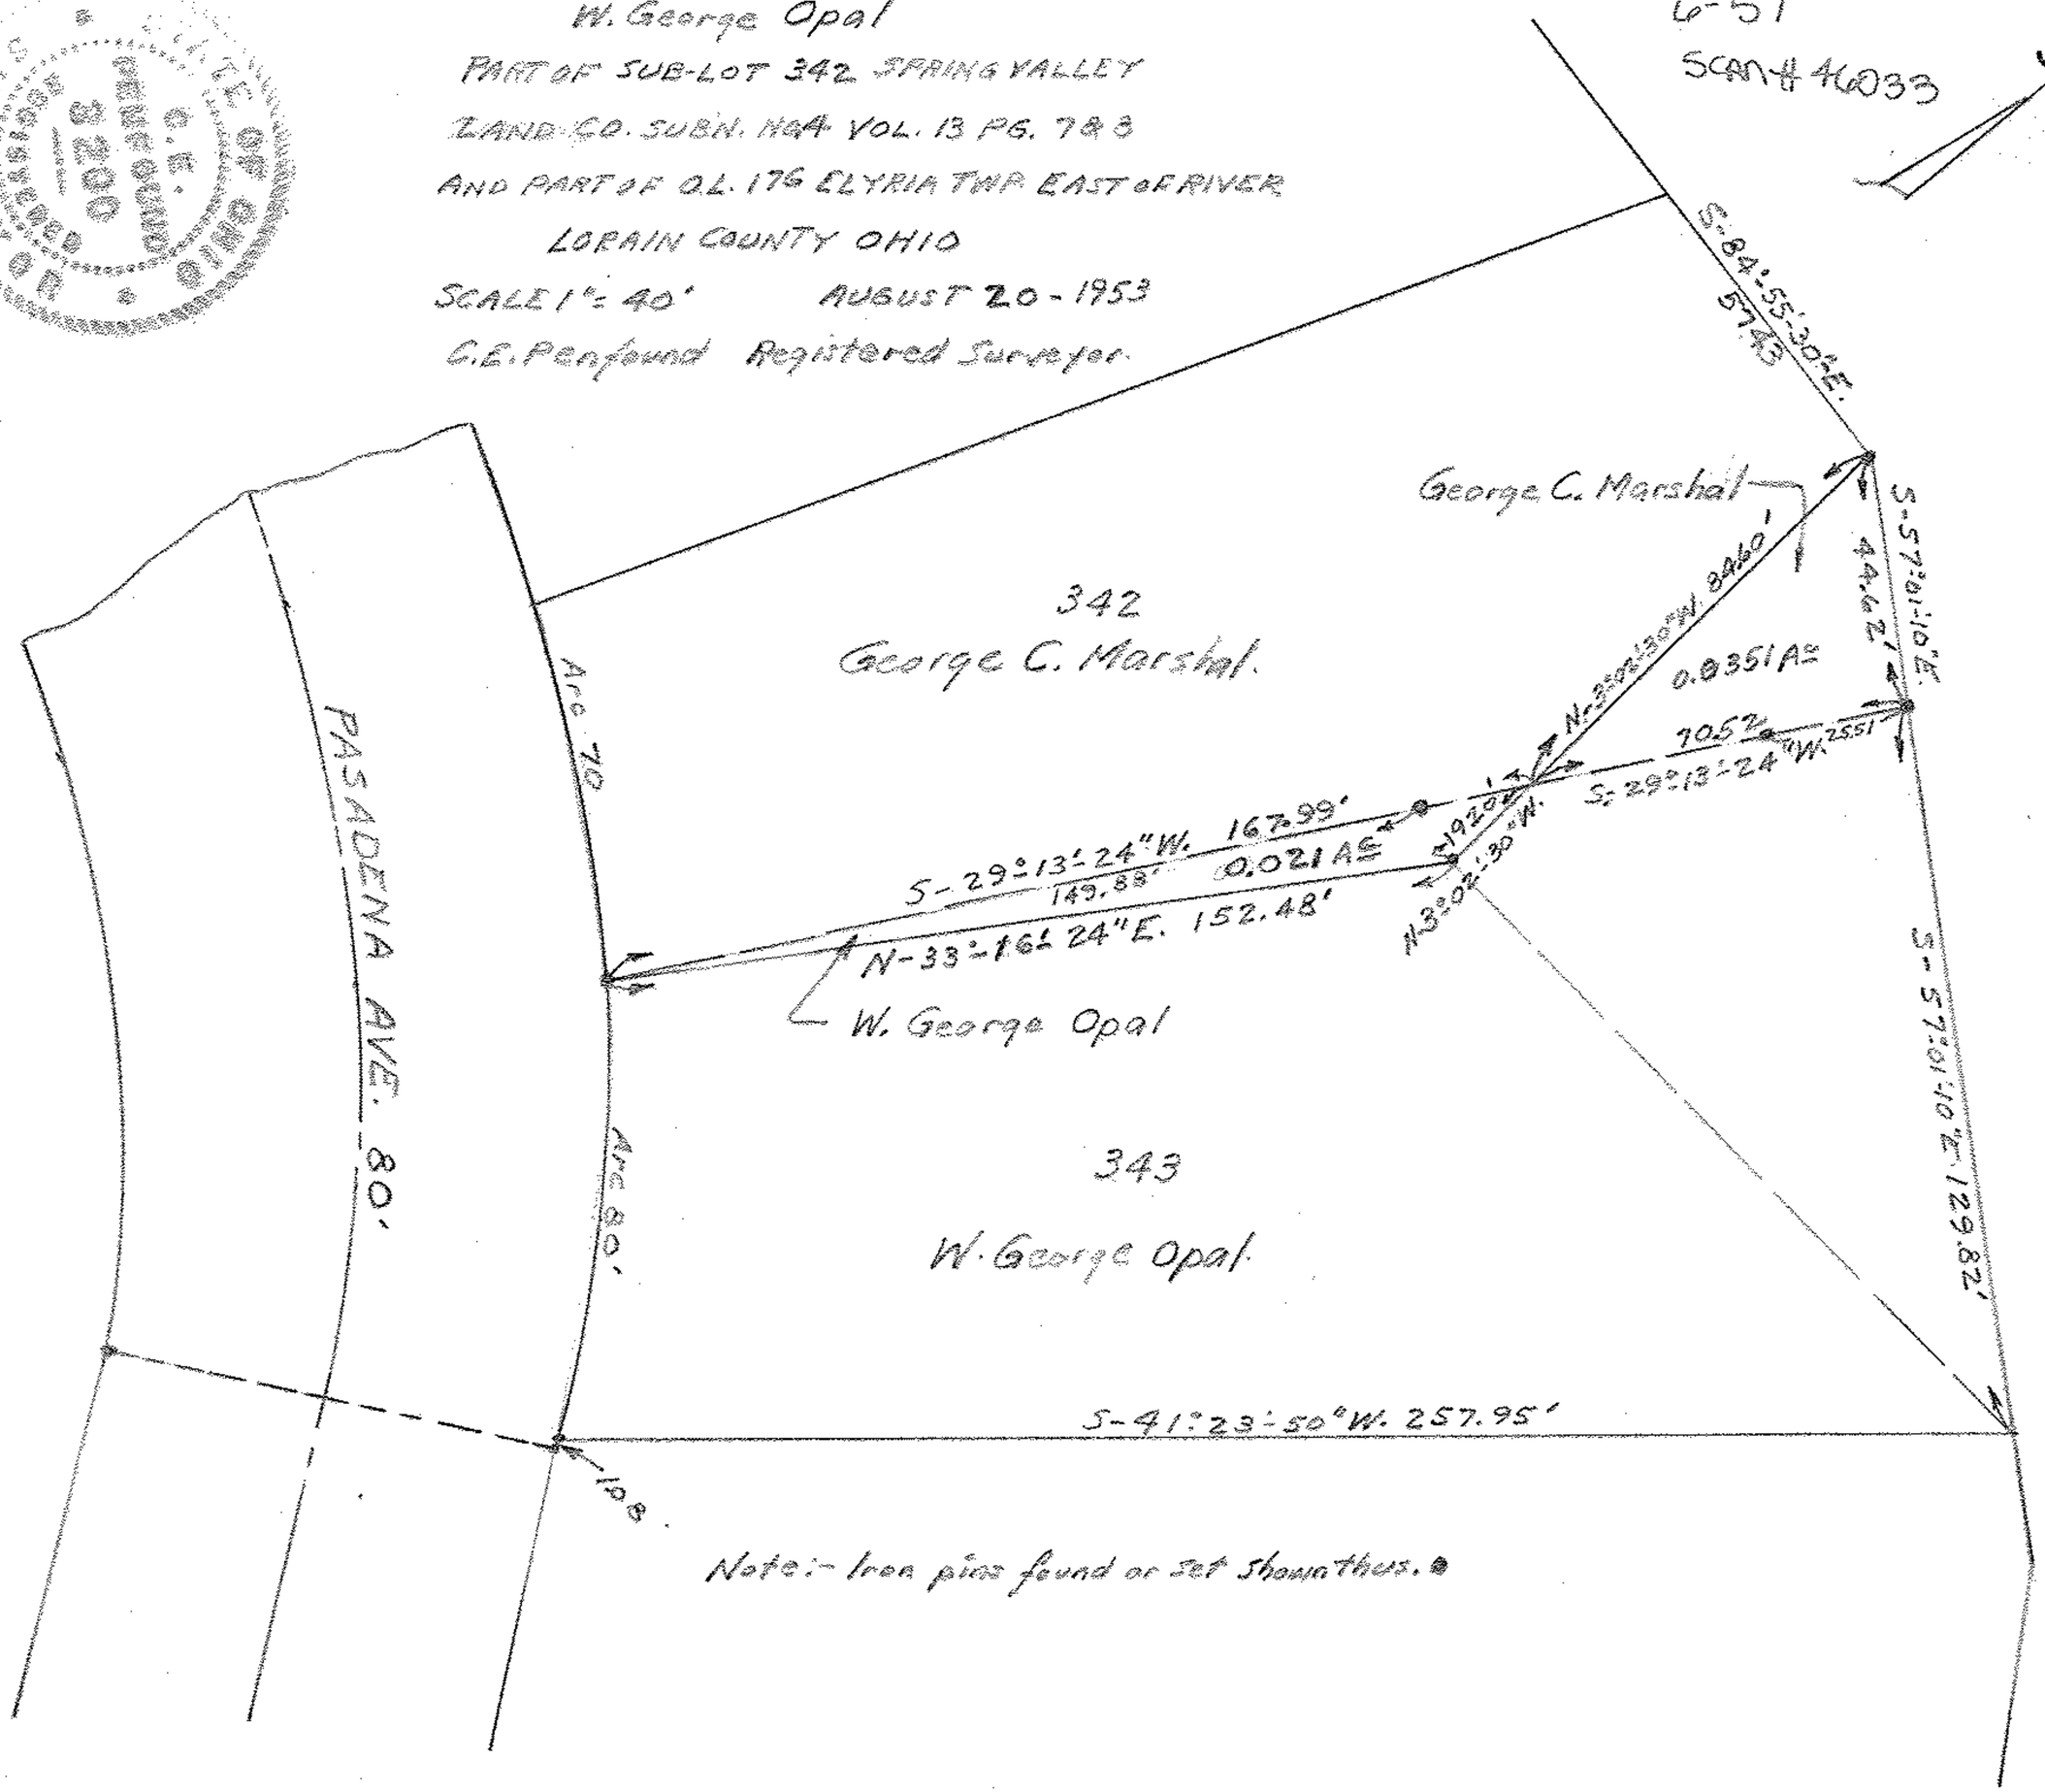

Note:- Iron pins found or set shown thus.