Ole. 2W. 017-000.032
L-137 Scan 40952

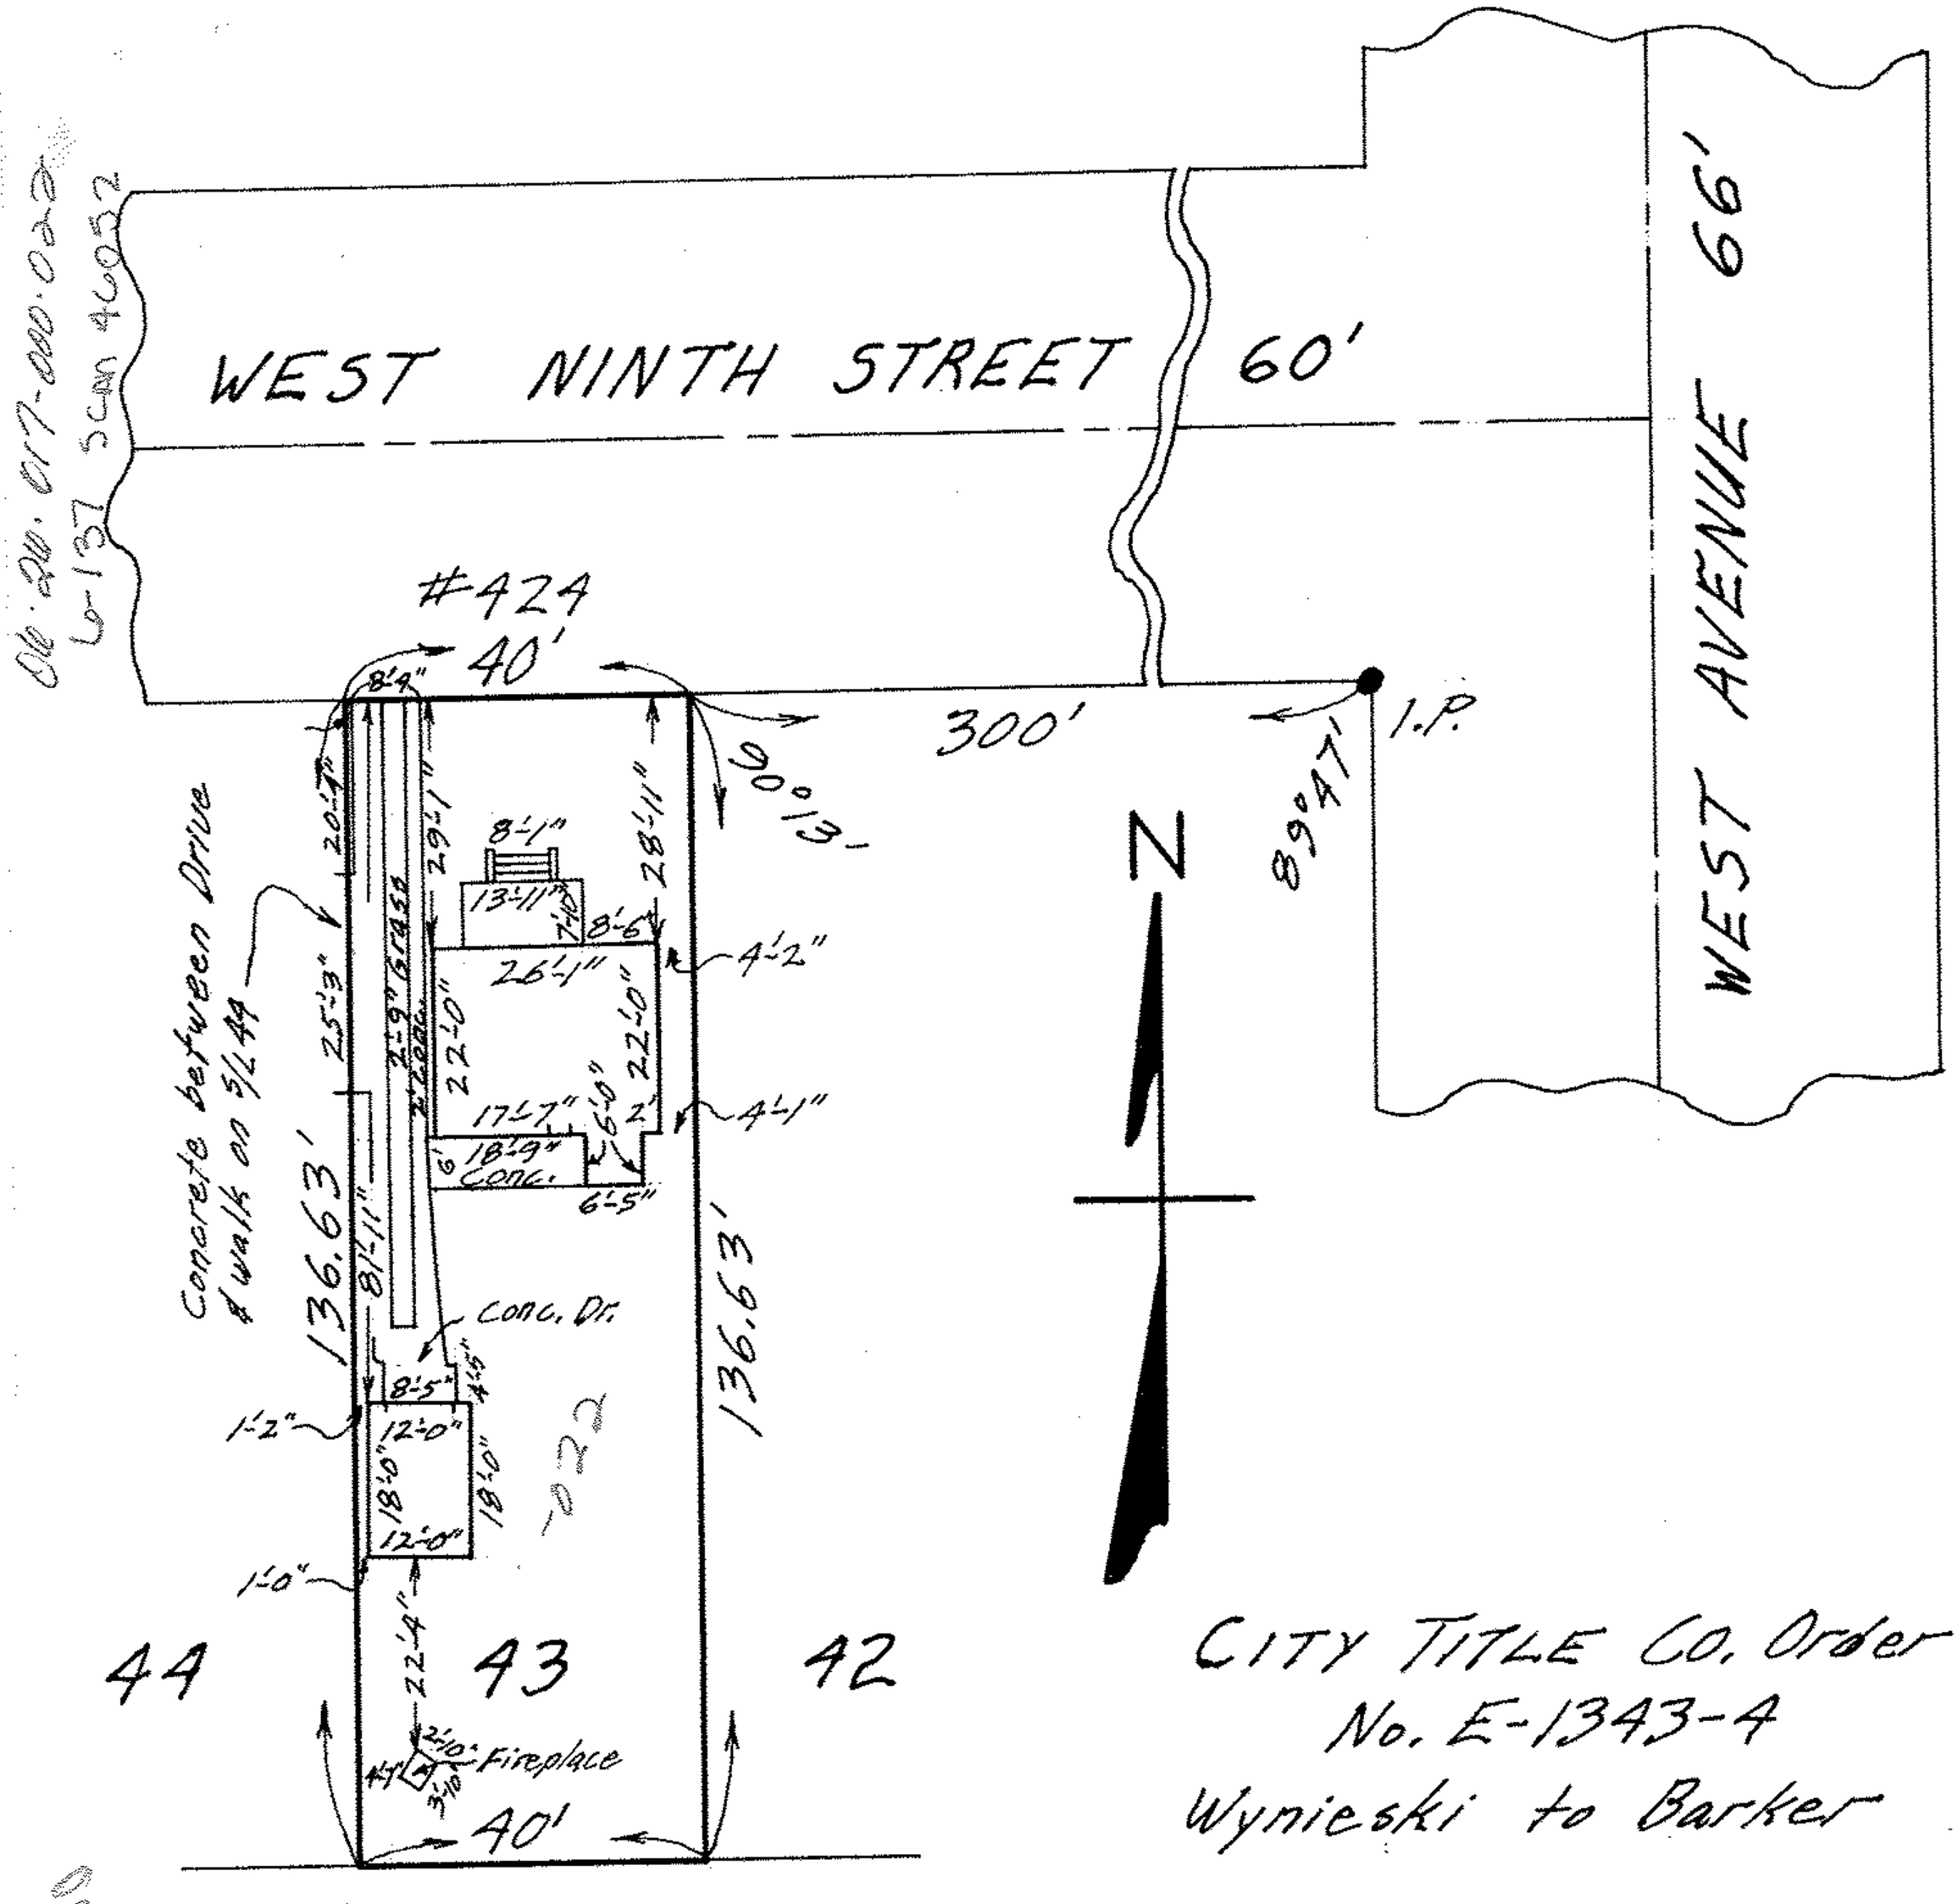

CITY TITLE CO. Order
No. E-1343-4
Wynieski to Barker

MAP OF SUB-LOT NO. 43 IN THE ELY REALTY COMPANY'S WEST AVENUE ALL'T. VOL. 8 PG. 40 ORIG. LOT 17, BETWEEN THE BRANCHES OF BLACK RIVER, ELYRIA TWP. ELYRIA CITY - LORAIN COUNTY - OHIO

SCALE: 1"=30' NOV. 1-1970 10:45 A.M.

NOTE: There are no encroachments on this property.

Gary E. Penfound REG. SURVEYOR NO. 4457

Ole. 2W. 017-000.032