MAP OF SUB-LOT NO. 53

THE ELY REALTY CO'S. WEST AVENUE ALL'T. VOL. 8 PG. 40
ORIG. LOT 17 - BETWEEN THE BRANCHES OF BLACK RIVER
ELYRIA TWP. - ELYRIA CITY - LORAIN COUNTY - OHIO
SCALE: 1" = 30' JUNE 4 - 1970 6:15 P.M.
NOTE: There are no encroachments on this property.
Gary E. Penfound REG. SURVEYOR NO. 4457

CITY TITLE CO. Order No. E-1146-7
Leroy H. & June V. Wobser to
Joseph P. & Karen J. Strines
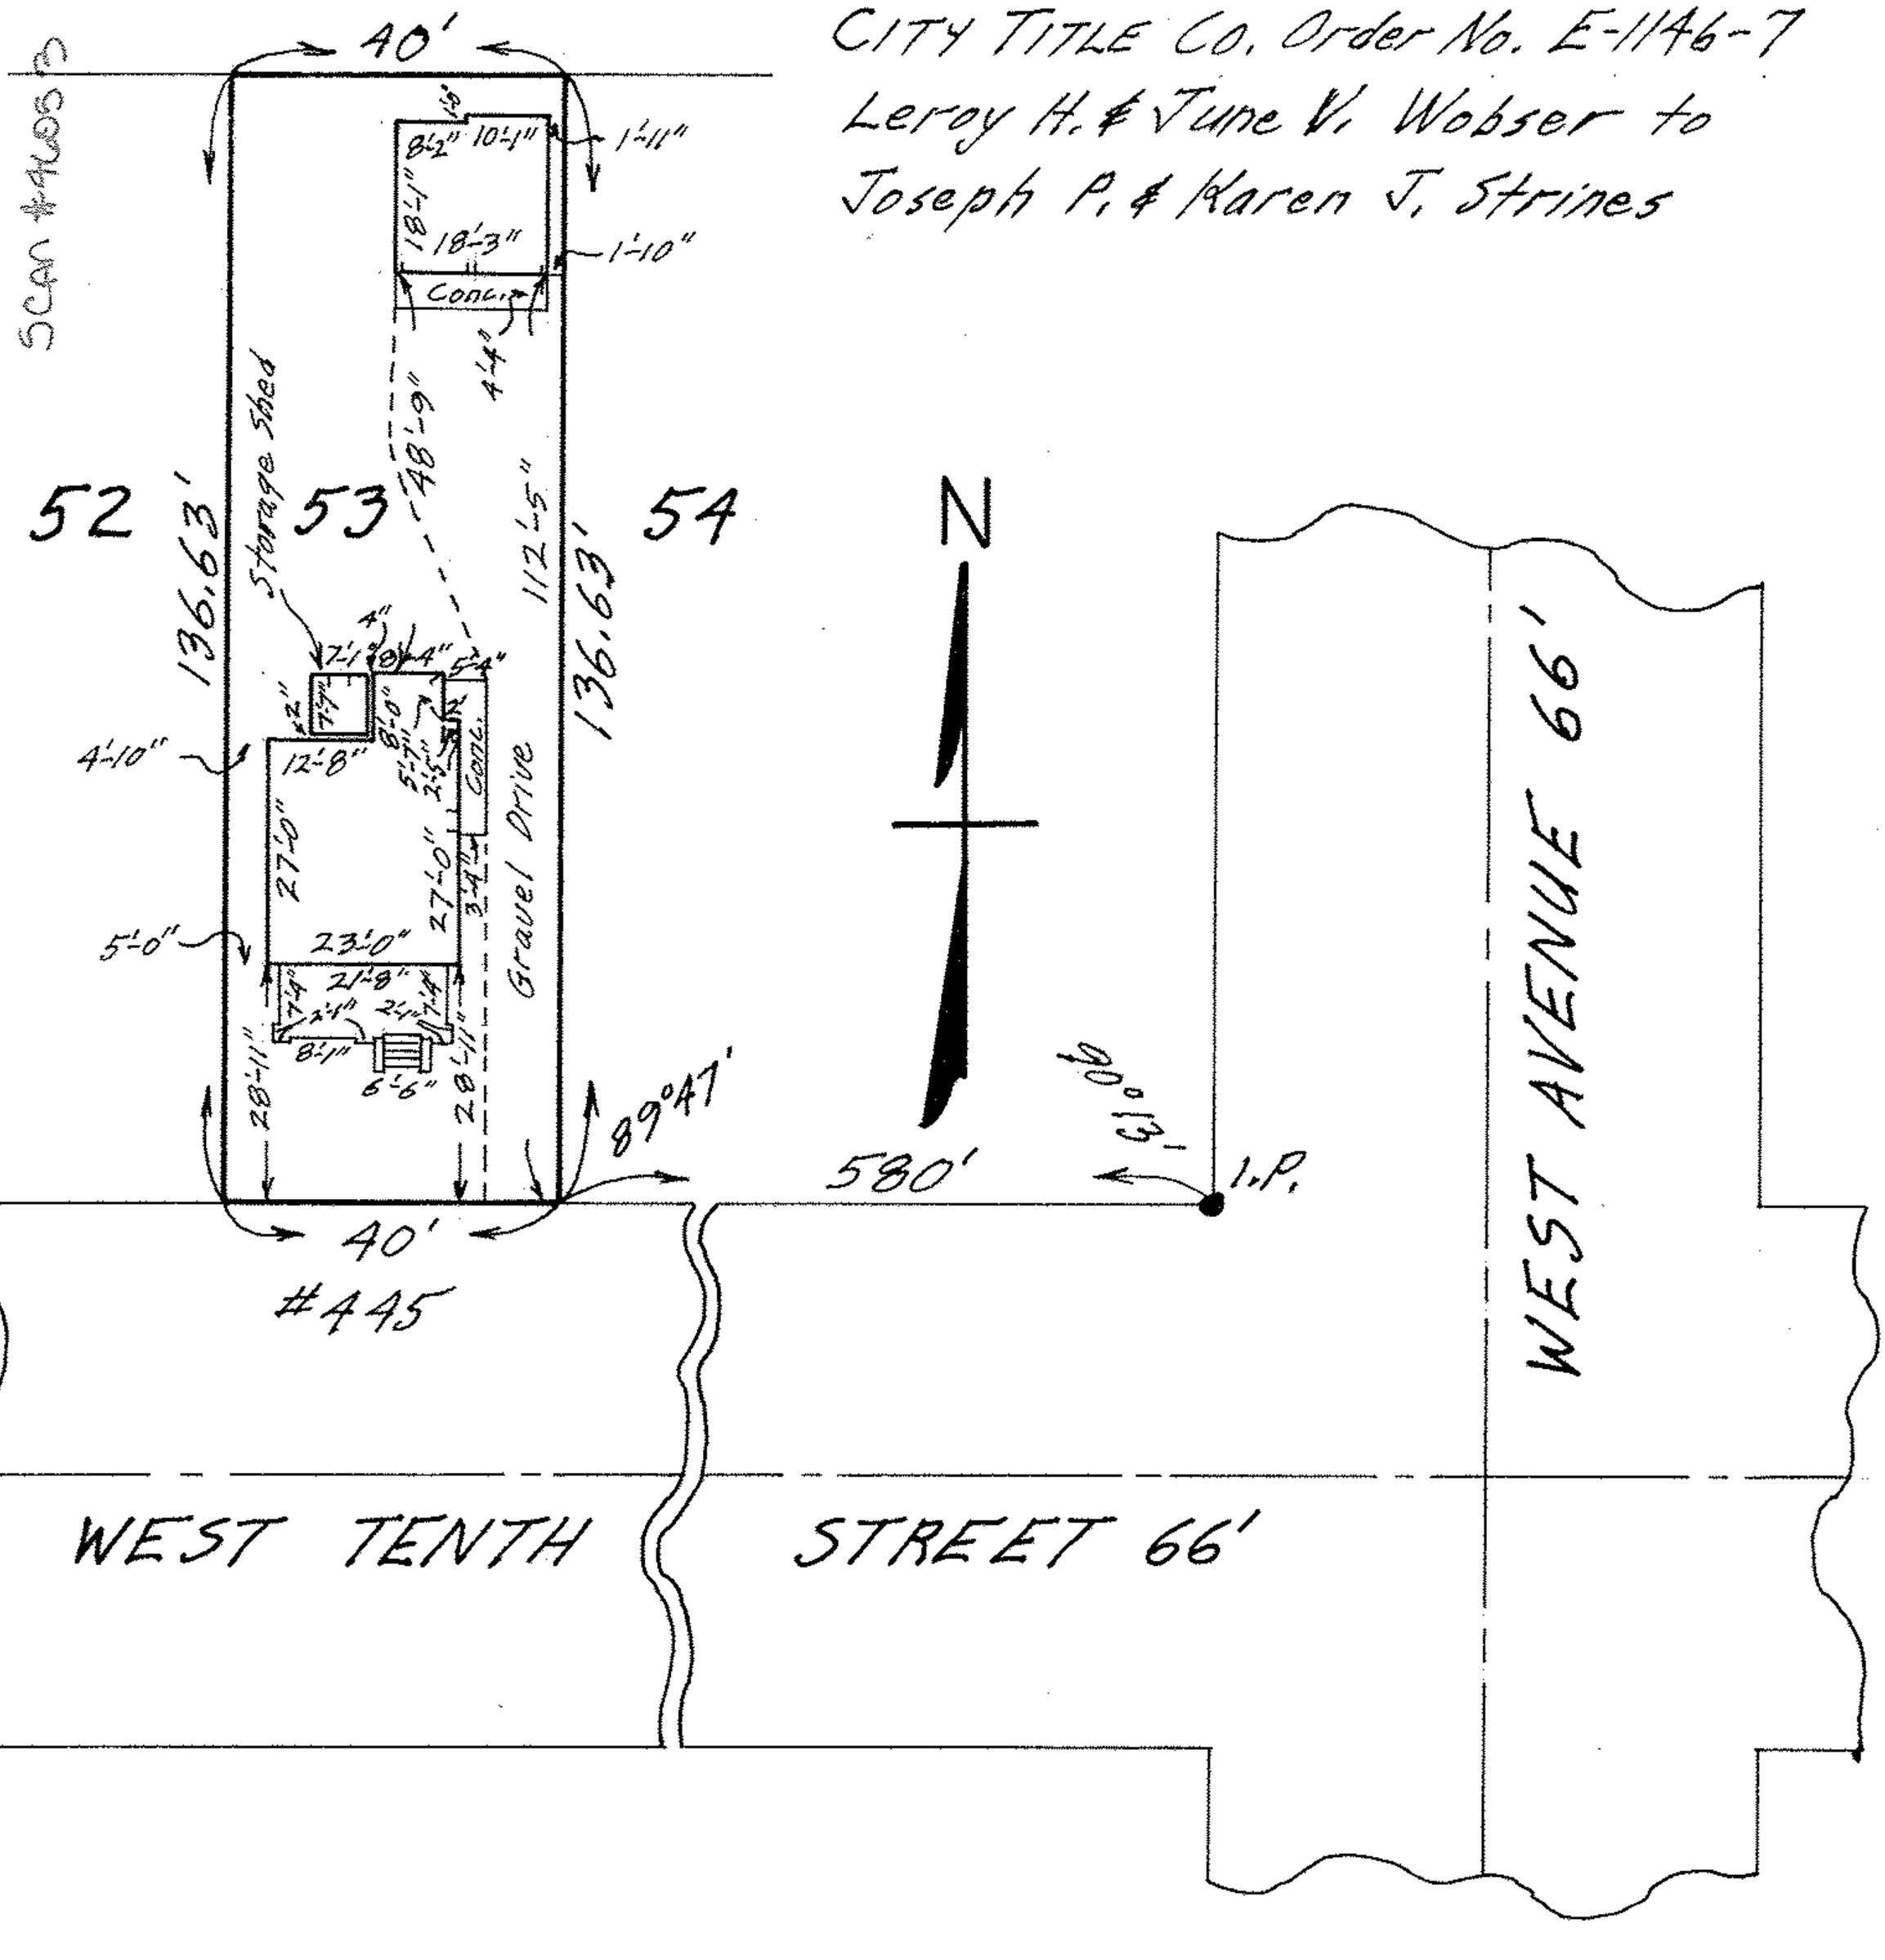
06-26-00-037
6-137
