

048-020
048-050
048-051
048-052
048-053
048-054
048-055



06-24-024-102-025-027

048-050

SCAN#46059 6-137

5

WEST EIGHT ST. 60'

 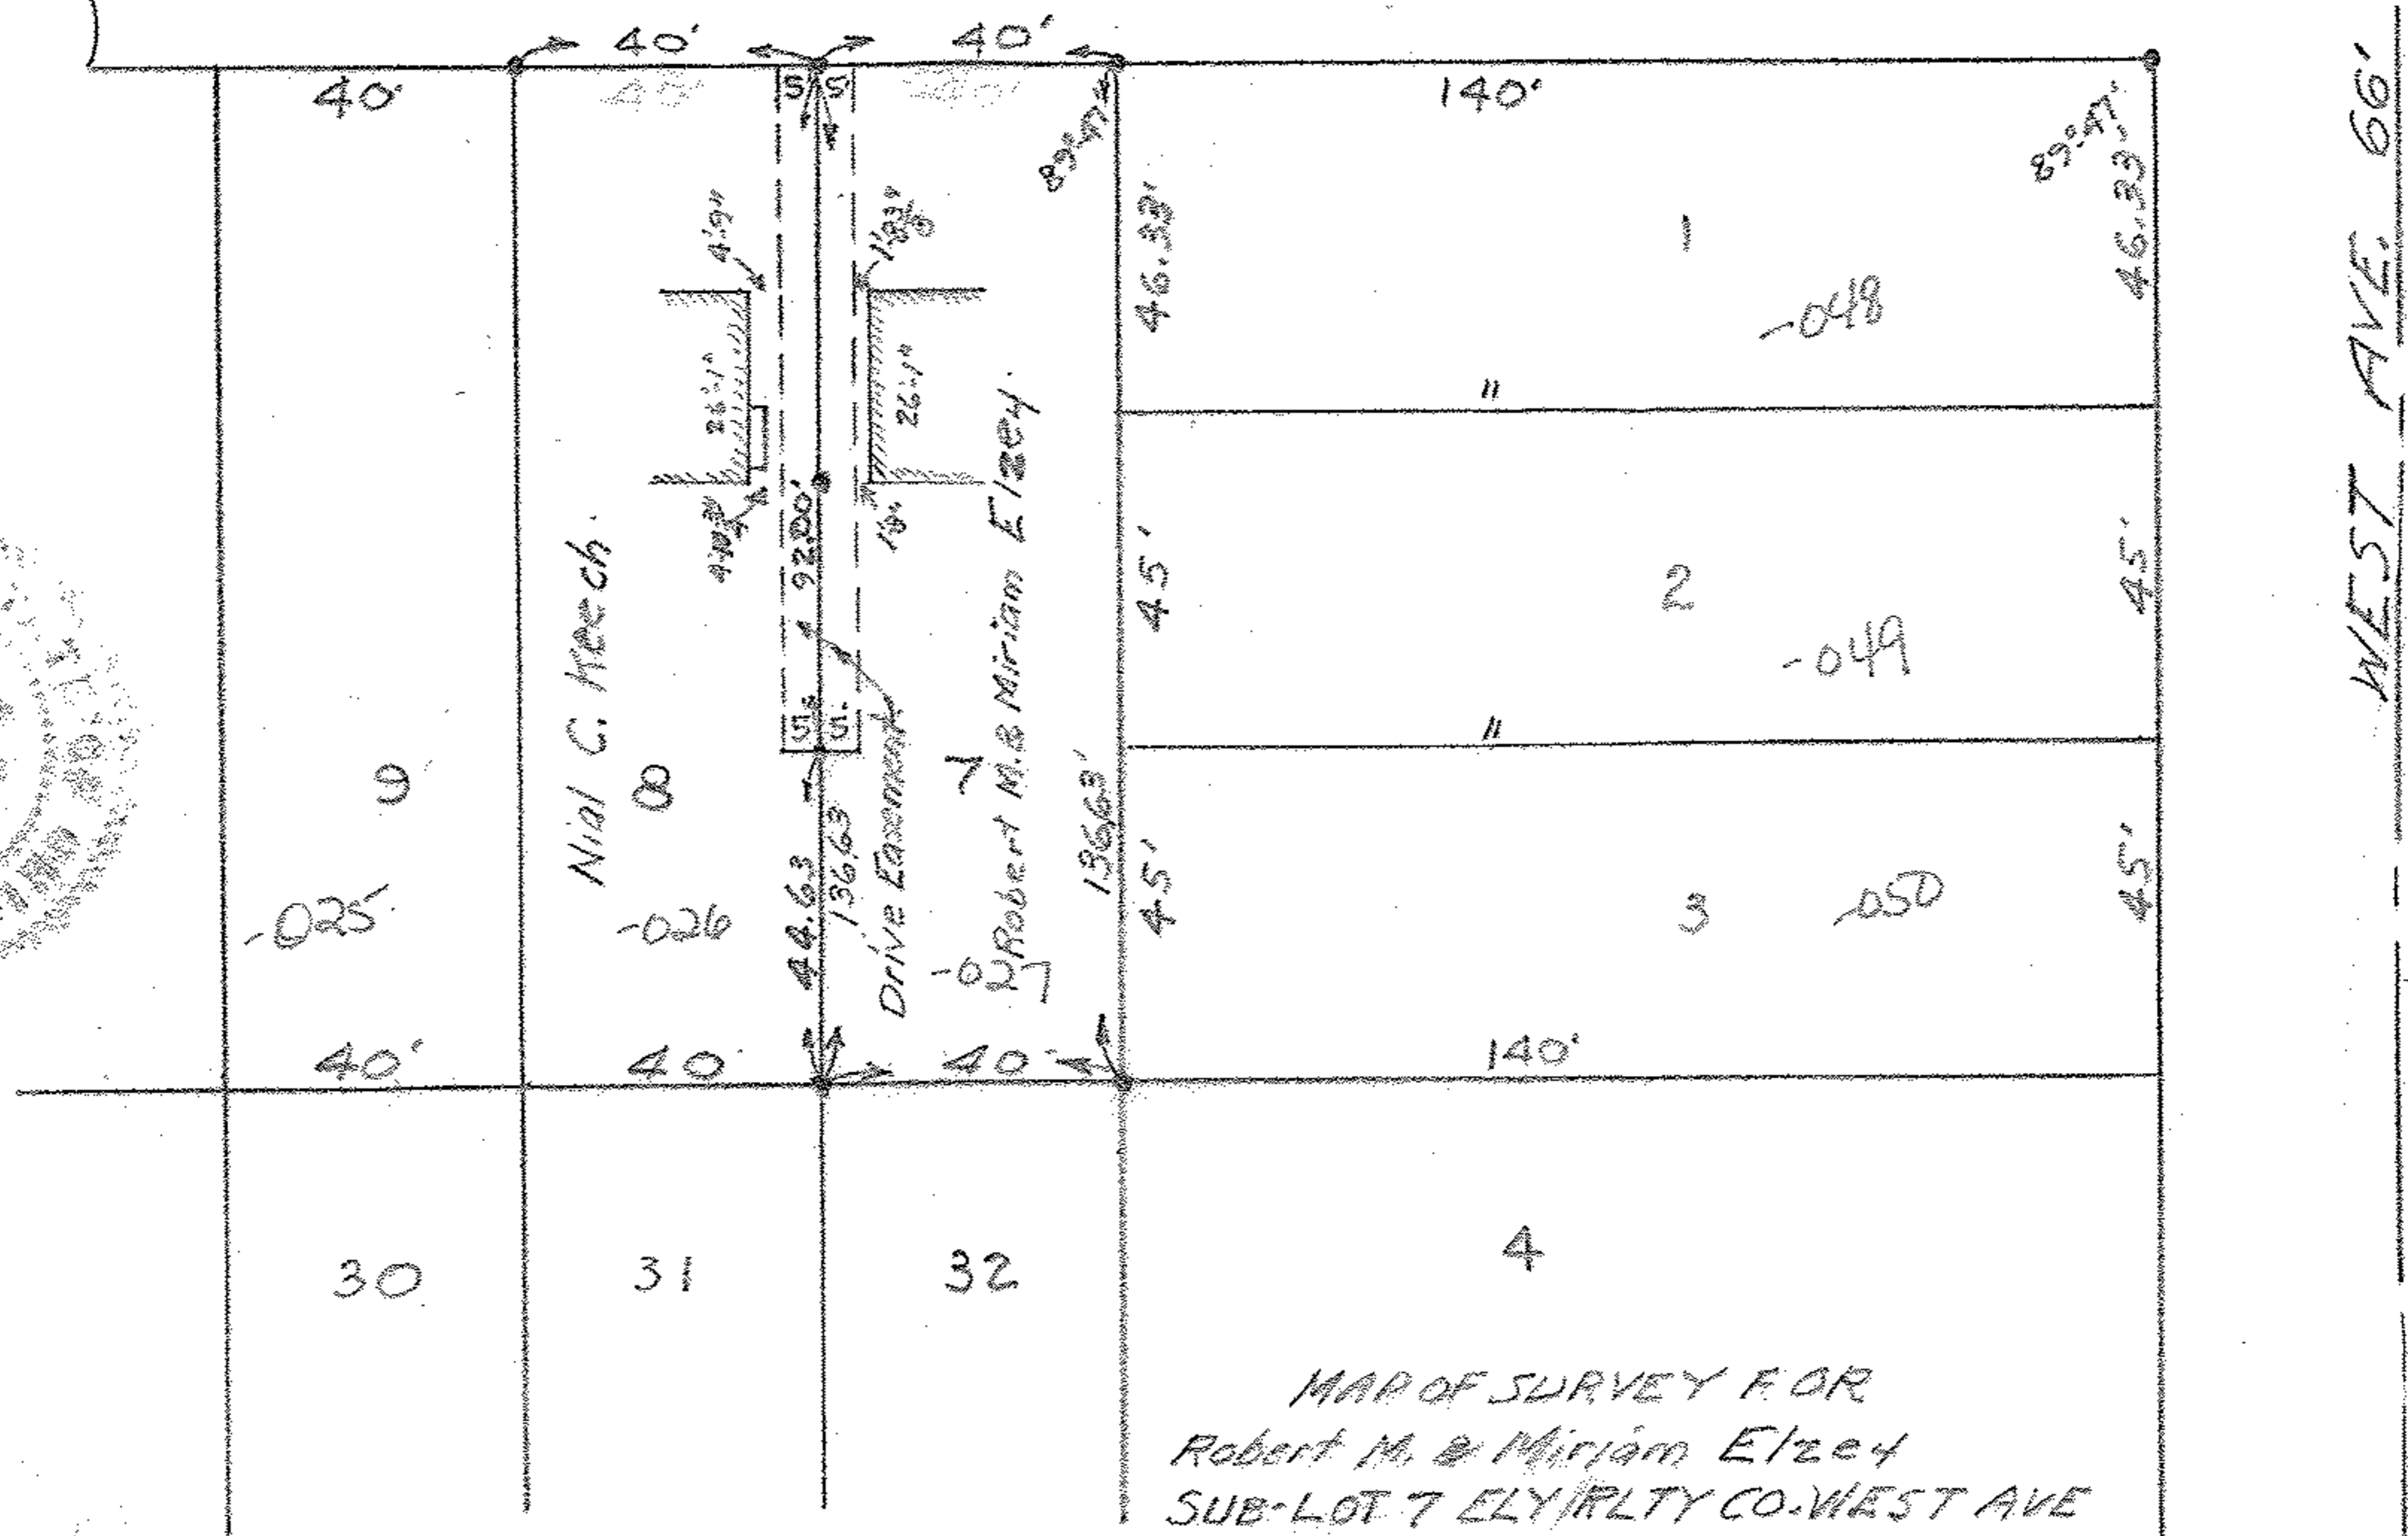

Nial C. Keech.

Robert M. & Miriam Elze4

Drive Easement

MAP OF SURVEY FOR
 Robert M. & Miriam Elze4
 SUB-LOT 7 ELY RLTY CO. WEST AVE
 ALLT. VOL. 8 PG. 4 OL. 17 WEST OF THE
 WEST BRANCH OF BLACK RIVER.
 ALSO SHOWING EASEMENT FOR DRIVES
 SUB-LOT NO. 7 and SUB-LOT NO. 8
 ELYRIA CITY LORAIN COUNTY OHIO
 Scale 1"=40' NOV. 11-1955
 C. E. Becklund Registered Surveyor

9th St.

WEST AVE. 66'