Ohio Title Corp. Order No. 25 Page
L-138 Scan #4042

MAP OF THE WEST HALF OF SUB-LOT NO. 16
BOWEN AND WALLACE'S ADD'N. VOL. 2 PG. 20
ORIG. LOT 27 - BETWEEN THE BRANCHES OF BLACK RIVER
ELYRIA TWP. ELYRIA CITY
LORAIN COUNTY OHIO
SCALE: 1"=30' AUG. 21-1970 12:15 P.M.
NOTE: There are no encroachments on this property, however a Common Drive situation exists as shown.
Gary E. Penfound REG. SURVEYOR NO. 4457
CITY TITLE CO. Order No. E-1245-6 Plas & Duncil to Walsh

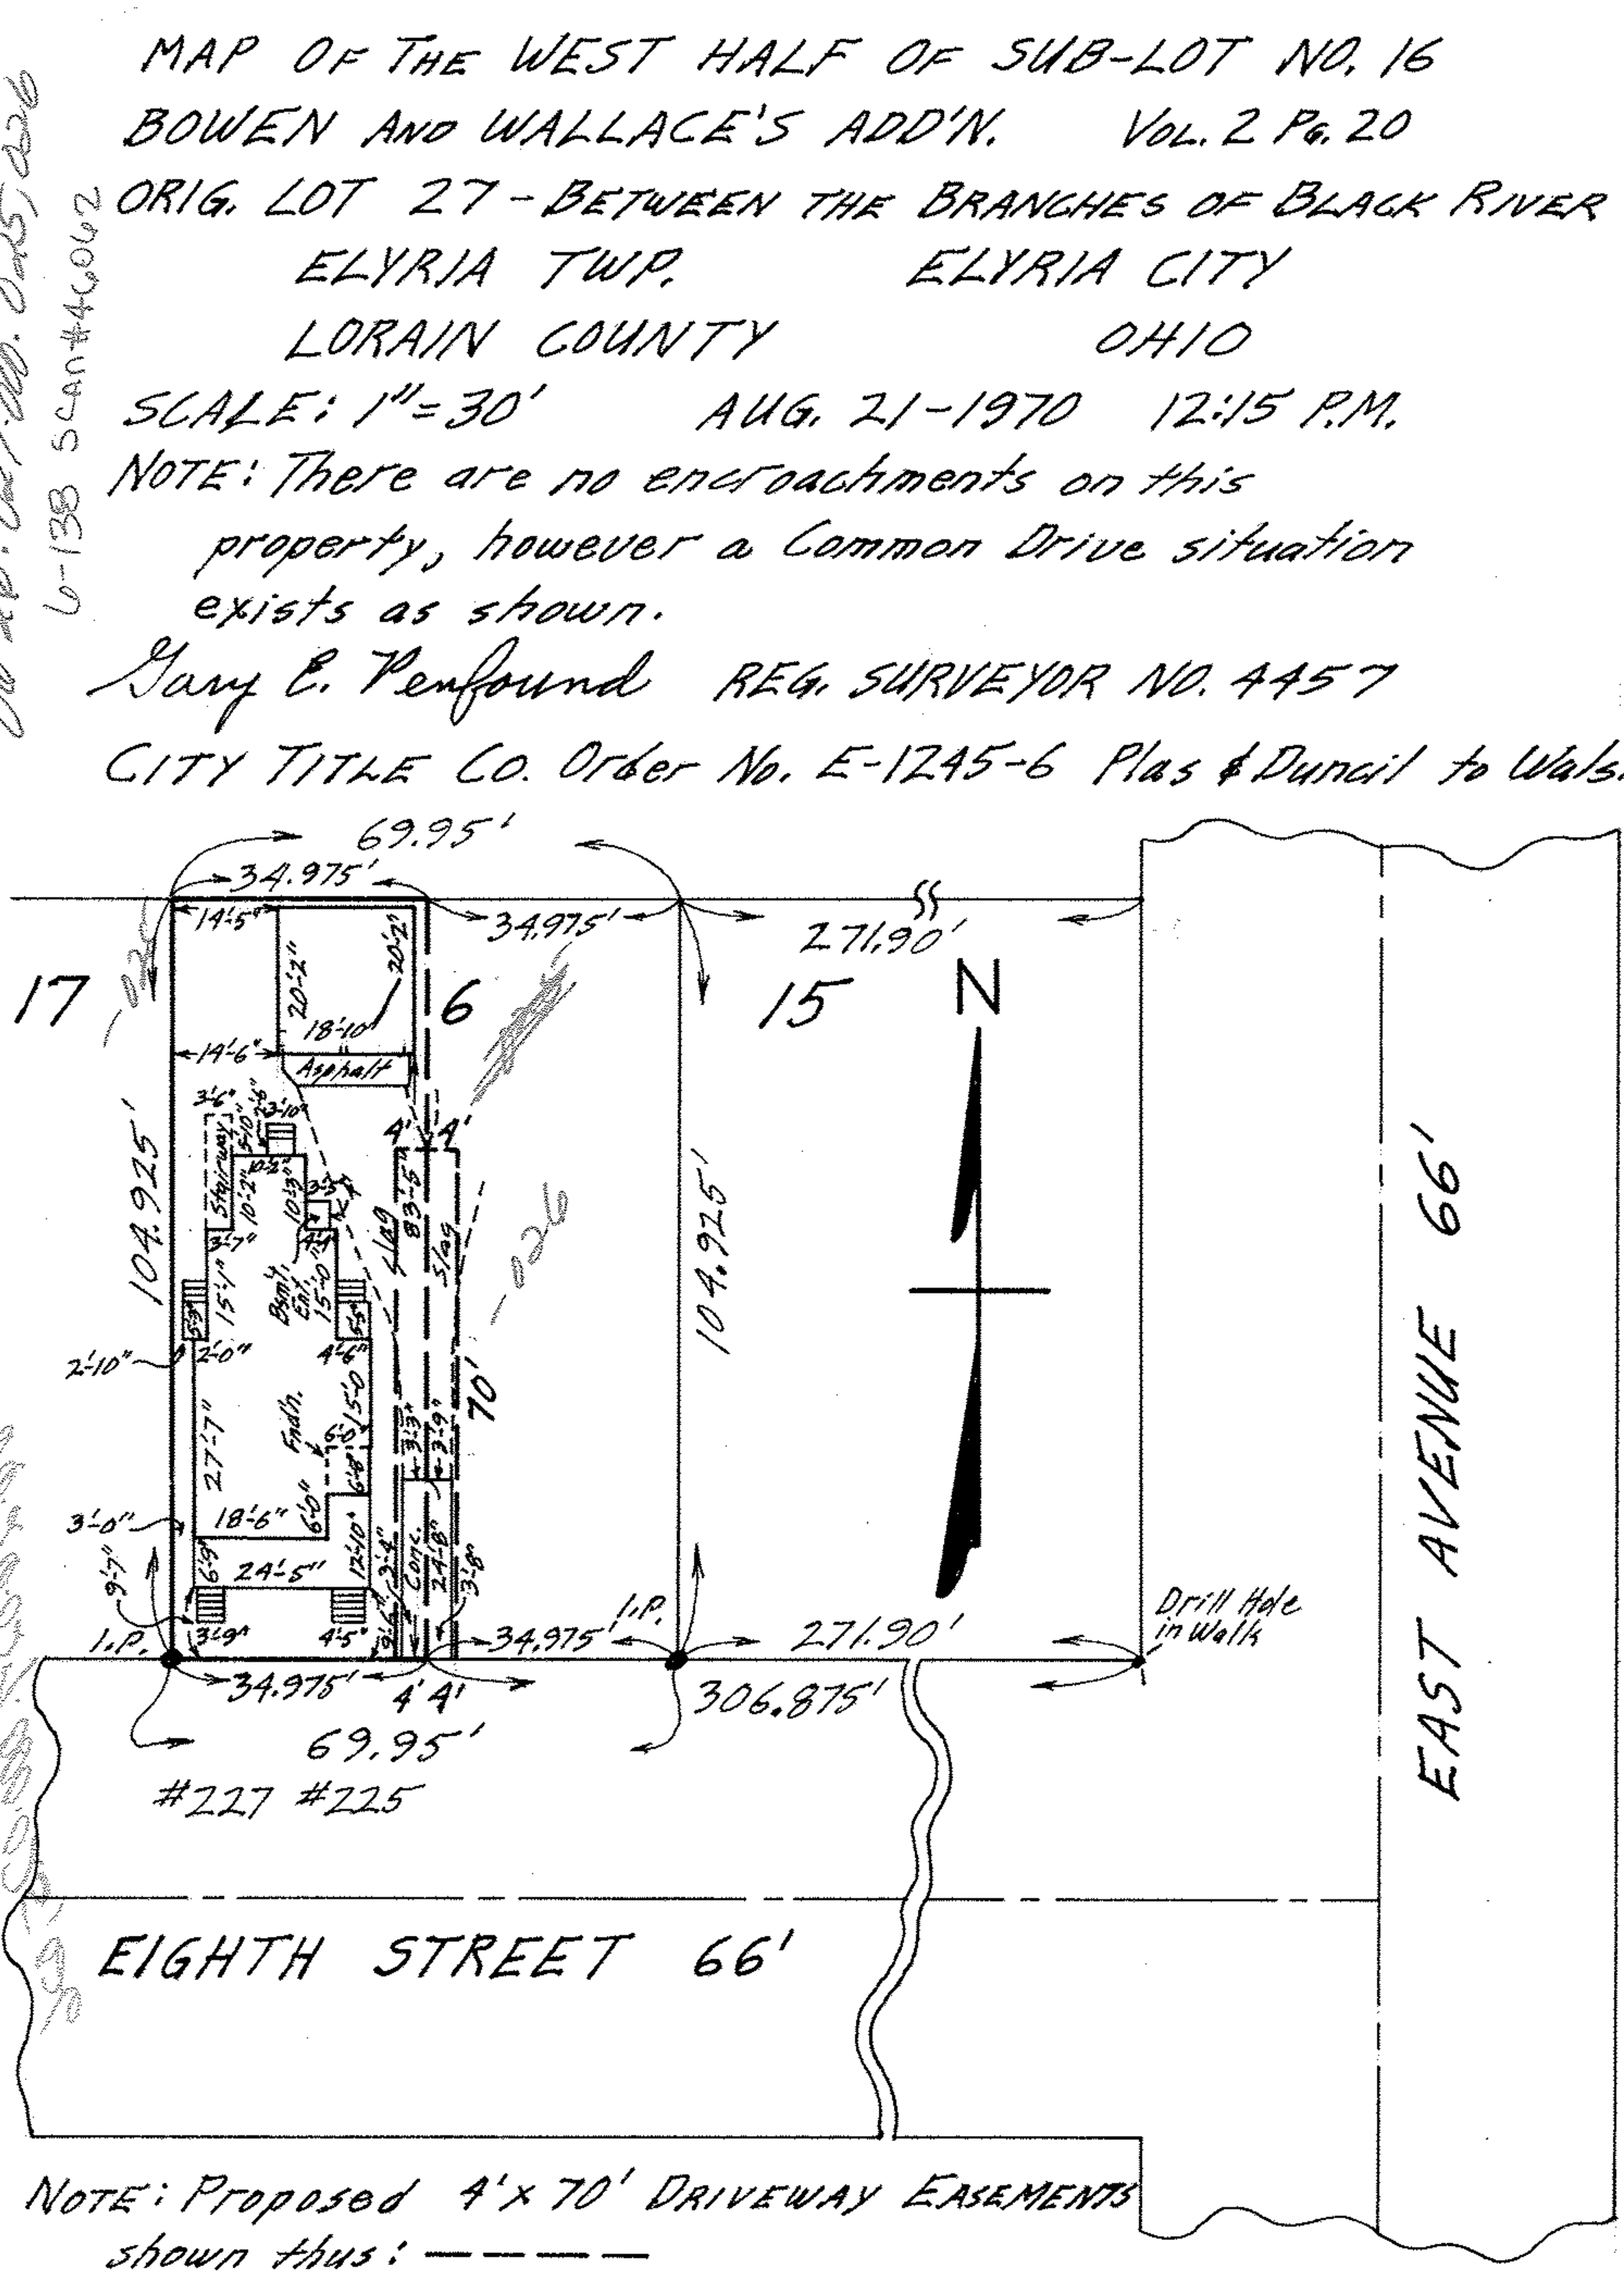

NOTE: Proposed 4'x 70' DRIVEWAY EASEMENTS shown thus: — — — —