06-26-033-000-014, 015

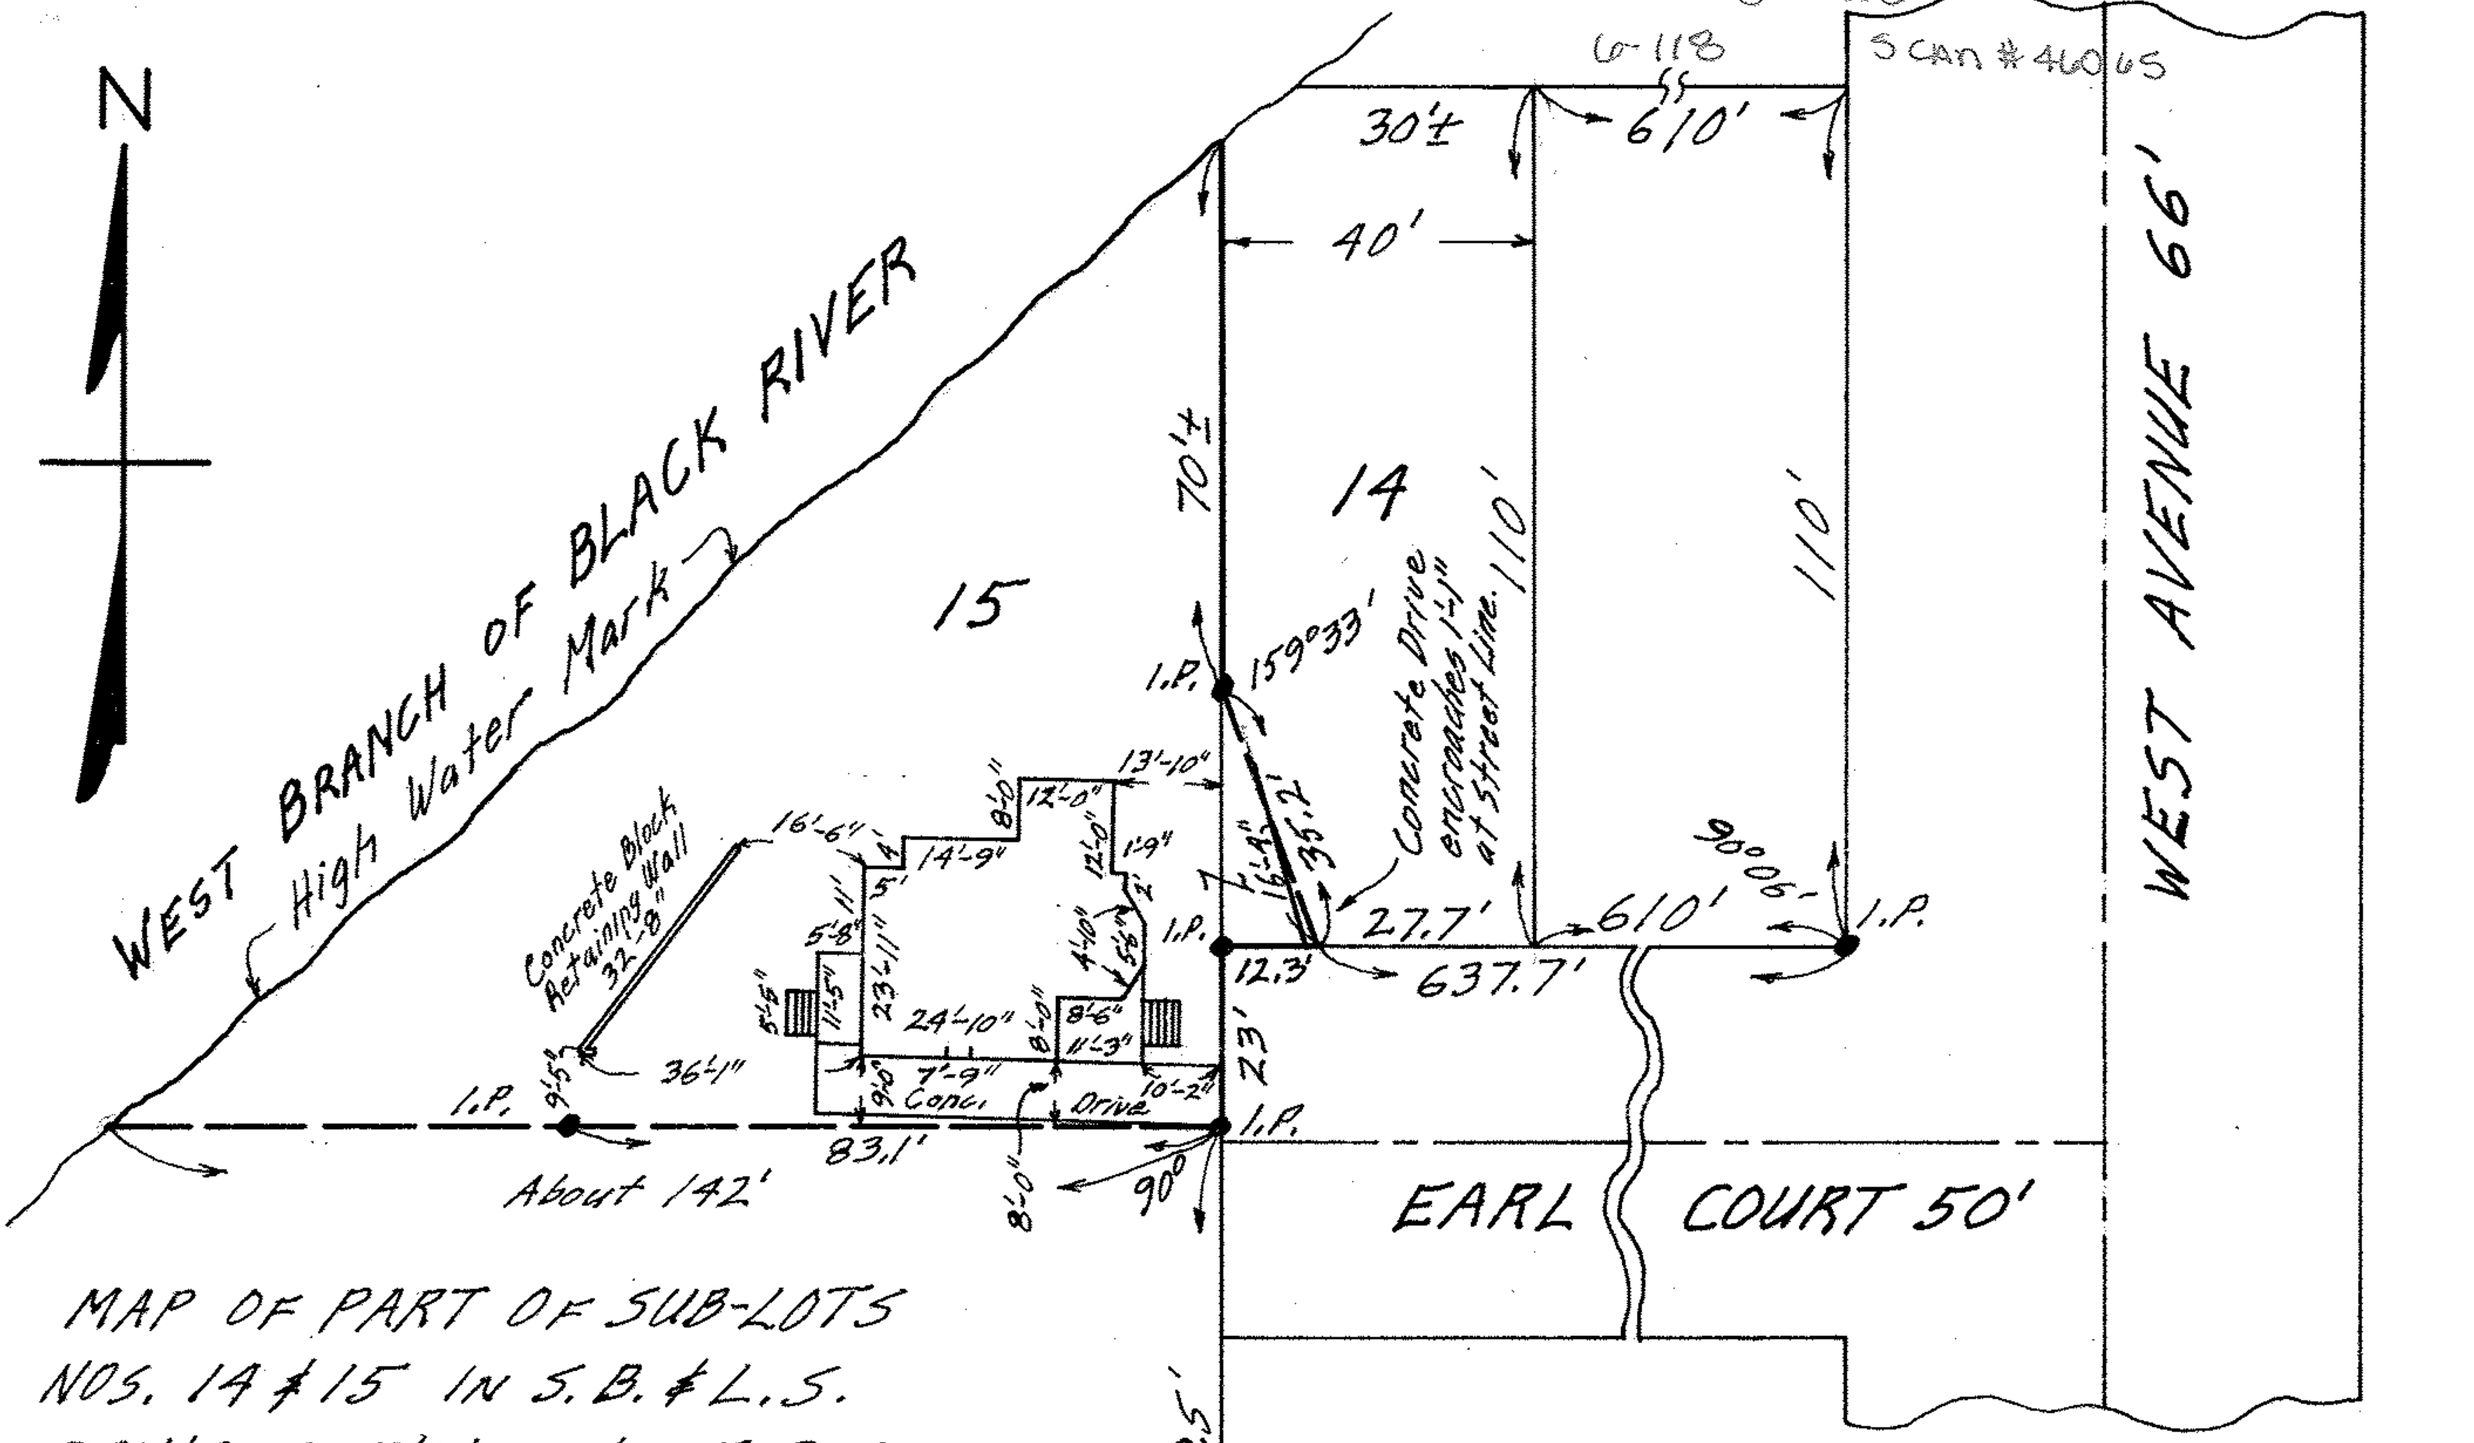

MAP OF PART OF SUB-LOTS
NOS. 14 & 15 IN S.B. & L.S.
DAY'S SUB'N. VOL. 5 PG. 3
ORIG. LOT 33 - BETWEEN THE
BRANCHES - ELYRIA TWP.
ELYRIA CITY - LORAIN COUNTY - OHIO
SCALE: 1" = 30' FEB. 1 - 1970 1:00 P.M.

NOTE: The only encroachment onto this property is concrete drive as shown.
Gary E. Penfound REG. SURVEYOR NO. 4457

CITY TITLE Co. Order No. E-1017-18
Morrison to Jones