06.26.051.000.019

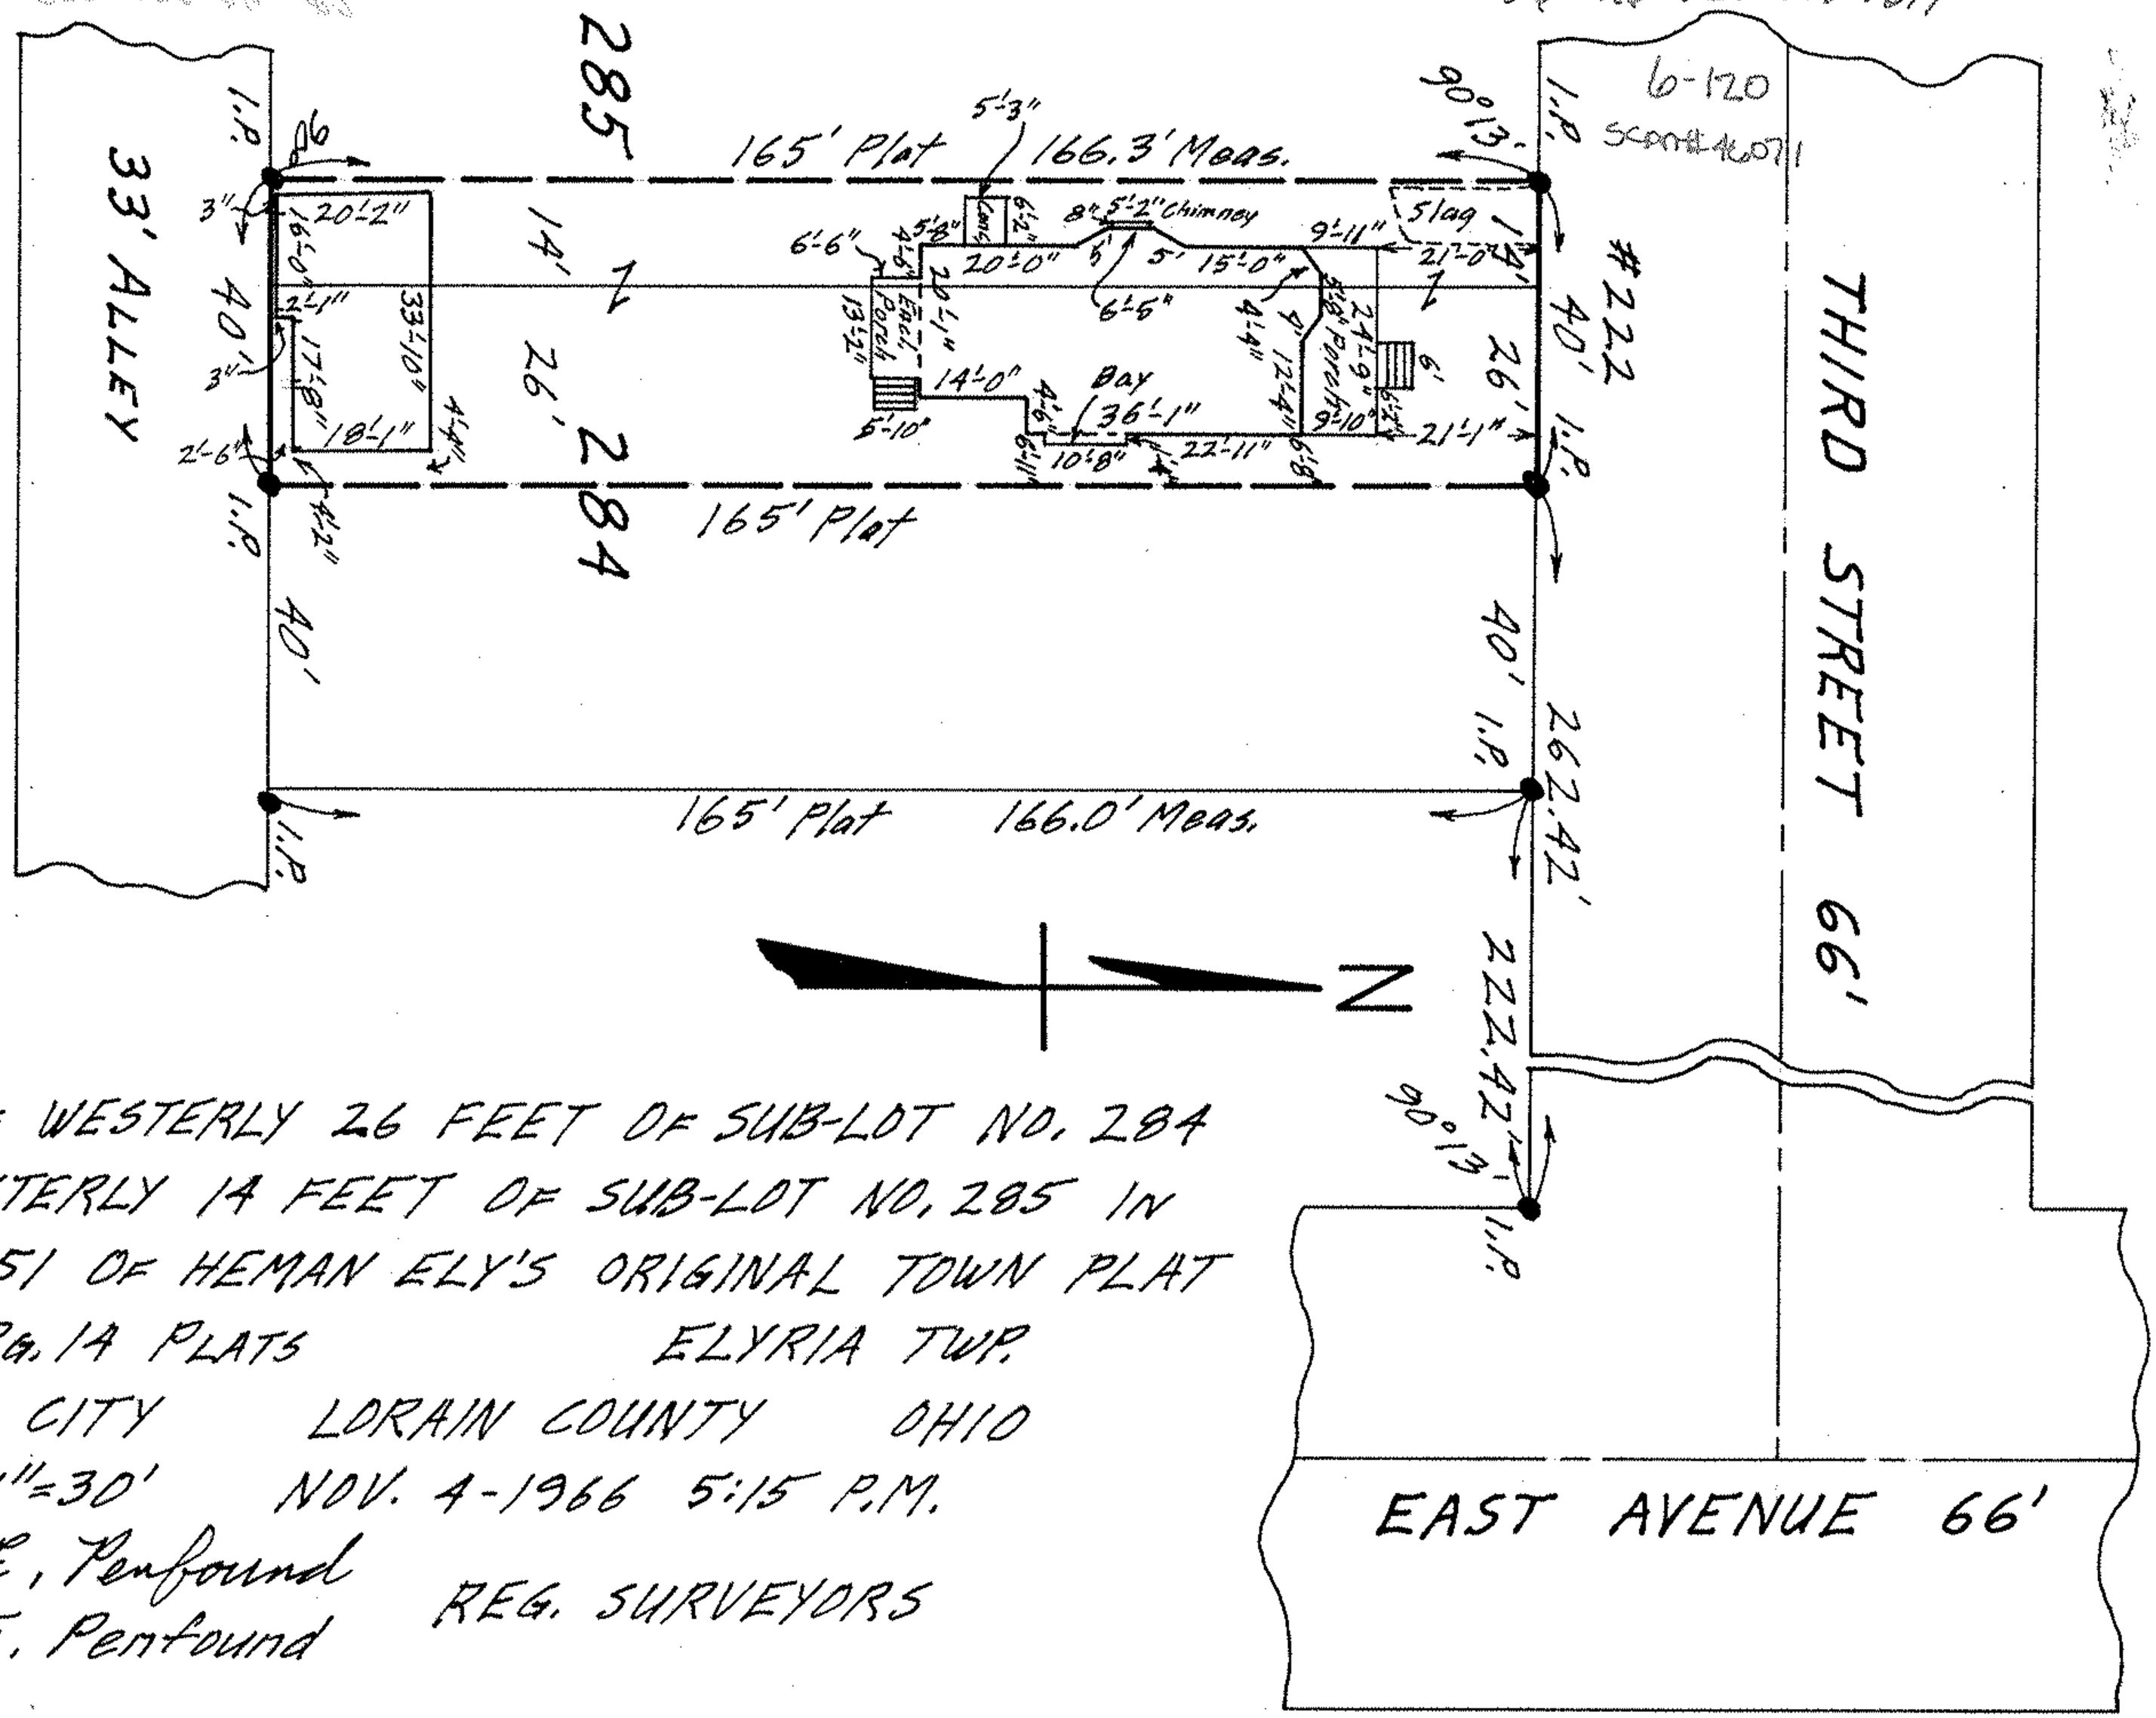

MAP OF WESTERLY 26 FEET OF SUB-LOT NO. 284
AND EASTERLY 14 FEET OF SUB-LOT NO. 285 IN
BLOCK 51 OF HEMAN ELY'S ORIGINAL TOWN PLAT
VOL. 3 PG. 14 PLATS ELYRIA TWP.
ELYRIA CITY LORAIN COUNTY OHIO
SCALE: 1"=30' NOV. 4-1966 5:15 P.M.
Gary E. Penfound
for C. E. Penfound REG. SURVEYORS

G.L. 1832