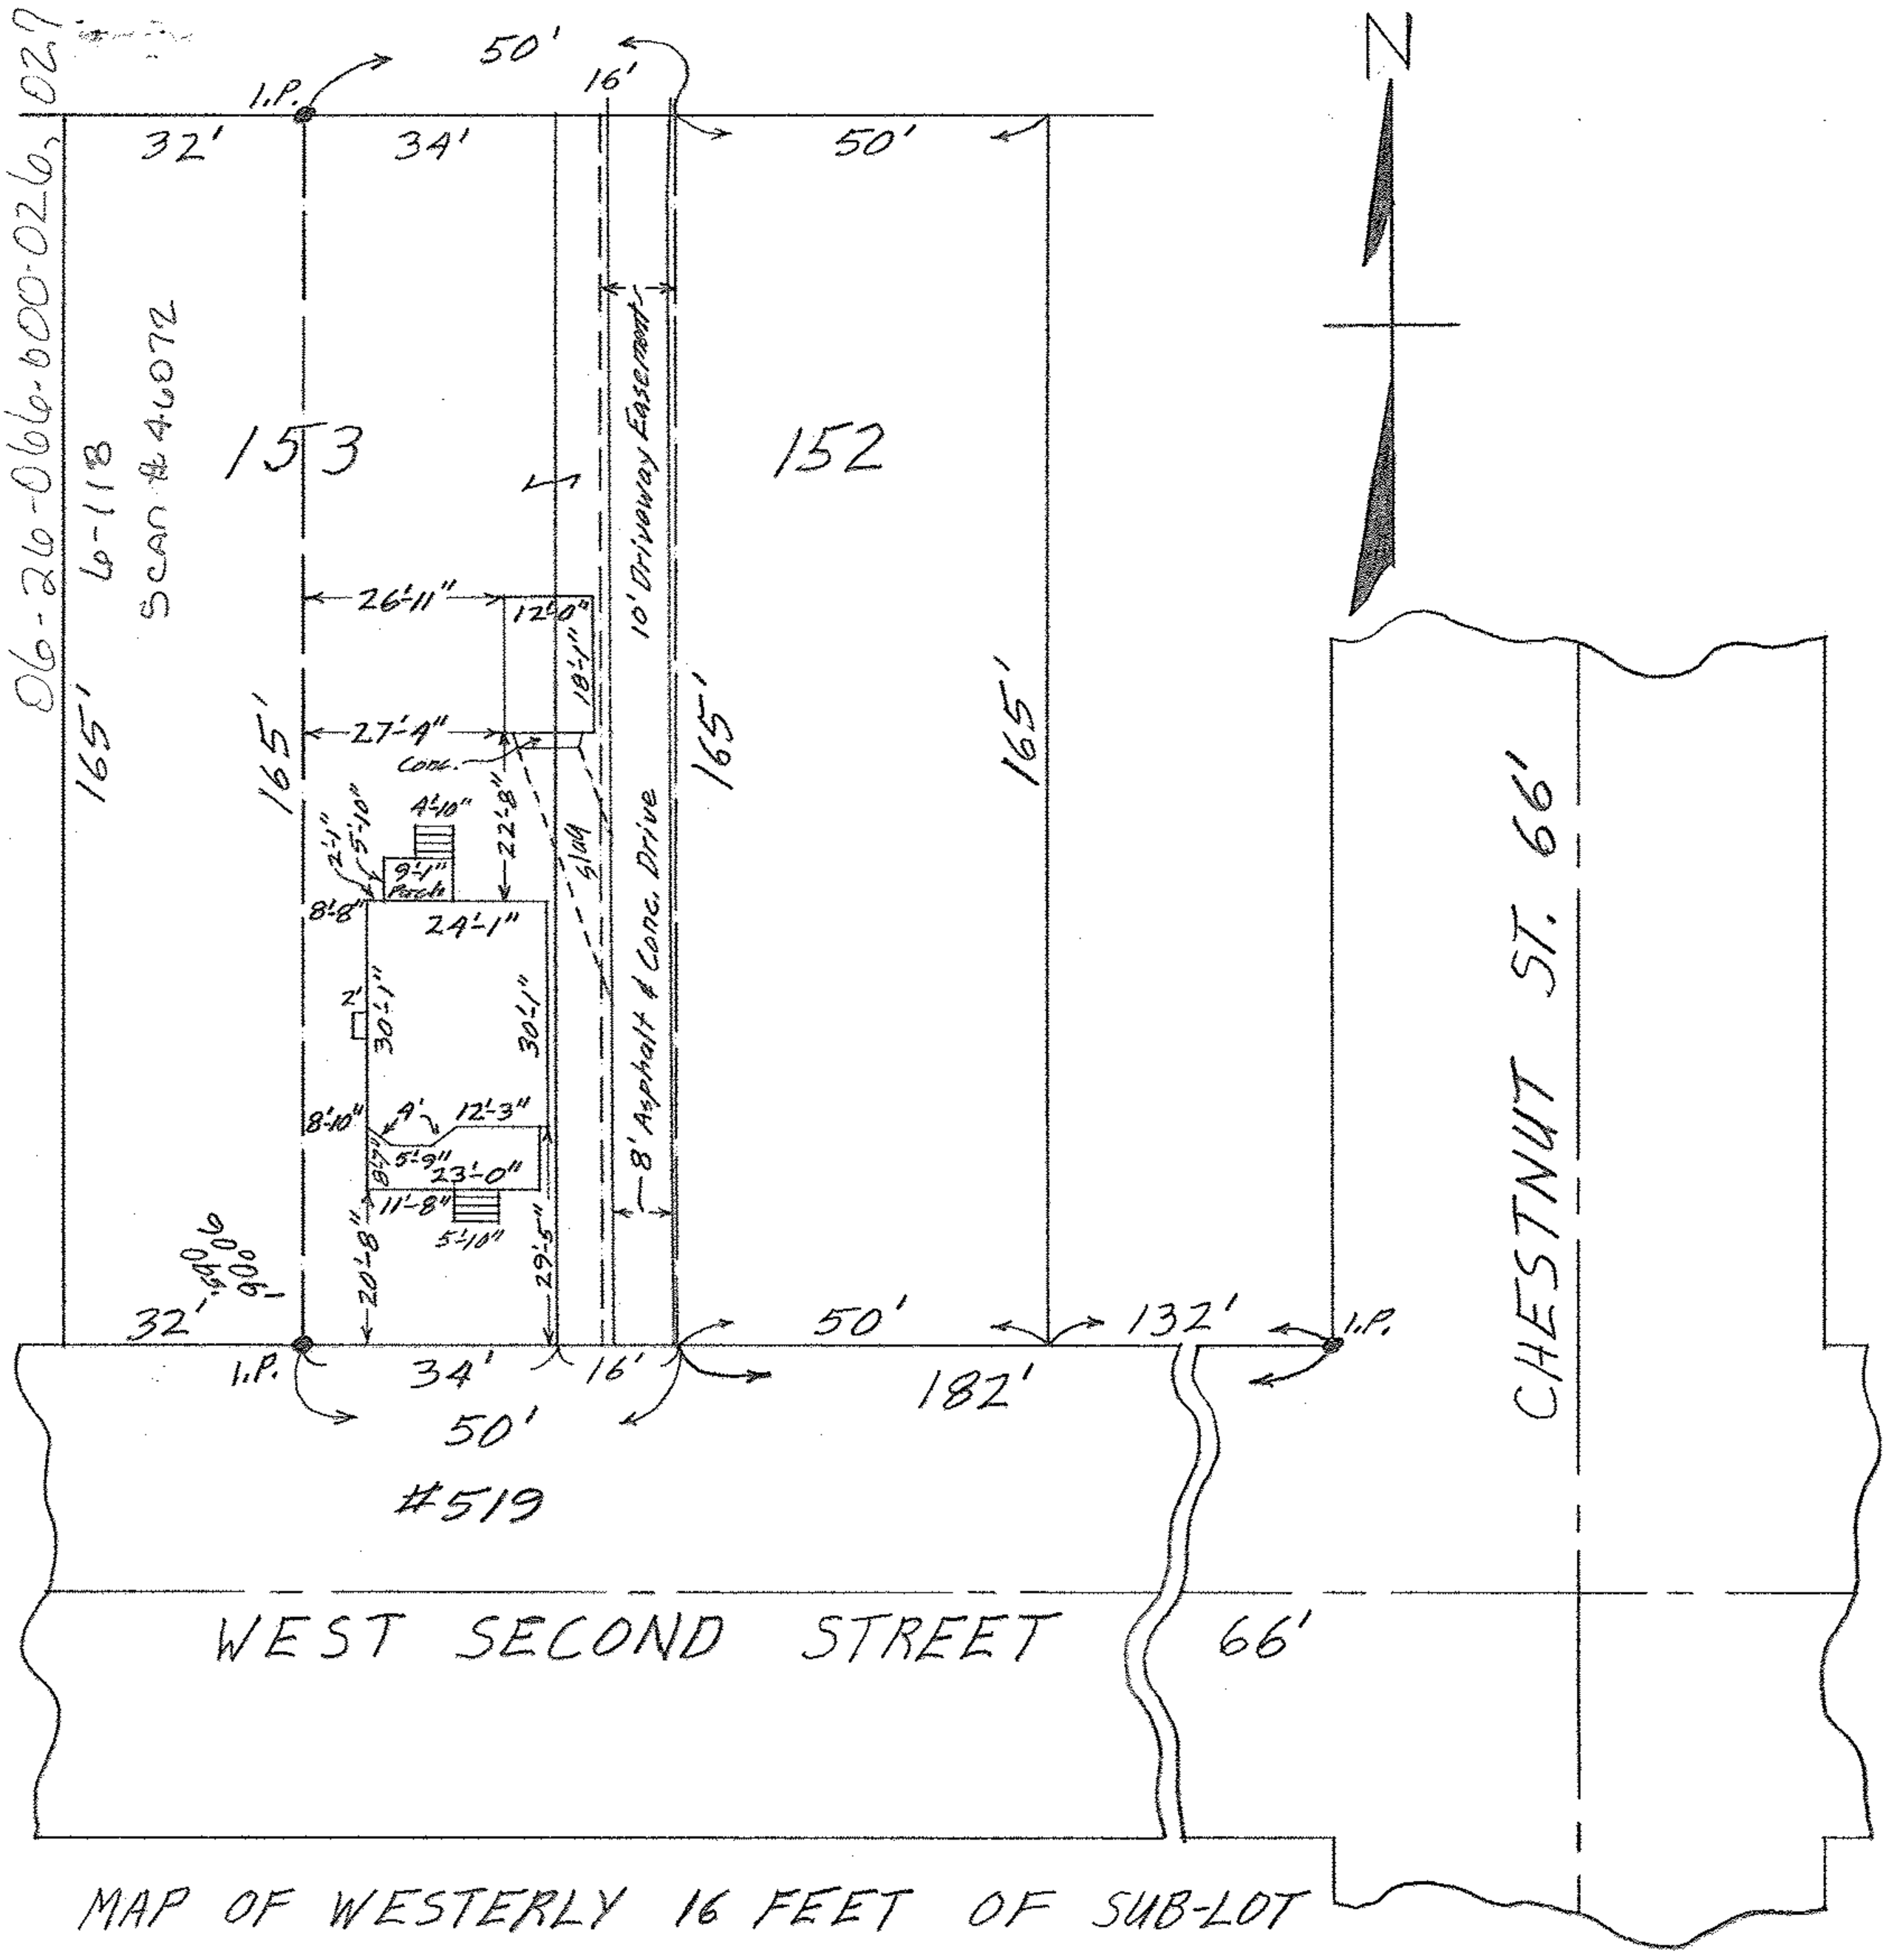

MAP OF WESTERLY 16 FEET OF SUB-LOT
152 AND EASTERLY 34 FEET OF SUB-LOT 153
HEMAN ELY'S ORIGINAL PLAT VOL. 3 PG. 14
ELYRIA CITY LORAIN COUNTY OHIO
SCALE: 1"=30' MAR. 23-1964 12:30 P.M.
Gary E. Penfound REG. SURVEYOR
Denver Lee Legg & Charlotte Legg WW