NOTE: Southeast Line of property at 90° with Southwest Line of LODI ST.

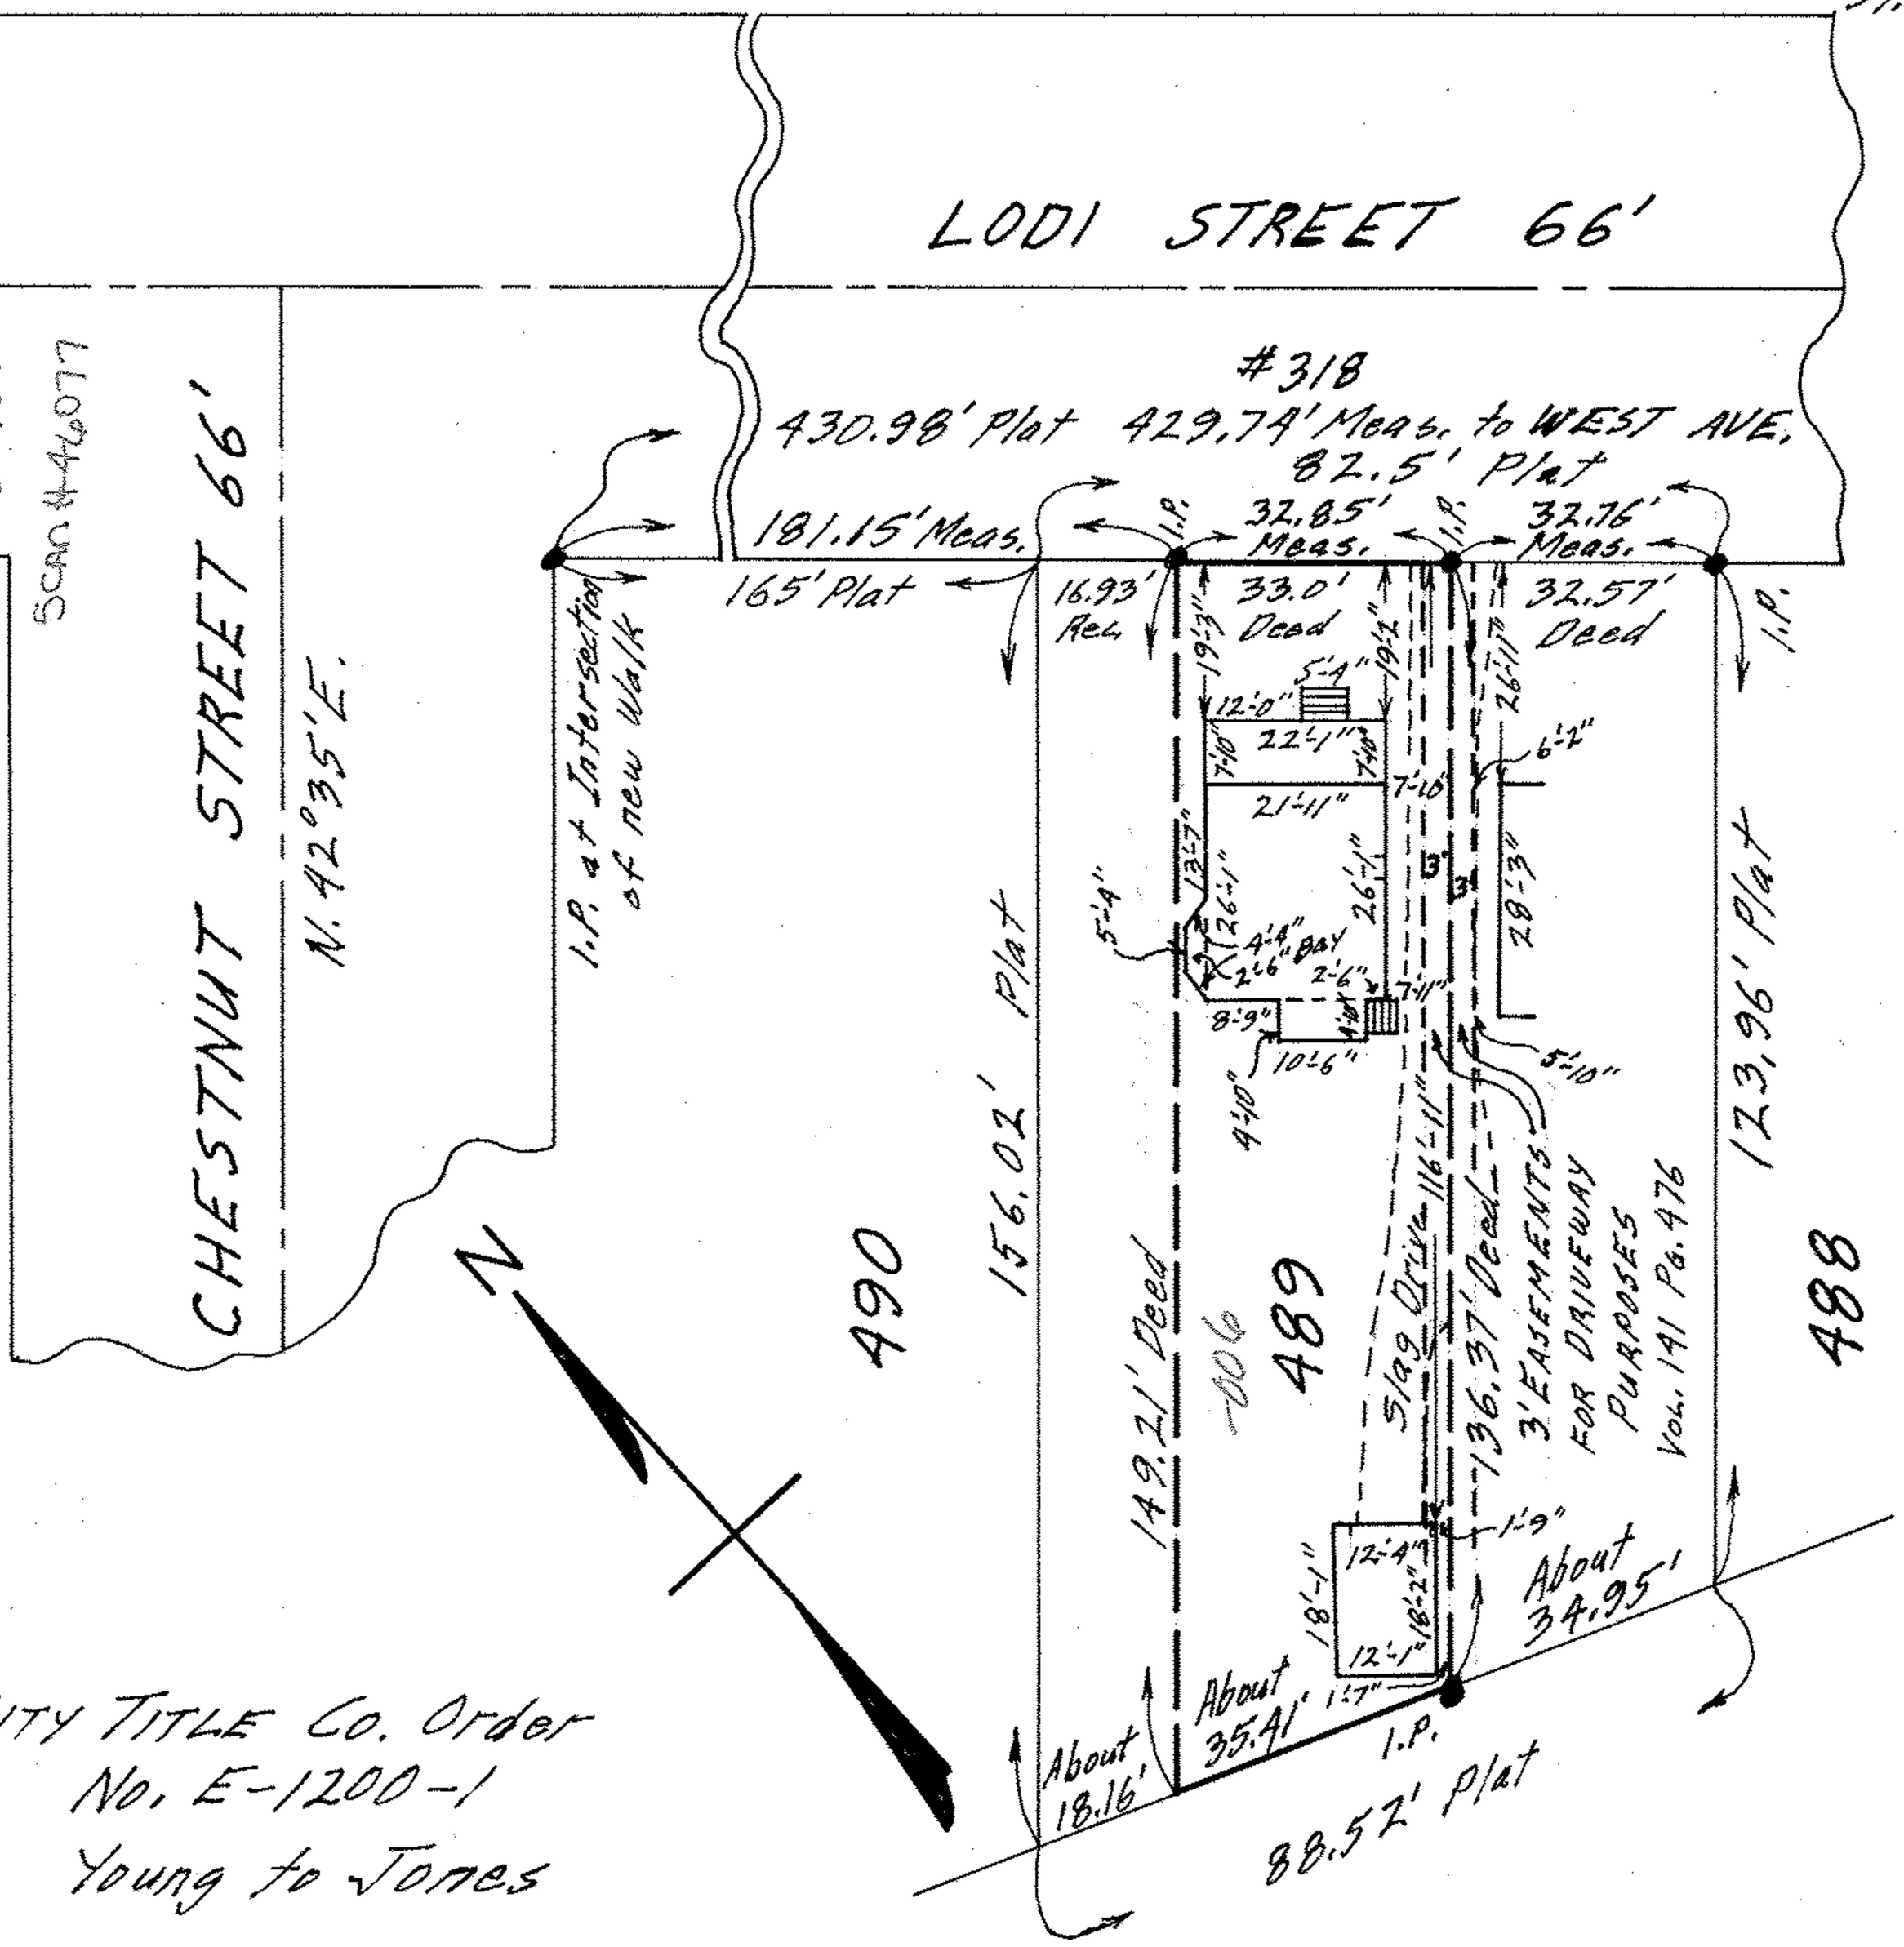

CITY TITLE CO. Order
No. E-1200-1
Young to Jones

MAP OF 33 FEET OF SUB-LOT 489 OF BLOCK 92
OF CHARLES A. ELY'S ADD'N. VOL. 1 PG. 21 PLATS
ORIG. LOT 92 - BETWEEN THE BRANCHES OF BLACK RIVER
ELYRIA TWP. - ELYRIA CITY - LORAIN COUNTY - OHIO
SCALE: 1" = 30' JULY 19 - 1970 8:30 P.M.
NOTE: There are no encroachments on this property,
but Common Drive situation exists.
Gary E. Penfound REG. SURVEYOR NO. 4957