SURVEY FOR
WM. AND VIRGINIA SEIBERT
D-VOL 861 PG 458 NOV 14, 1963
SUB LOTS 6-7 C. PARSH ADDN
MAP VOL 4 PG 39
SCALE 1" = 10' FEB 9, 1966
D. D. ANDRUS AND ASSOCIATES
REG SURVEYORS

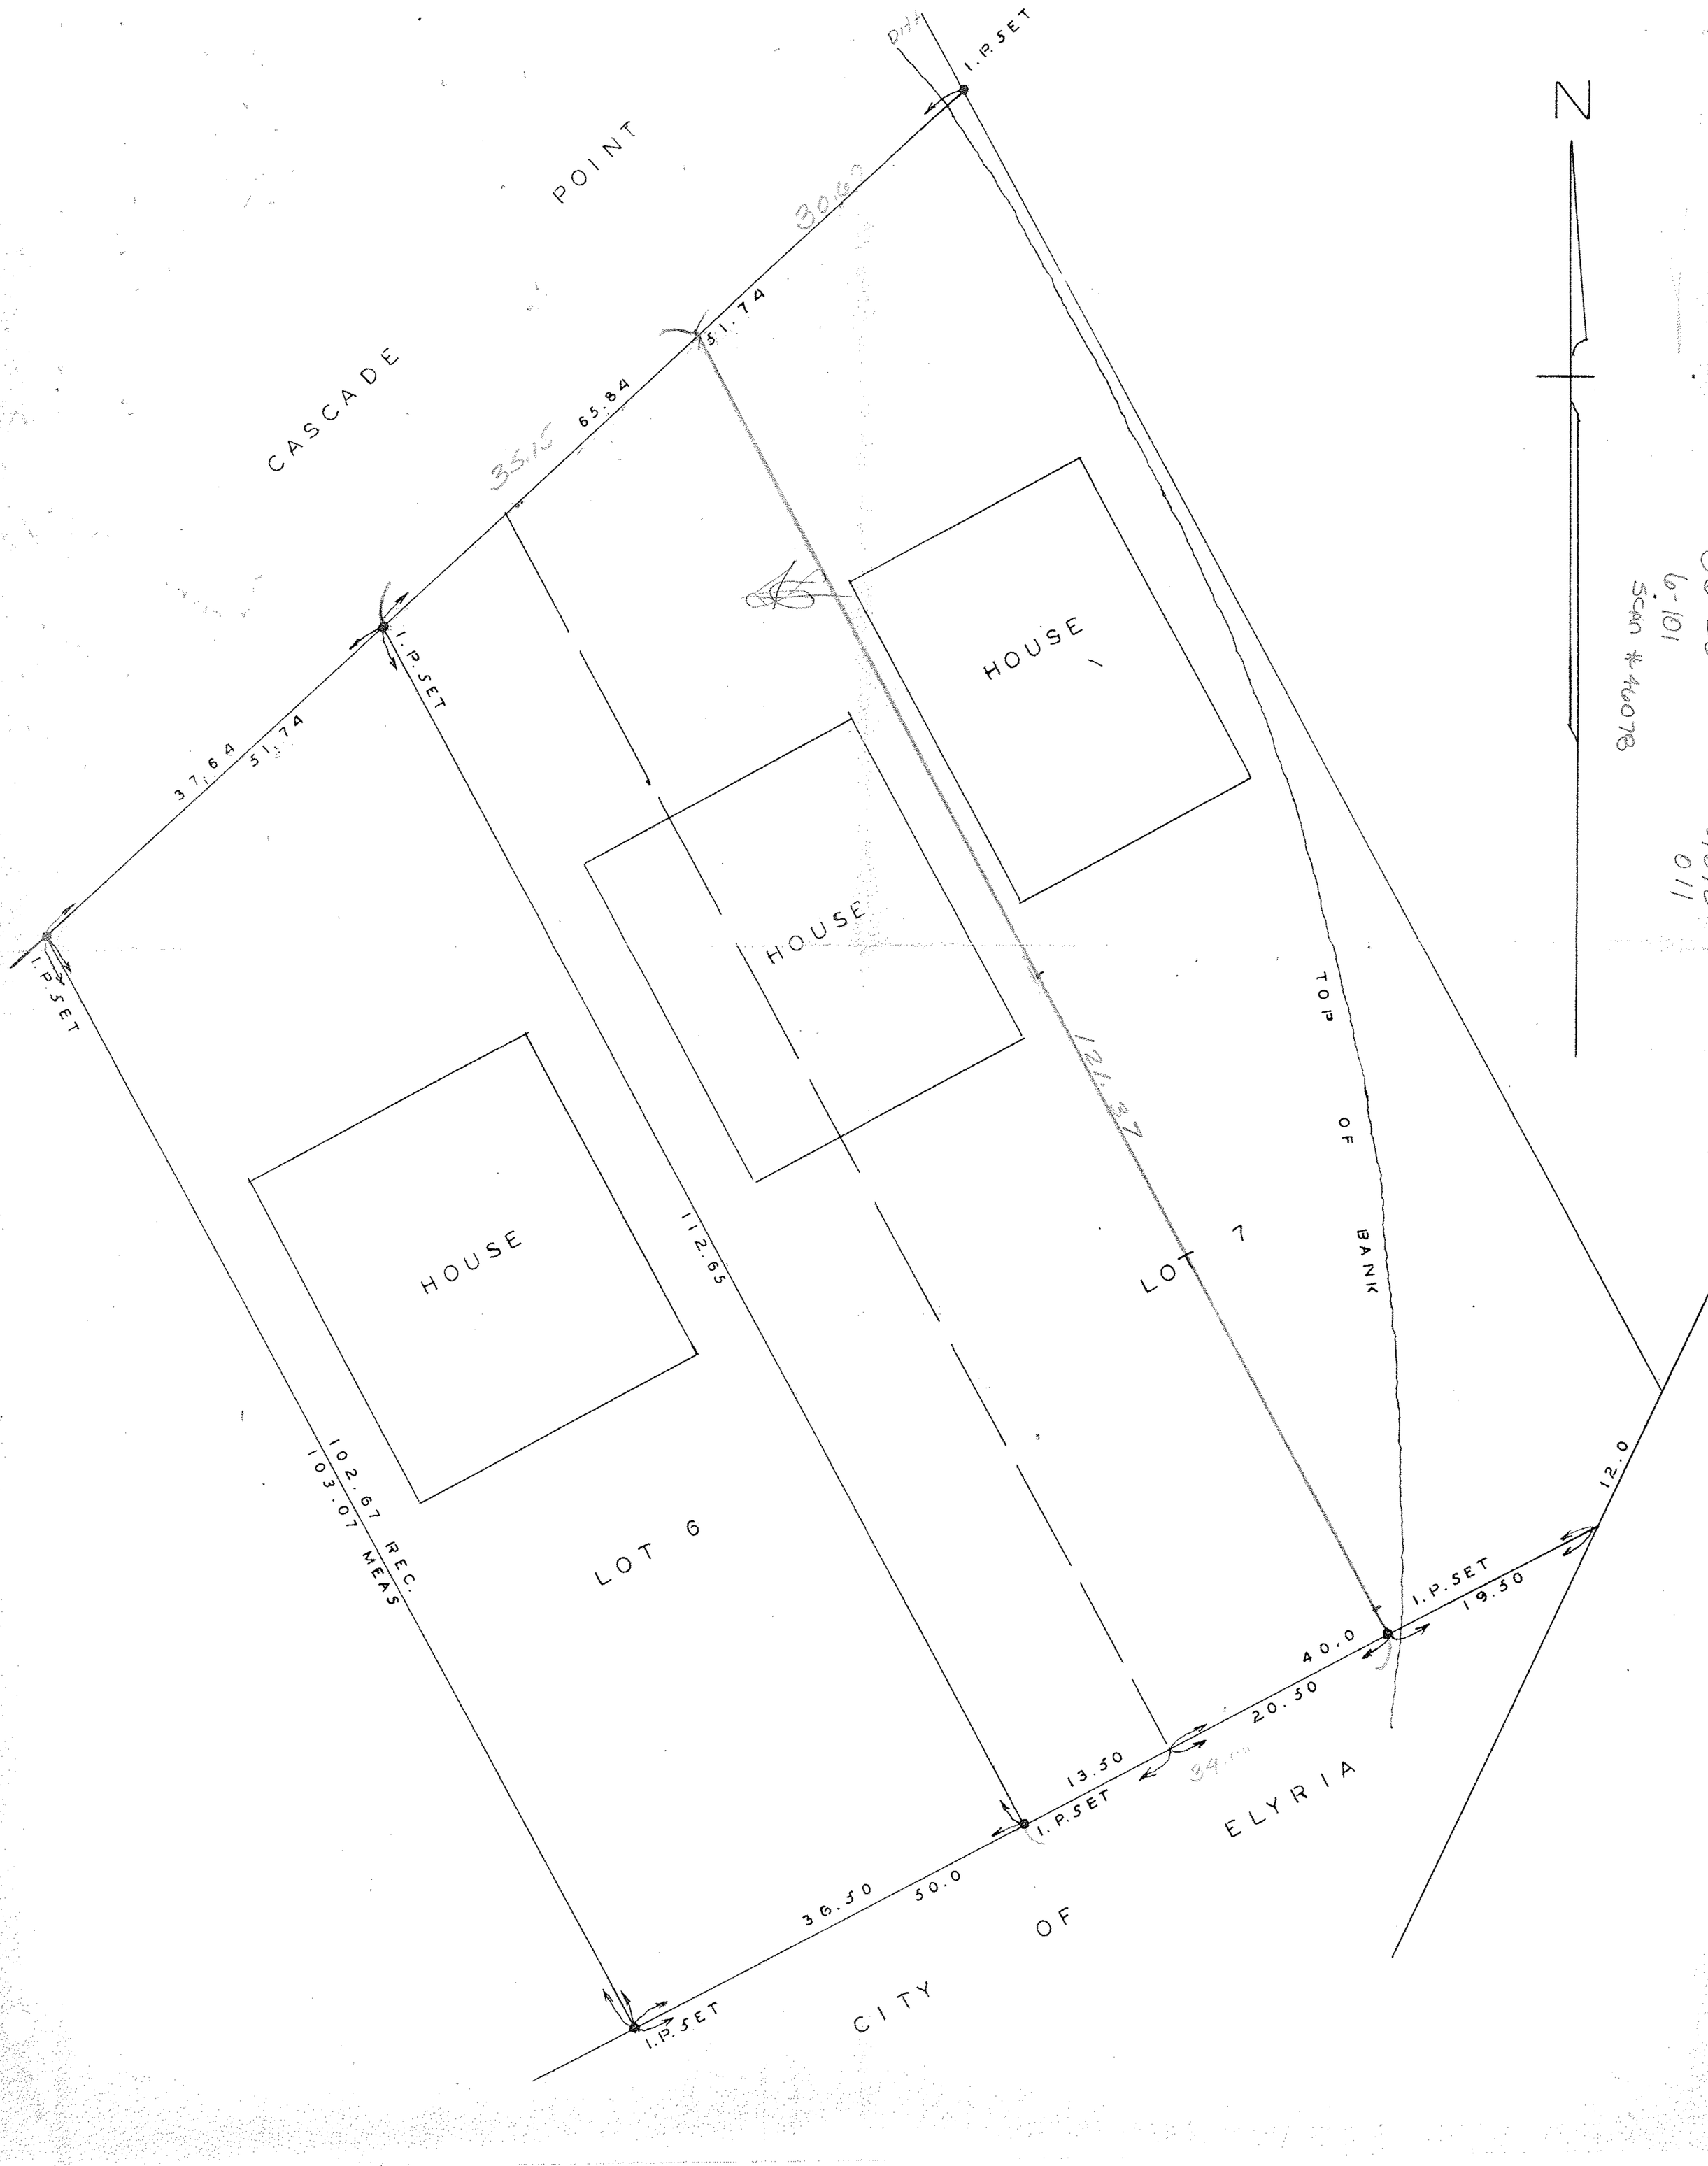

06-26-094-102.008,040
6-101
scan # 40078
011