06-26-094-103-009, 010, 011

6-101

SCAN#46079

CITY TITLE CO.

Order No. E-774-5

Lester & Mildred E. Piatt

to Alfred F. & Wanda Tyree

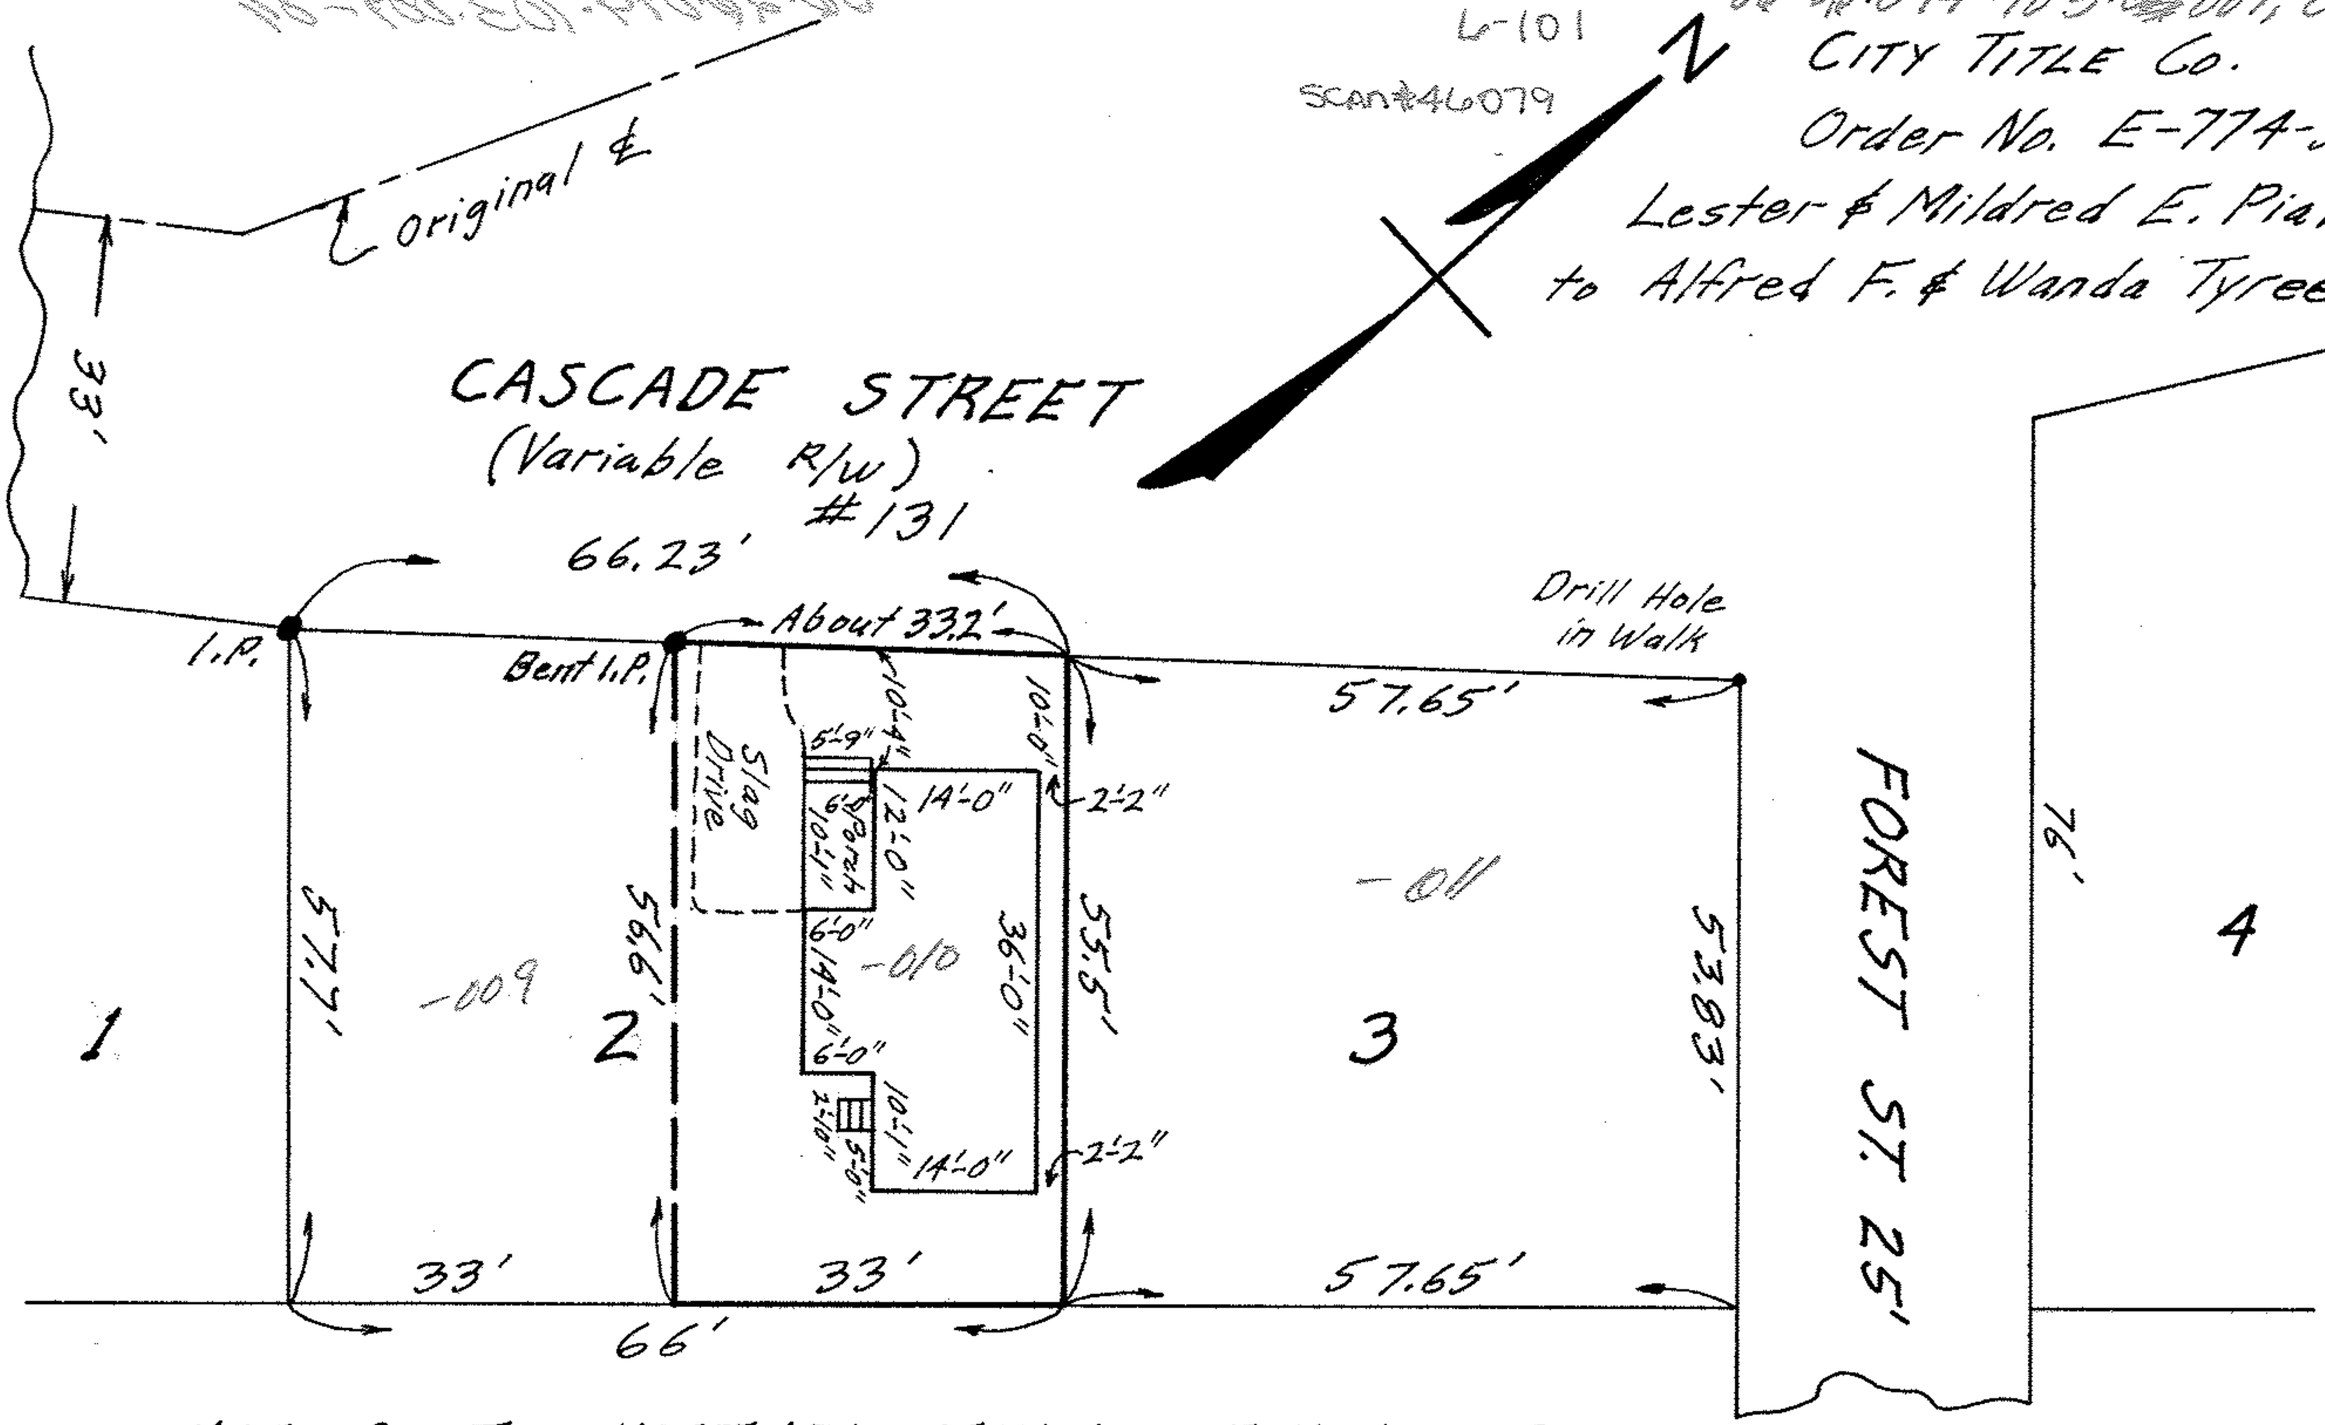

MAP OF THE NORTHEASTERLY ONE-HALF OF SUB-LOT NO. 2

OF THE C. PARSCH SUB'N. VOL. 4 PG. 39 PLATS

ELYRIA TWP. - ELYRIA CITY - LORAIN COUNTY - OHIO

SCALE: 1"=20' AUG. 12 - 1969 2:00 P.M.

NOTE: There are no encroachments on the above property.

Gary E. Penfound REG. SURVEYOR NO. 4457