


03-00-113-103
03-00-113-A
Scan # 46083

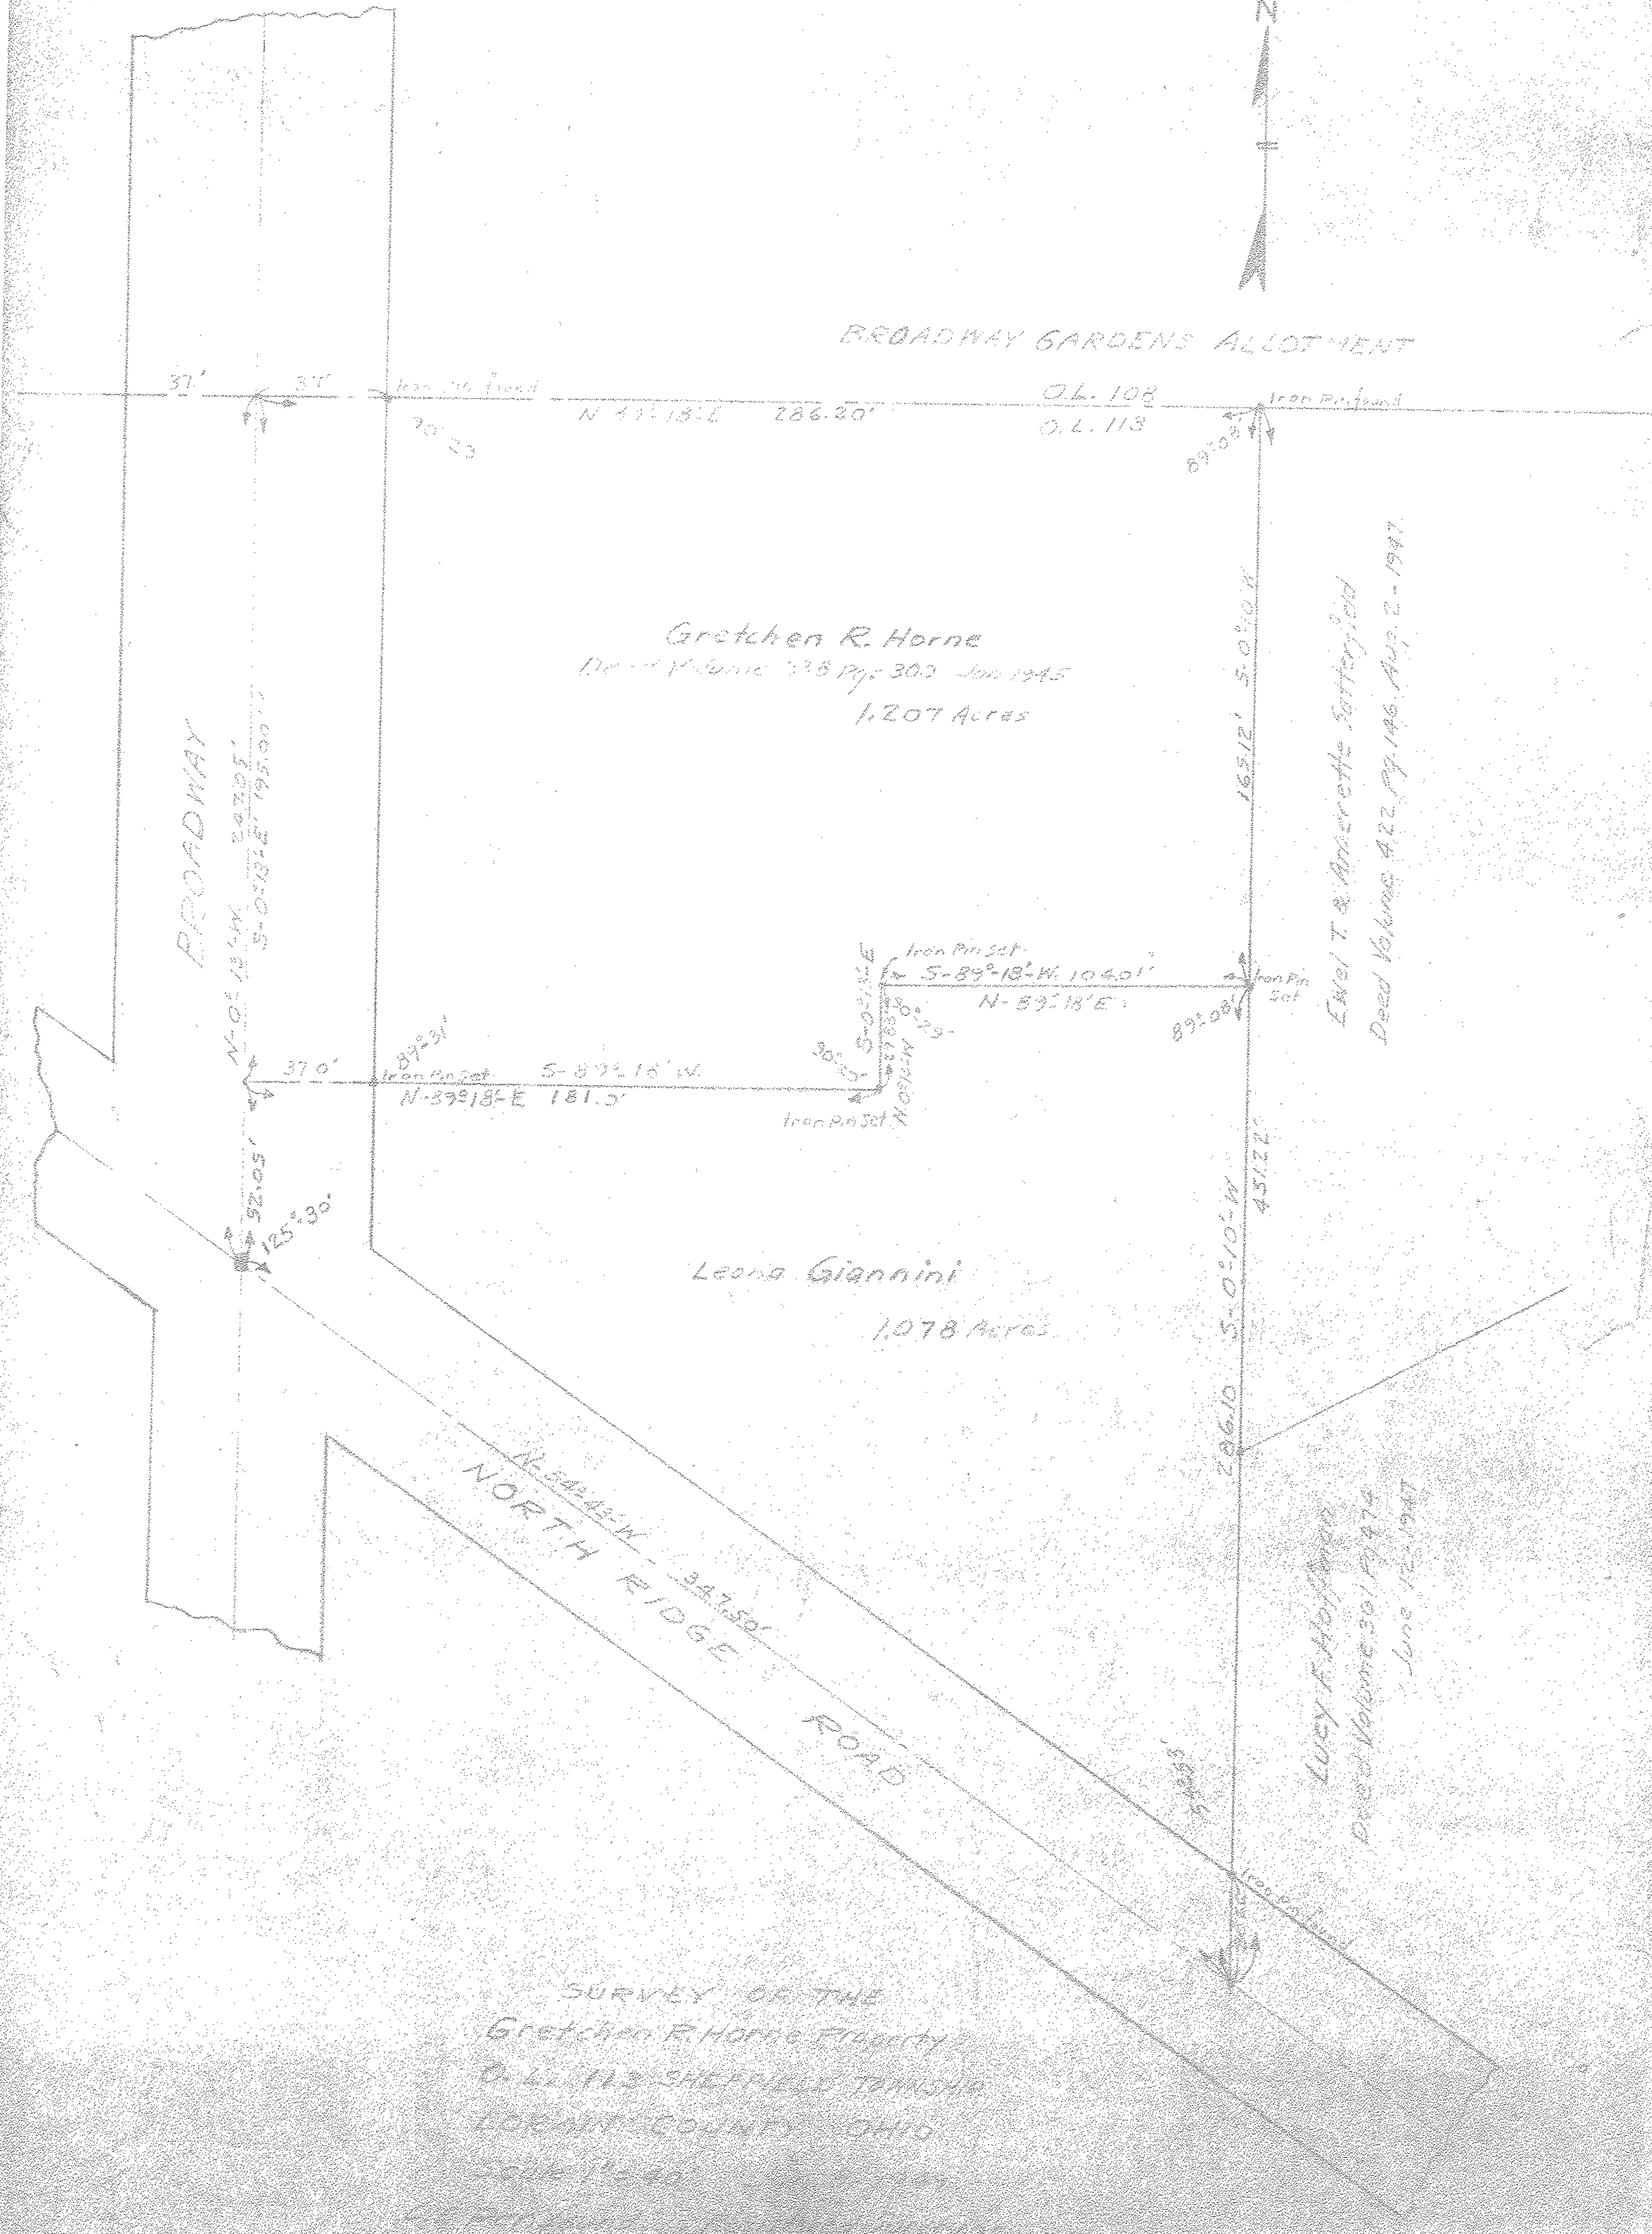

BROADWAY GARDENS ALLOTMENT



Gretchen R. Horne
Deed Volume 335 Pg. 303 Jan 1945
1.207 Acres

Emel T. & Annette Satterfield
Deed Volume 422 Pg. 146 Aug. 2 - 1947

Leona Giannini
1.078 Acres

Lucy F. Hoffmann
Deed Volume 301 Pg. 474
June 12, 1947

SURVEY OF THE
Gretchen R. Horne Property
Scale 1/2" = 100'