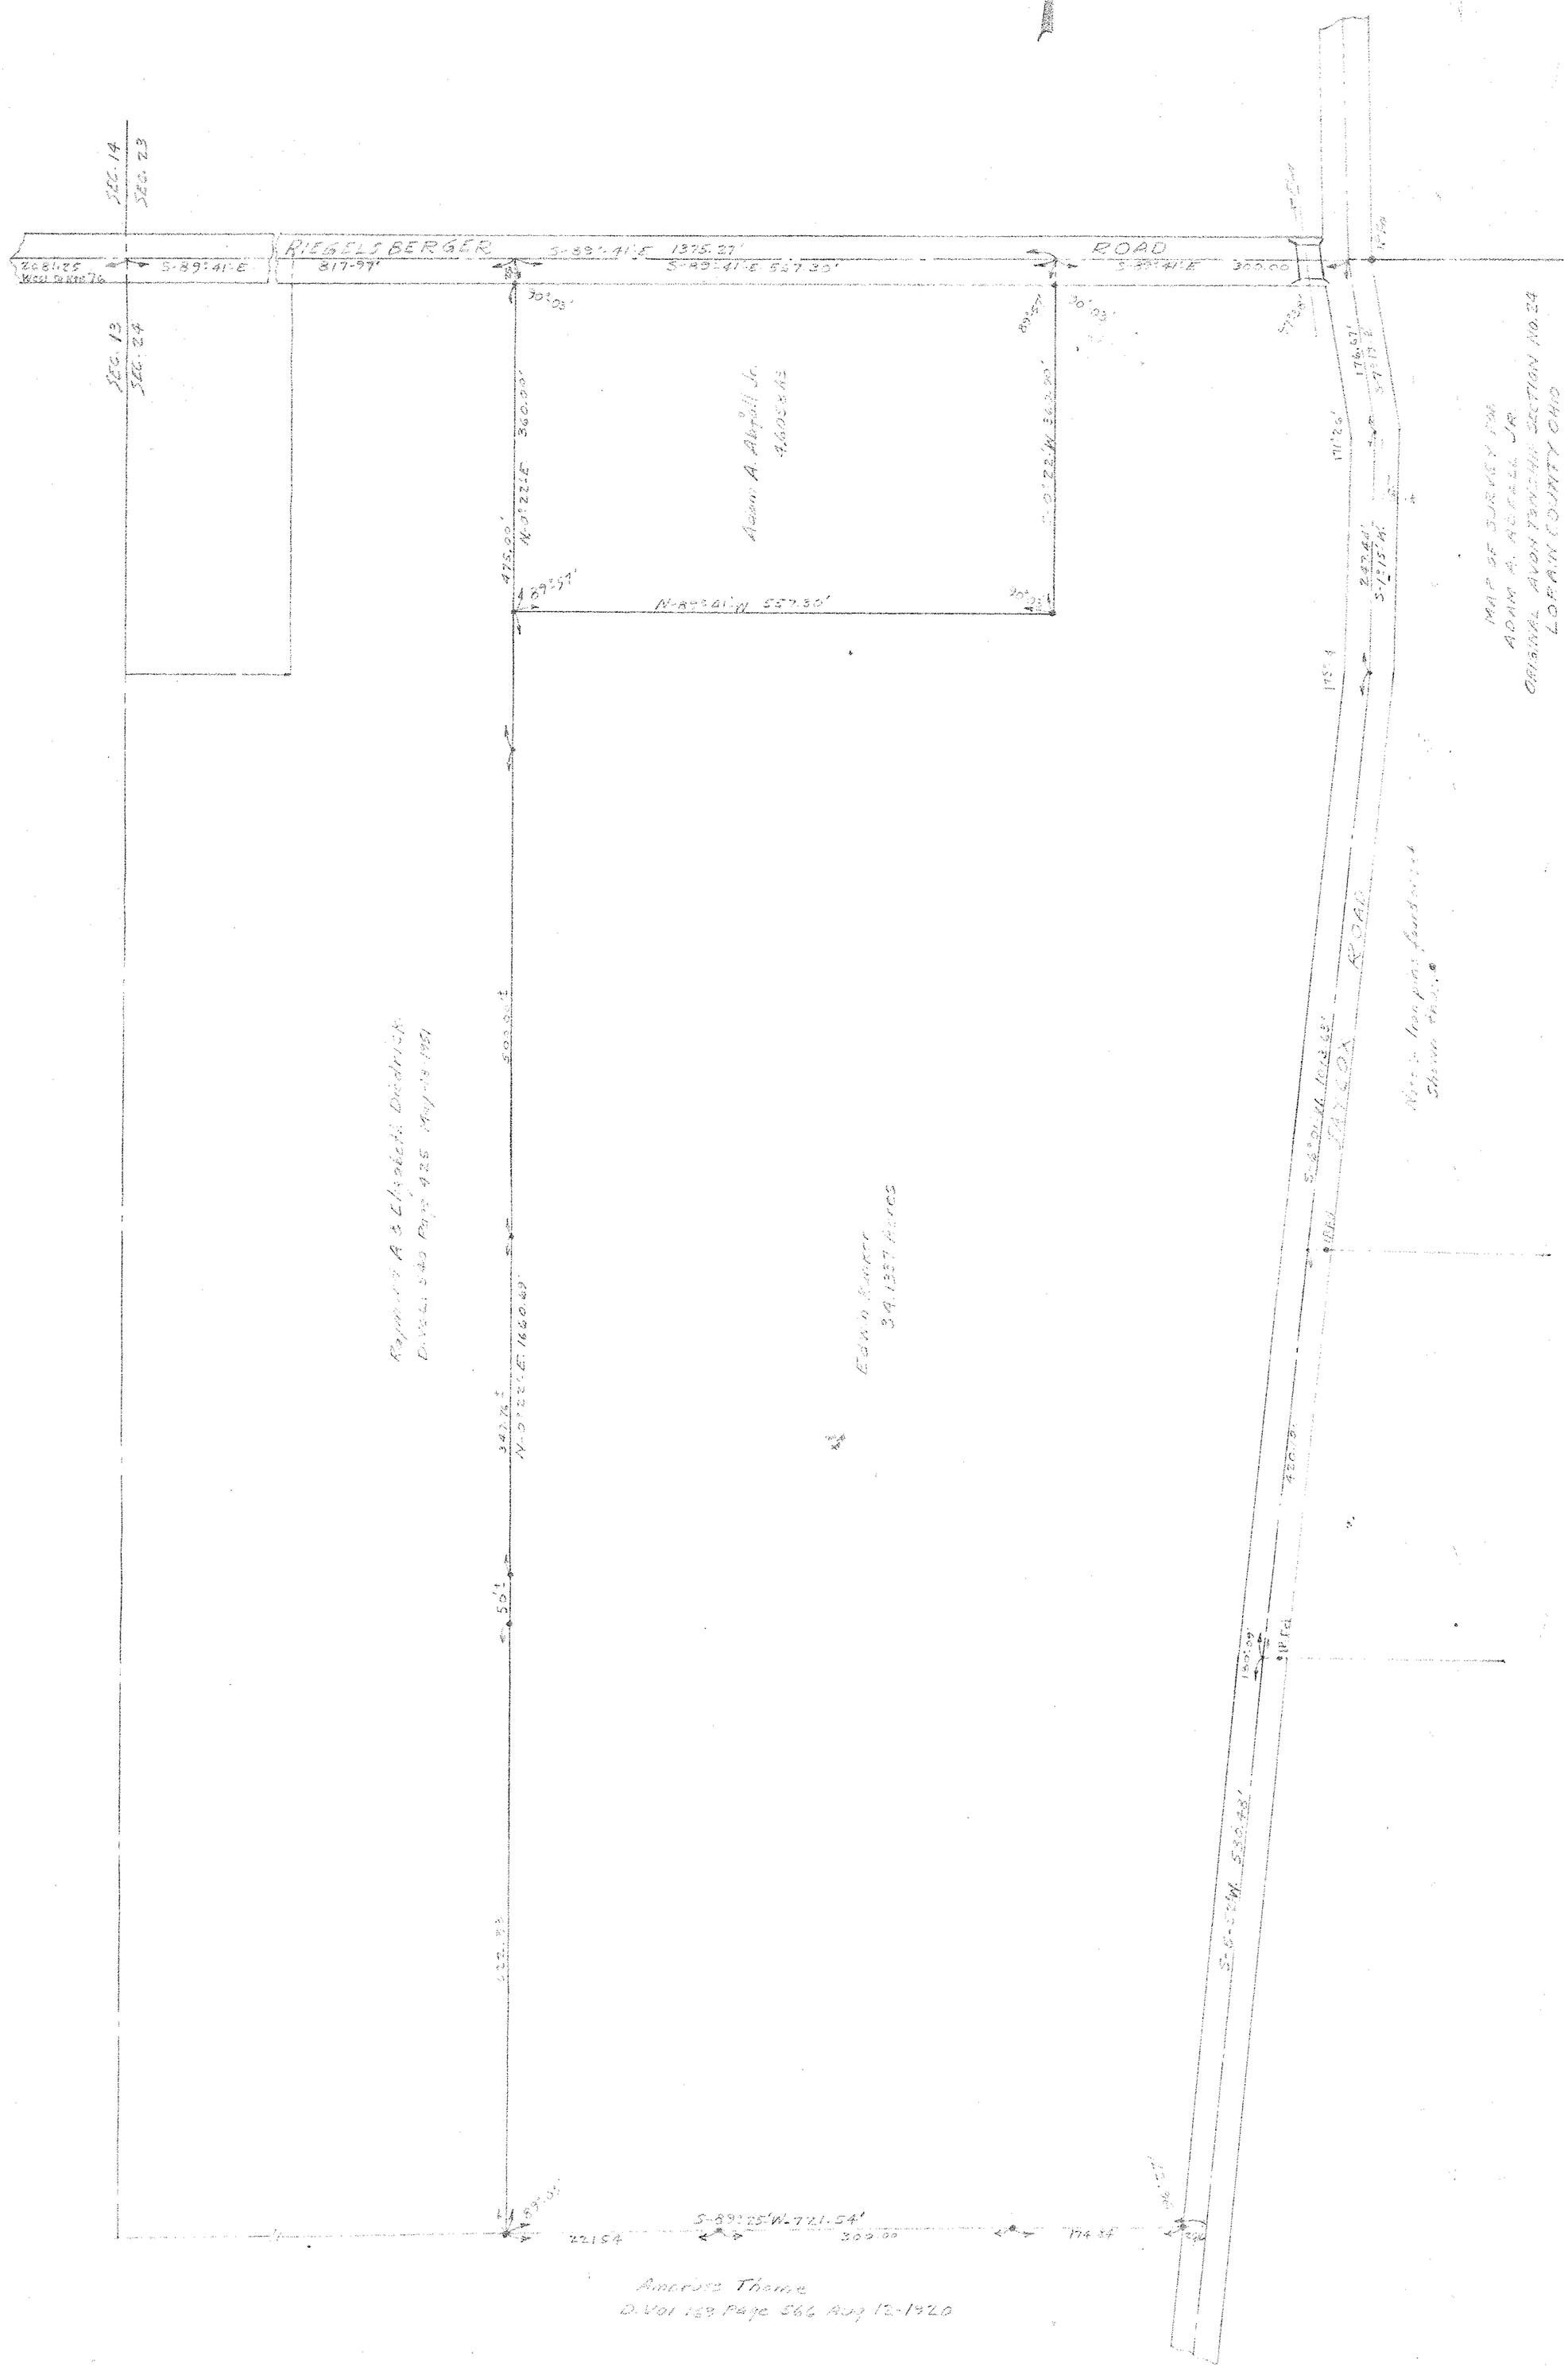04-00-024-101
04-00-024-B
Scan #46094