16098

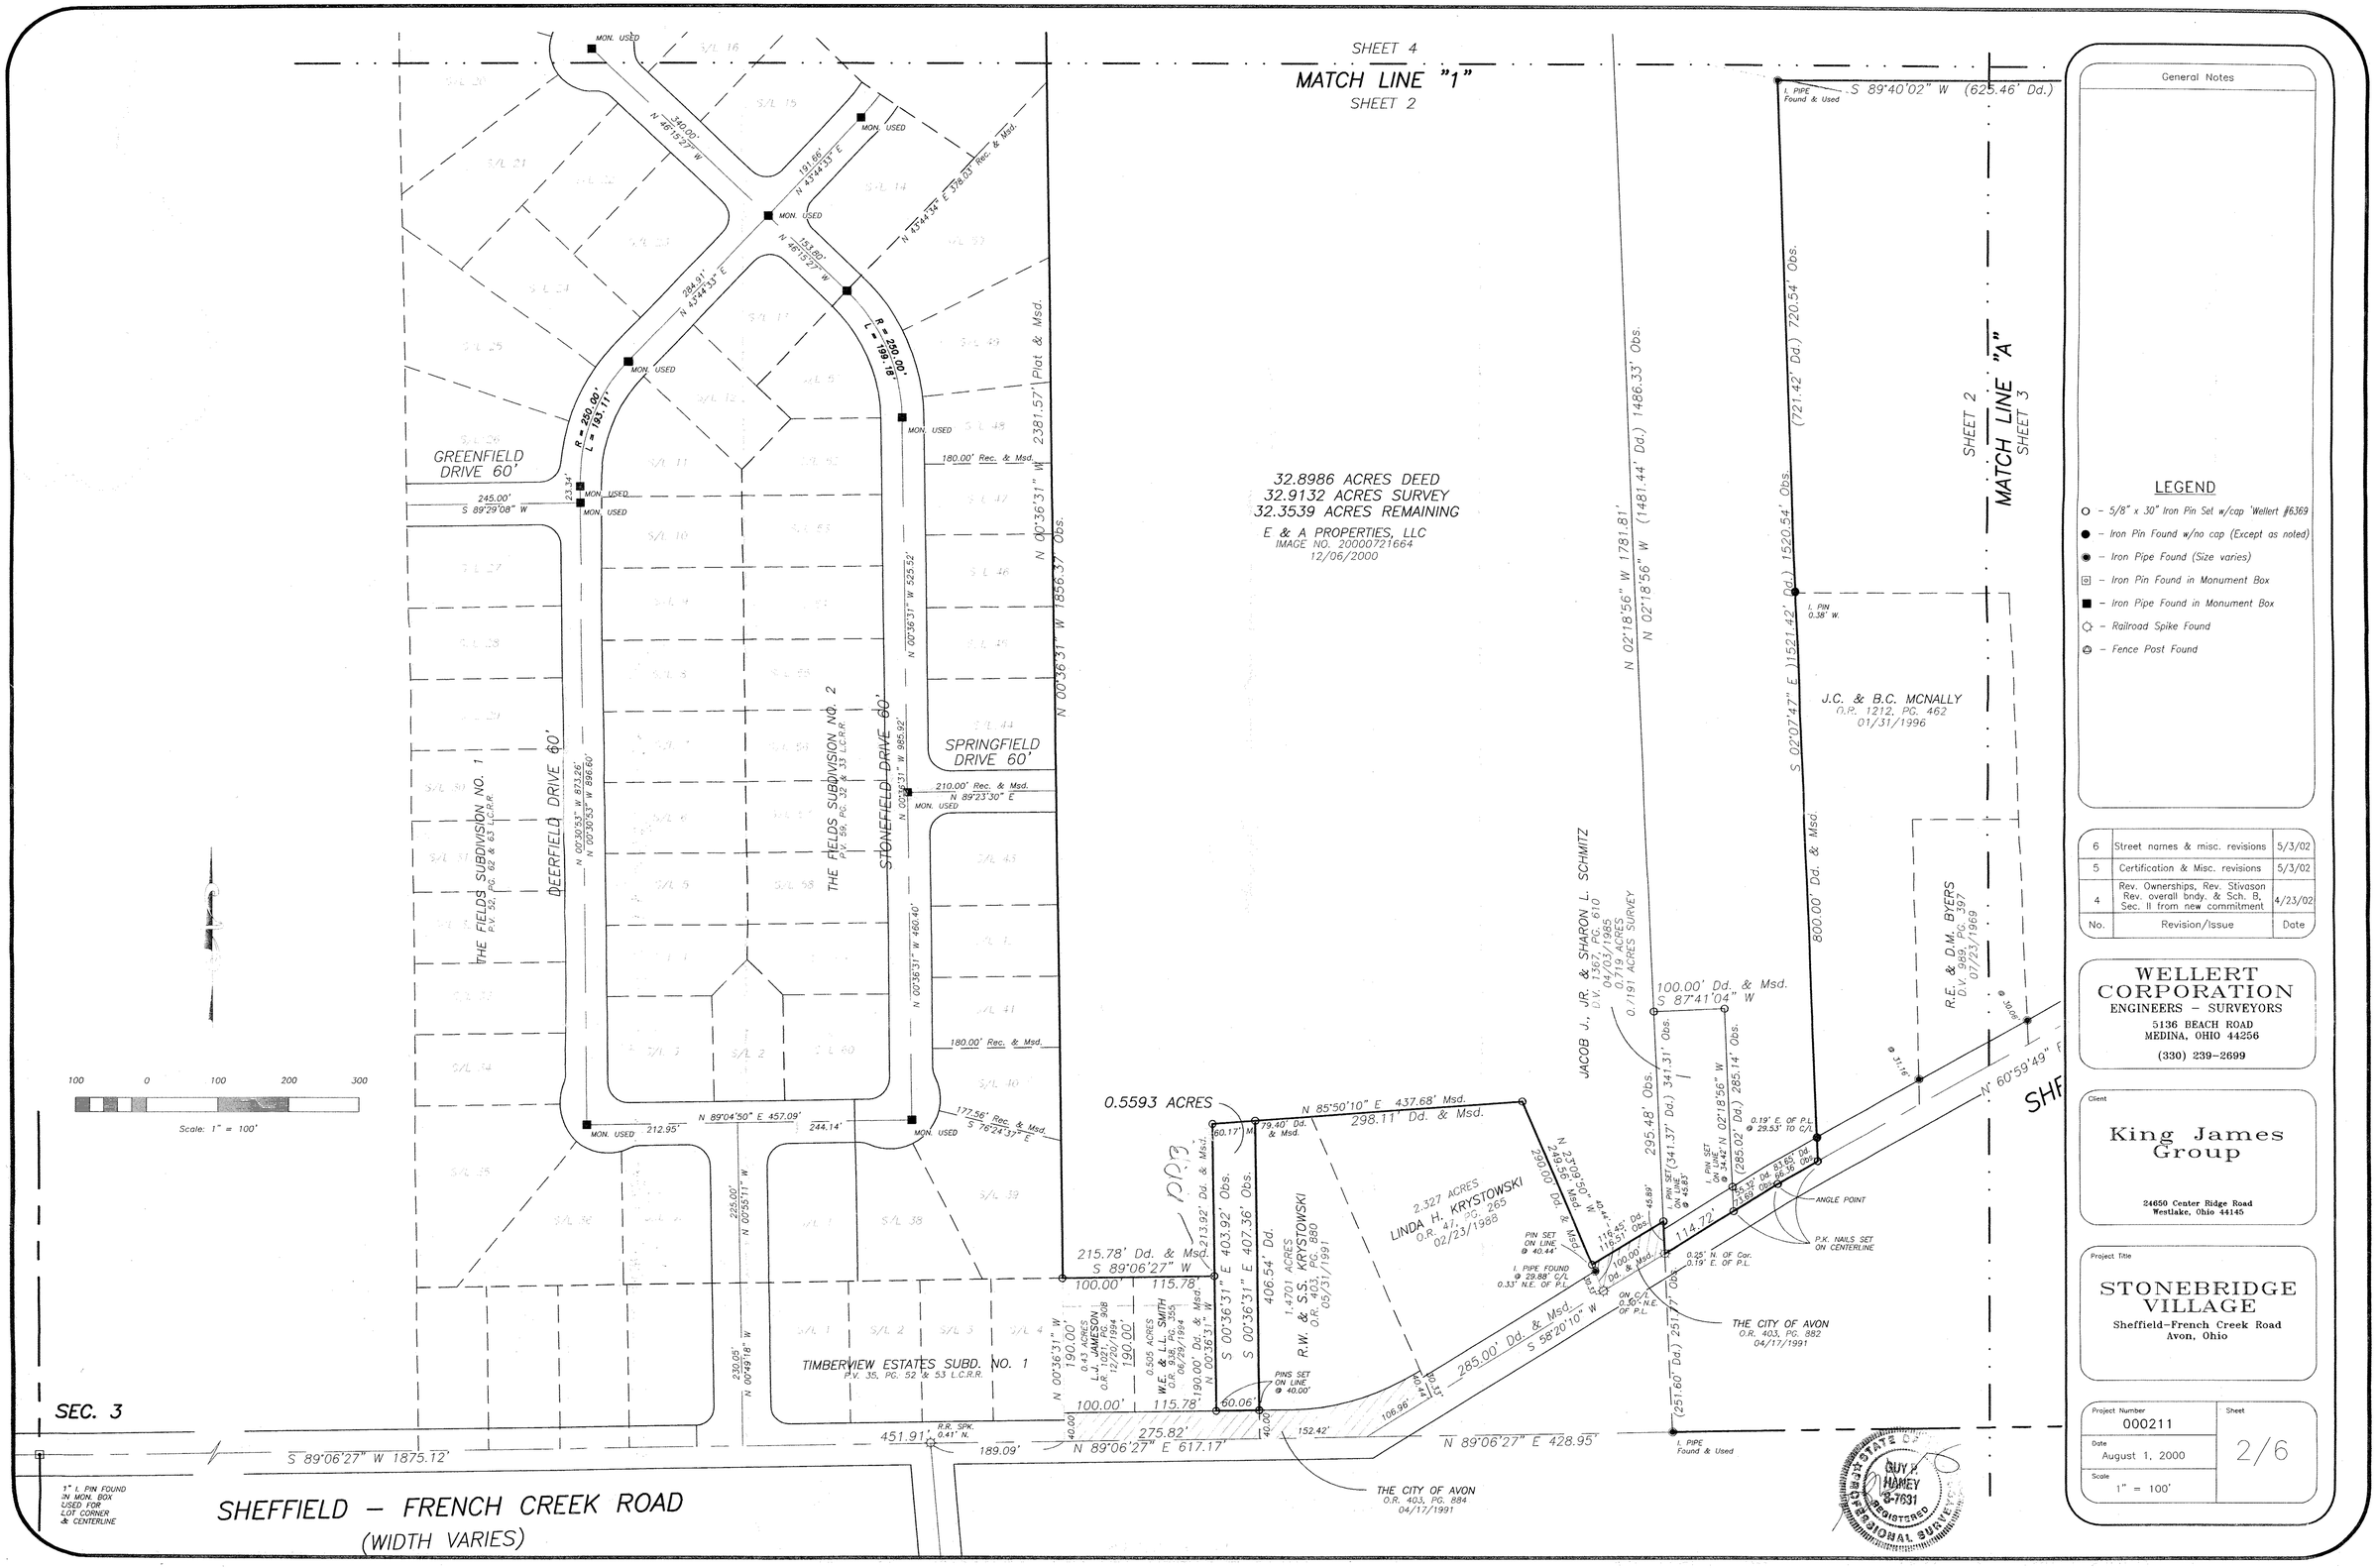

General Notes

LEGEND

- ○ – 5/8" x 30" Iron Pin Set w/cap 'Wellert #6369
- ● – Iron Pin Found w/no cap (Except as noted)
- ◉ – Iron Pipe Found (Size varies)
- ⊡ – Iron Pin Found in Monument Box
- ■ – Iron Pipe Found in Monument Box
- ◌ – Railroad Spike Found
- ⊗ – Fence Post Found

No.	Revision/Issue	Date
6	Street names & misc. revisions	5/3/02
5	Certification & Misc. revisions	5/3/02
4	Rev. Ownerships, Rev. Stivason Rev. overall bndy. & Sch. B, Sec. II from new commitment	4/23/02

WELLERT CORPORATION
ENGINEERS – SURVEYORS
5136 BEACH ROAD
MEDINA, OHIO 44256
(330) 239-2699

Client
King James Group
24650 Center Ridge Road
Westlake, Ohio 44145

Project Title
STONEBRIDGE VILLAGE
Sheffield-French Creek Road
Avon, Ohio

Project Number: 000211
Date: August 1, 2000
Scale: 1" = 100'
Sheet: 2/6

K:\PROJECTS\SURVEYS\KJ_AVON\gpz_7_19\Re-_04_02.dwg, 03/07/02 09:17:41 AM